

**This electronic collection of documents is provided  
for the convenience of the user  
and is Not a Certified Document –**


**The documents contained herein were originally issued  
and sealed by the individuals whose names and license  
numbers appear on each page, on the dates appearing  
with their signature on that page.**

**This file or an individual page  
shall not be considered a certified document.**

2/7/2018 8:04:57 AM  
R:\Roadway\Proj\1570051\_r.dgn  
jor+66165

TIP PROJECT: 17BP.7.R.94

CONTRACT:

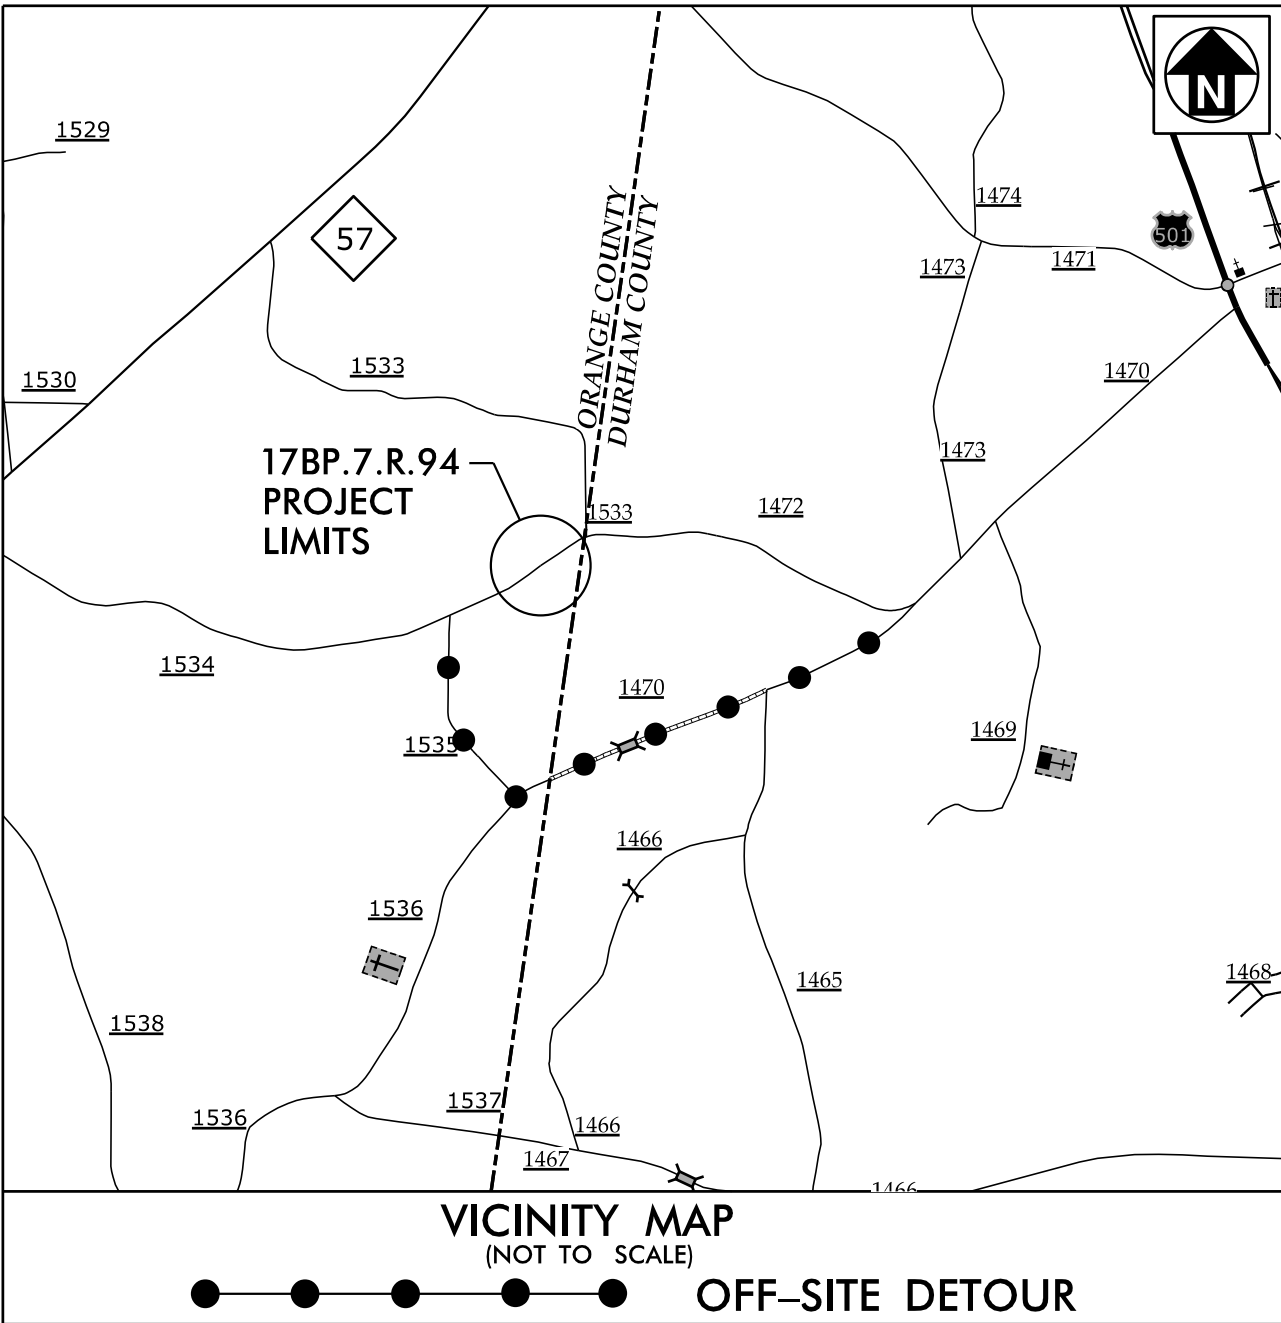


STATE OF NORTH CAROLINA  
DIVISION OF HIGHWAYS  
**ORANGE COUNTY**


LOCATION: BRIDGE NO. 51 OVER BUFFALO CREEK ON SR 1534 (MCKEE ROAD)

TYPE OF WORK: GRADING, PAVING, DRAINAGE AND STRUCTURE

STATE	STATE PROJECT REFERENCE NO.	SHEET NO.	TOTAL SHEETS
N.C.	17BP.7.R.94	1	
STATE PROJECT NO.	F.A. PROJ. NO.	DESCRIPTION	

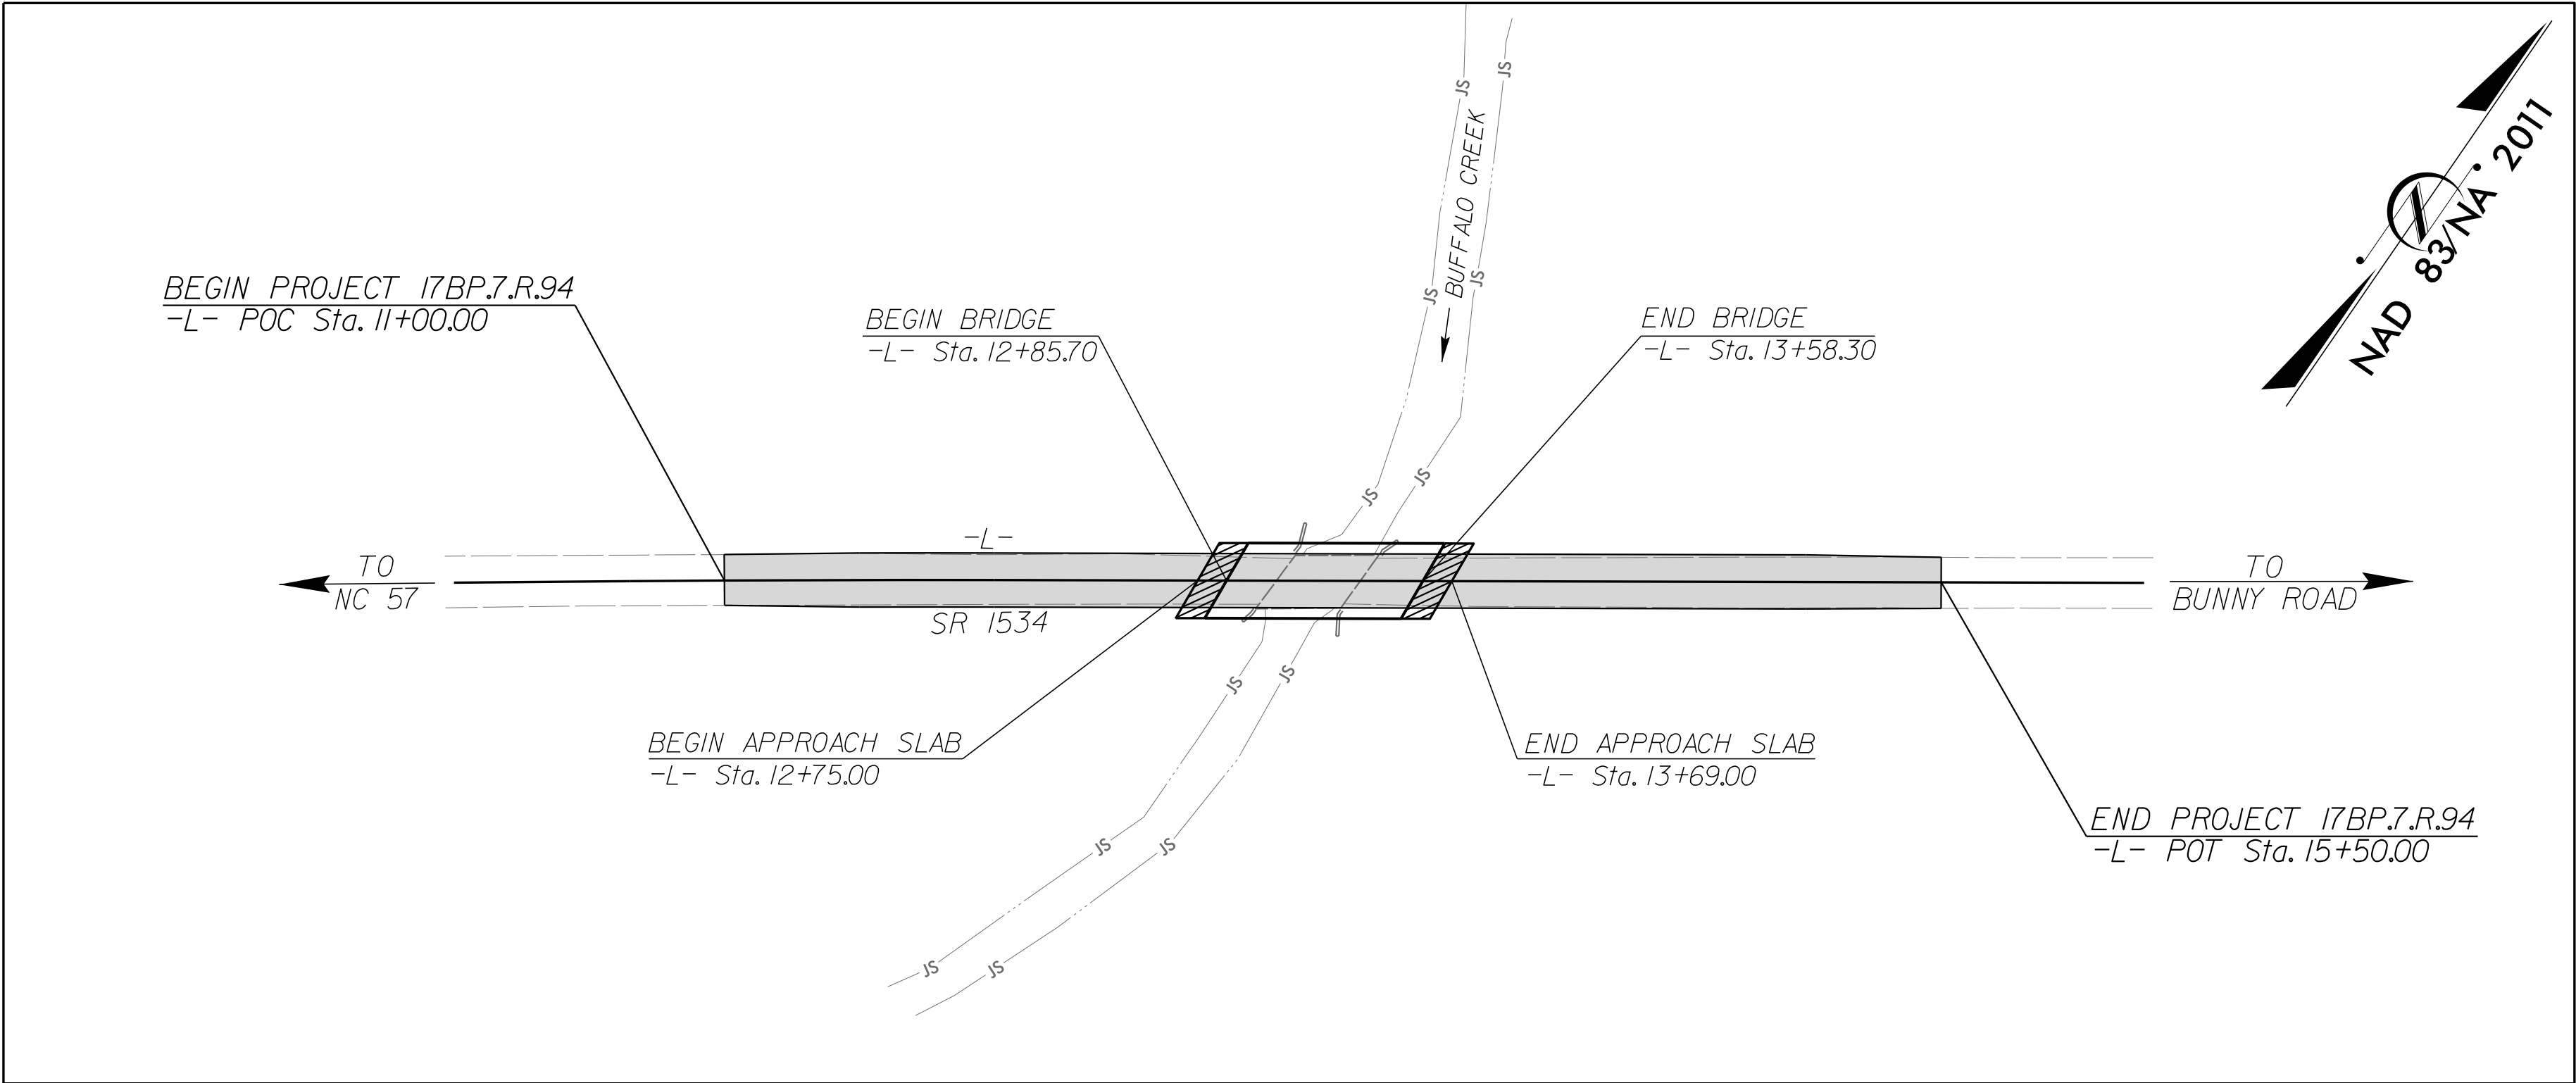

DOCUMENT NOT CONSIDERED FINAL  
UNLESS ALL SIGNATURES COMPLETED

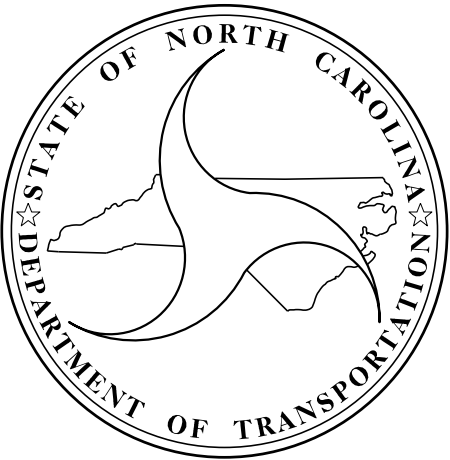

DESIGN DATA

ADT 2012 = 330

ADT 2025 = 660

V = 45 MPH

SUB REGIONAL TIER  
LOCAL

PROJECT LENGTH

LENGTH ROADWAY TIP PROJECT = 0.071 MILES

LENGTH STRUCTURE TIP PROJECT = 0.014 MILES

TOTAL LENGTH TIP PROJECT = 0.085 MILES

Prepared In the Office of Mott MacDonald for

DIVISION 7

NORTH CAROLINA DEPARTMENT OF TRANSPORTATION

2018 STANDARD SPECIFICATIONS

LETTING DATE:


TIM JORDAN, PE  
PROJECT ENGINEER

JOSEPH W. DUNNEHOO, PE  
HYDRAULICS ENGINEER


NCDOT CONTACT:

TIM POWERS, PE  
DIVISION BRIDGE  
PROGRAM MANAGER

ROADWAY DESIGN ENGINEER

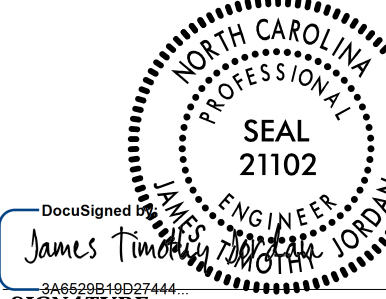

HYDRAULICS ENGINEER

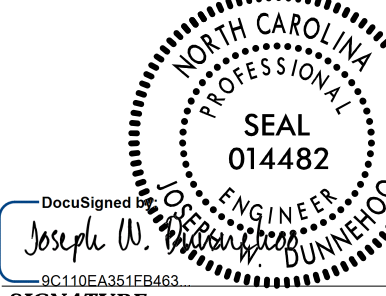

PLANS PREPARED BY:

M  
MOTT  
MACDONALD

PO Box 700  
Fuquay-Varina, NC 27526  
(919) 552-2253  
(919) 552-2254 (Fax)  
www.mottmac.com/americas

LICENSE NO. F-0669





*Note: Not to Scale*











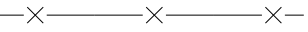
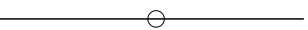
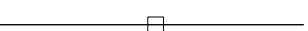

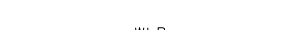


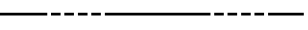


*\*S.U.E. = Subsurface Utility Engineering*

STATE OF NORTH CAROLINA  
DIVISION OF HIGHWAYS



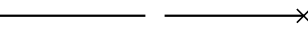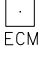



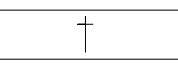
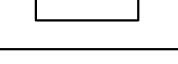
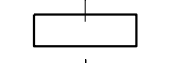
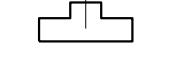

PROJECT REFERENCE	SHEET NO.
17BP.7.R.94 -- ORANGE 51	1B

CONVENTIONAL PLAN SHEET SYMBOLS


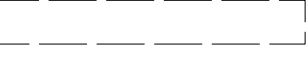

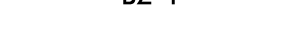





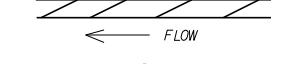
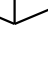
**BOUNDARIES AND PROPERTY:**

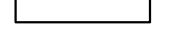State Line	
County Line	
Township Line	
City Line	
Reservation Line	
Property Line	
Existing Iron Pin	
Property Corner	
Property Monument	
Parcel/Sequence Number	
Existing Fence Line	
Proposed Woven Wire Fence	
Proposed Chain Link Fence	
Proposed Barbed Wire Fence	
Existing Wetland Boundary	
Proposed Wetland Boundary	
Existing Endangered Animal Boundary	
Existing Endangered Plant Boundary	
Known Soil Contamination: Area or Site	
Potential Soil Contamination: Area or Site	


**BUILDINGS AND OTHER CULTURE:**

Gas Pump Vent or U/G Tank Cap	
Sign	
Well	
Small Mine	
Foundation	
Area Outline	
Cemetery	
Building	
School	
Church	
Dam	






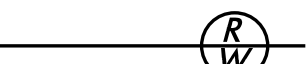











**HYDROLOGY:**

Stream or Body of Water	
Hydro, Pool or Reservoir	
Jurisdictional Stream	
Buffer Zone 1	
Buffer Zone 2	
Flow Arrow	
Disappearing Stream	
Spring	
Wetland	
Proposed Lateral, Tail, Head Ditch	
False Sump	

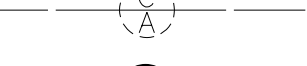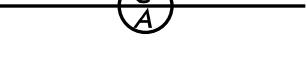**RAILROADS:**


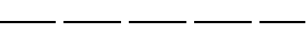
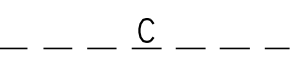
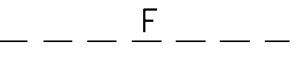





Standard Gauge	
RR Signal Milepost	
Switch	
RR Abandoned	
RR Dismantled	


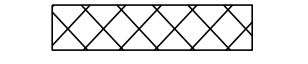
**RIGHT OF WAY:**

Baseline Control Point	
Existing Right of Way Marker	
Existing Right of Way Line	
Proposed Right of Way Line	
Proposed Right of Way Line with Iron Pin and Cap Marker	
Proposed Right of Way Line with Concrete or Granite R/W Marker	
Proposed Control of Access Line with Concrete C/A Marker	
Existing Control of Access	
Proposed Control of Access	
Existing Easement Line	
Proposed Temporary Construction Easement	
Proposed Temporary Drainage Easement	
Proposed Permanent Drainage Easement	
Proposed Permanent Drainage /Utility Easement	
Proposed Permanent Utility Easement	
Proposed Temporary Utility Easement	
Proposed Aerial Utility Easement	



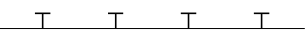

Proposed Permanent Easement with Iron Pin and Cap Marker	
--	---



**ROADS AND RELATED FEATURES:**

Existing Edge of Pavement	
Existing Curb	
Proposed Slope Stakes Cut	
Proposed Slope Stakes Fill	
Proposed Curb Ramp	
Existing Metal Guardrail	
Proposed Guardrail	
Existing Cable Guiderail	
Proposed Cable Guiderail	


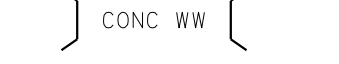
 




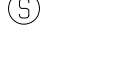

Equality Symbol	
Pavement Removal	

**VEGETATION:**




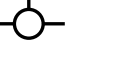

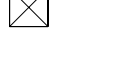



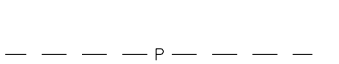

Single Tree	
Single Shrub	
Hedge	
Woods Line	

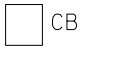Orchard	
Vineyard	


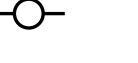
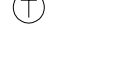










**EXISTING STRUCTURES:**

Bridge, Tunnel or Box Culvert	
Bridge Wing Wall, Head Wall and End Wall	
Head and End Wall	
Pipe Culvert	
Footbridge	
Drainage Box: Catch Basin, DI or JB	
Paved Ditch Gutter	
Storm Sewer Manhole	
Storm Sewer	


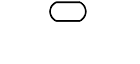





**UTILITIES:**

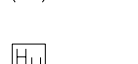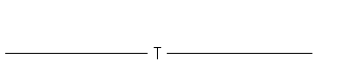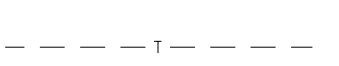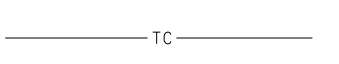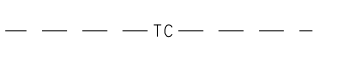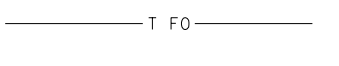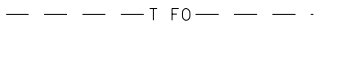 Existing Power Pole	
Proposed Power Pole	
Existing Joint Use Pole	
Proposed Joint Use Pole	
Power Manhole	
Power Line Tower	
Power Transformer	
U/G Power Cable Hand Hole	
H-Frame Pole	
Recorded U/G Power Line	
Designated U/G Power Line (S.U.E.*)	


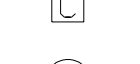
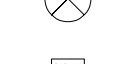





**TELEPHONE:**

Existing Telephone Pole	
Proposed Telephone Pole	
Telephone Manhole	
Telephone Booth	
Telephone Pedestal	
Telephone Cell Tower	
U/G Telephone Cable Hand Hole	
Recorded U/G Telephone Cable	
Designated U/G Telephone Cable (S.U.E.*)	
Recorded U/G Telephone Conduit	
Designated U/G Telephone Conduit (S.U.E.*)	
Recorded U/G Fiber Optics Cable	
Designated U/G Fiber Optics Cable (S.U.E.*)	


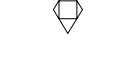
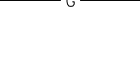


**WATER:**

Water Manhole	
Water Meter	
Water Valve	
Water Hydrant	
Recorded U/G Water Line	
Designated U/G Water Line (S.U.E.*)	
Above Ground Water Line	




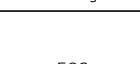
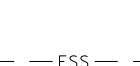

**TV:**

TV Satellite Dish	
TV Pedestal	
TV Tower	
U/G TV Cable Hand Hole	
Recorded U/G TV Cable	
Designated U/G TV Cable (S.U.E.*)	
Recorded U/G Fiber Optic Cable	
Designated U/G Fiber Optic Cable (S.U.E.*)	


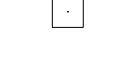










**GAS:**

Gas Valve	
Gas Meter	
Recorded U/G Gas Line	
Designated U/G Gas Line (S.U.E.*)	
Above Ground Gas Line	

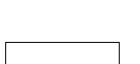**SANITARY SEWER:**

Sanitary Sewer Manhole	
Sanitary Sewer Cleanout	
U/G Sanitary Sewer Line	
Above Ground Sanitary Sewer	
Recorded SS Forced Main Line	
Designated SS Forced Main Line (S.U.E.*)	

**MISCELLANEOUS:**



Utility Pole	
Utility Pole with Base	
Utility Located Object	
Utility Traffic Signal Box	
Utility Unknown U/G Line	
U/G Tank; Water, Gas, Oil	
Underground Storage Tank, Approx. Loc.	
A/G Tank; Water, Gas, Oil	
Geoenvironmental Boring	
U/G Test Hole (S.U.E.*)	
Abandoned According to Utility Records	
End of Information	

12/01/2005

5/6/26 PM  
R:\projects\ProJ\670051\1s\_1c.dgn  
10/5/26 882

67-0051 SURVEY CONTROL SHEET

PROJECT REFERENCE NO.	SHEET NO.
17BP.7.R.94 - ORANGE 51	1C
Location and Surveys	

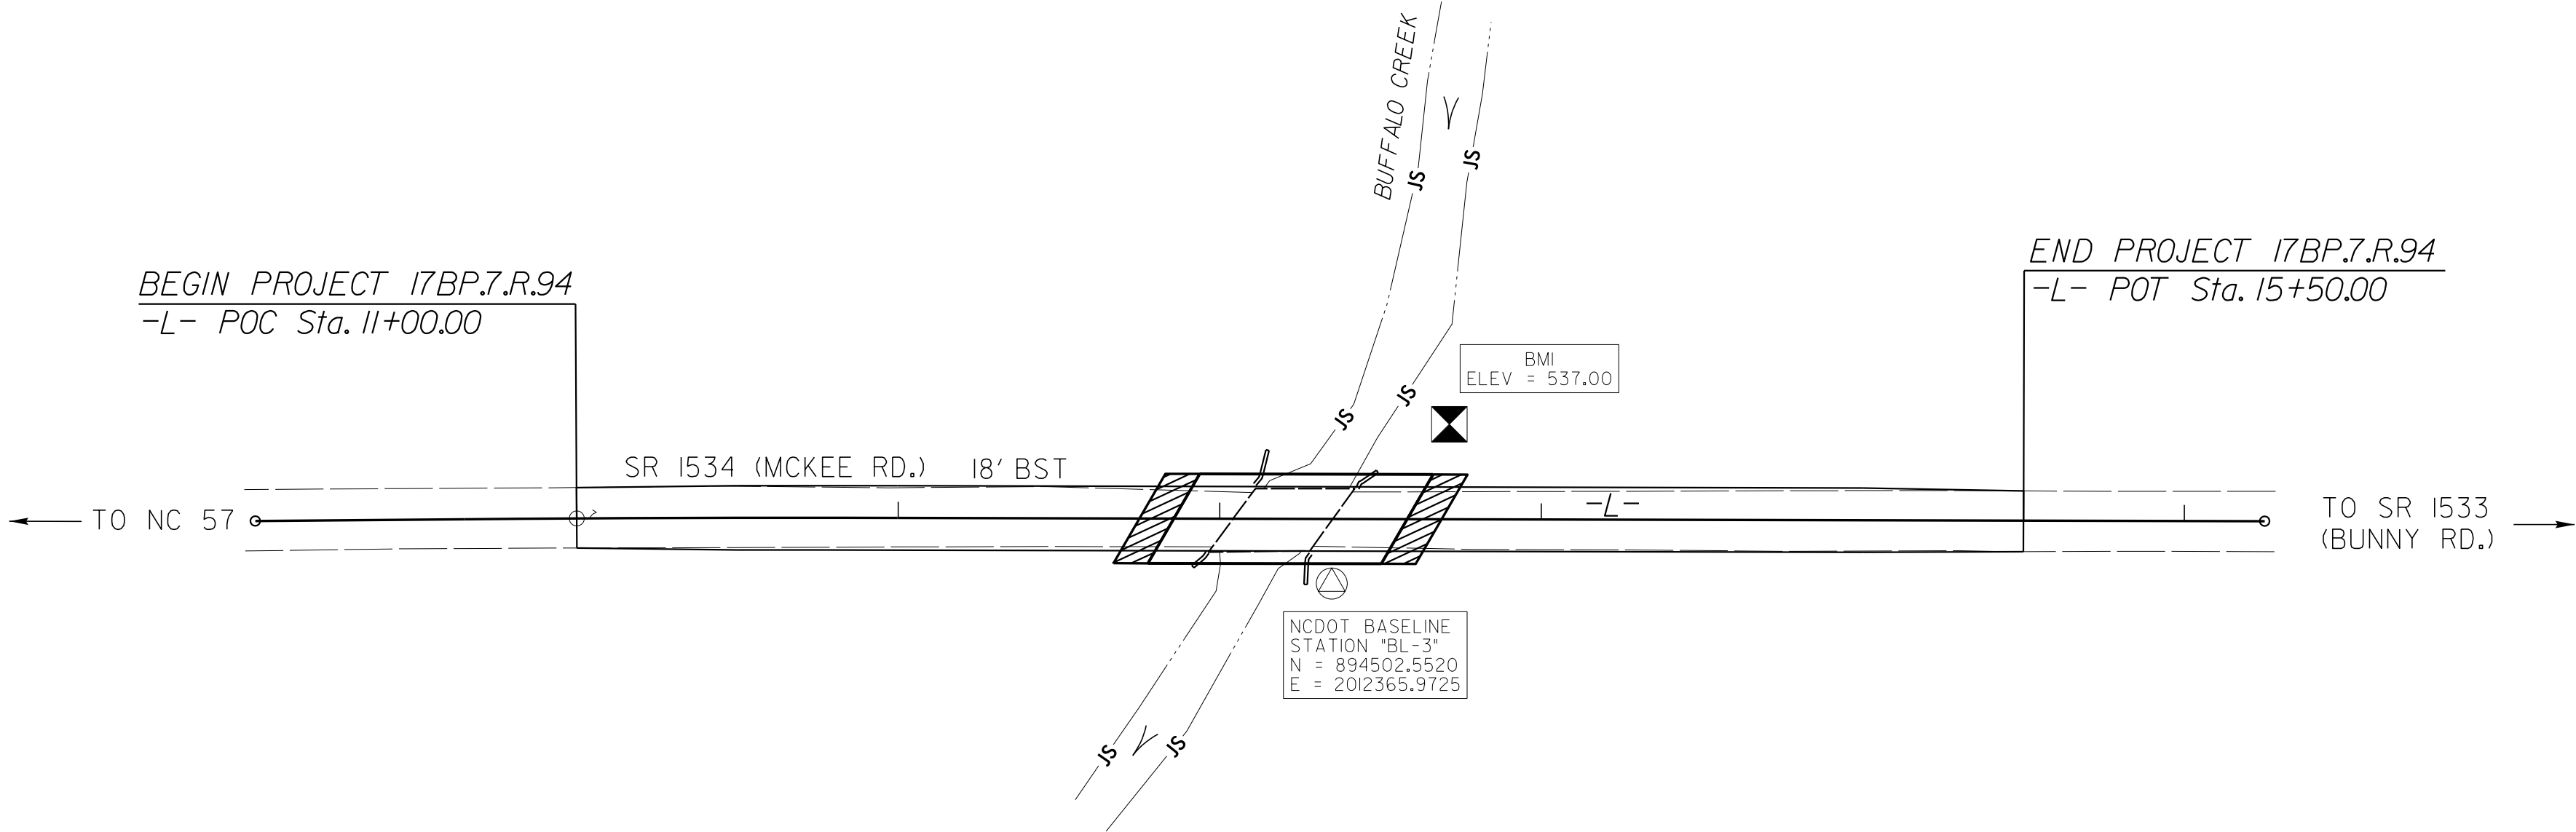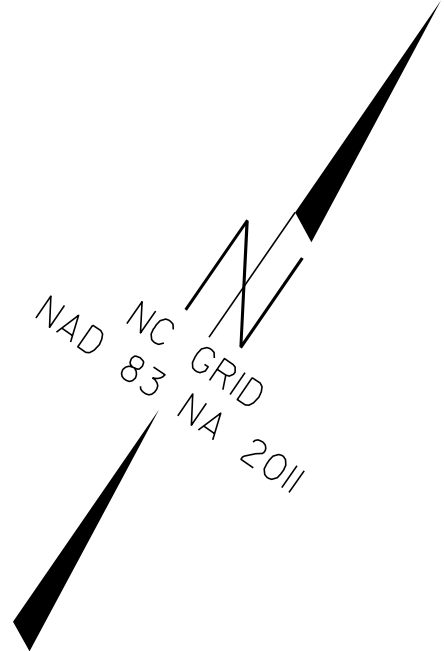

NCDOT GPS  
STATION "670051-1"  
N = 894941.2300  
E = 2012949.3800  
ELEV = 562.63

-L- NEW PRELIMINARY PERMANENT DRAINAGE EASEMENTS				
ALIGN	STATION	OFFSET	NORTH	EAST
L	12+40.00	30.32	894435.2740	2012297.4903
L	12+40.00	50.00	894419.0383	2012308.6196
L	14+20.00	30.18	894537.1580	2012445.8806
L	14+20.00	50.00	894520.8101	2012457.0868

-L- NEW PRELIMINARY PERMANENT DRAINAGE UTILITY EASEMENTS				
ALIGN	STATION	OFFSET	NORTH	EAST
L	12+40.00	-29.68	894484.7630	2012263.5664
L	12+40.00	-50.00	894501.5201	2012252.0797
L	14+20.00	-55.00	894607.4159	2012397.7200
L	14+20.00	-29.82	894586.6471	2012411.9567

-L- NEW PRELIMINARY PERMANENT UTILITY EASEMENTS				
ALIGN	STATION	OFFSET	NORTH	EAST
L	14+20.00	-55.00	894607.4159	2012397.7200
L	15+00.00	-55.00	894652.6478	2012463.7054
L	15+20.00	-65.00	894672.2040	2012474.5478
L	16+15.00	-29.97	894697.0214	2012572.7128

L			
TYPE	STATION	NORTH	EAST
POT	10+00.00	894323.4114	2012083.2046
PC	10+65.00	894360.7378	2012136.4188
PT	11+99.66	894437.4685	2012247.0727
POT	16+25.00	894677.9577	2012597.9046

BASELINE DATA

BL	POINT	DESC.	NORTH	EAST	ELEVATION	BL STATION
3		BL-3	894502.5520	2012365.9725	534.31	5+00.00
1		670051-1	894941.2300	2012949.3800	562.63	12+29.93
2		670051-2	894940.4580	2013629.5810	546.00	19+10.13

NOTES

1. THE CONTROL DATA FOR THIS PROJECT CAN BE FOUND ELECTRONICALLY BY SELECTING PROJECT CONTROL DATA AT:  
[HTTP://WWW.DOH.DOT.STATE.NC.US/PRECONSTRUCT/HIGHWAY/LOCATION/PROJECT/](http://www.doh.dot.state.nc.us/preconstruct/highway/location/project/)

THE FILES TO BE FOUND ARE AS FOLLOWS:  
670051\_ls\_control.txt

SITE CALIBRATION INFORMATION HAS NOT BEEN PROVIDED FOR THIS PROJECT. IF FURTHER INFORMATION IS NEEDED, PLEASE CONTACT THE LOCATION AND SURVEYS UNIT.

⊗ INDICATES GEODETIC CONTROL MONUMENTS USED OR SET FOR HORIZONTAL PROJECT CONTROL BY THE NCDOT LOCATION AND SURVEYS UNIT.  
PROJECT CONTROL ESTABLISHED USING GLOBAL POSITIONING SYSTEM.

DATUM DESCRIPTION

THE LOCALIZED COORDINATE SYSTEM DEVELOPED FOR THIS PROJECT IS BASED ON THE STATE PLANE COORDINATES ESTABLISHED BY NCDOT FOR MONUMENT "670051-1" WITH NAD 83/NA 2011 STATE PLANE GRID COORDINATES OF NORTHING: 894941.2300(±) EASTING: 2012949.3800(±) ELEVATION: 562.63'(±) THE AVERAGE COMBINED GRID FACTOR USED ON THIS PROJECT (GROUND TO GRID) IS: 0.9999900344 THE N.C. LAMBERT GRID BEARING AND LOCALIZED HORIZONTAL GROUND DISTANCE FROM "670051-1" TO -L- STATION 11+00.00 IS S 54°27'04" W 963.94' ALL LINEAR DIMENSIONS ARE LOCALIZED HORIZONTAL DISTANCES VERTICAL DATUM USED IS NAVD 88

BENCHMARK DATA

\*\*\*\*\*  
BM1 ELEVATION = 537.00  
N 894559 E 2012372  
BL STATION 5+39.00 41 LEFT  
BENCH TIE SPIKE IN 12" MAPLE  
\*\*\*\*\*

NOTE: DRAWING NOT TO SCALE



USE TYPICAL SECTION NO. 1:

TRANSITION FROM TYPICAL SECTION NO. 1 TO EXISTING:

27'-10" CLEAR ROADWAY

3'-11" 10'-0" 10'-0" 3'-11"

CL-L-

GRADE POINT

0.02 FT/FT 0.02 FT/FT

30'-0"


10 CORED SLAB UNITS

### TYPICAL SECTION NO. 2

USE TYPICAL SECTION NO. 2:

-L- STA 12+85.70 (BEGIN BRIDGE) TO 13+58.30 (END BRIDGE)

NOTE: SEE STRUCTURE PLANS FOR PAVEMENT DEPTHS ON STRUCTURE

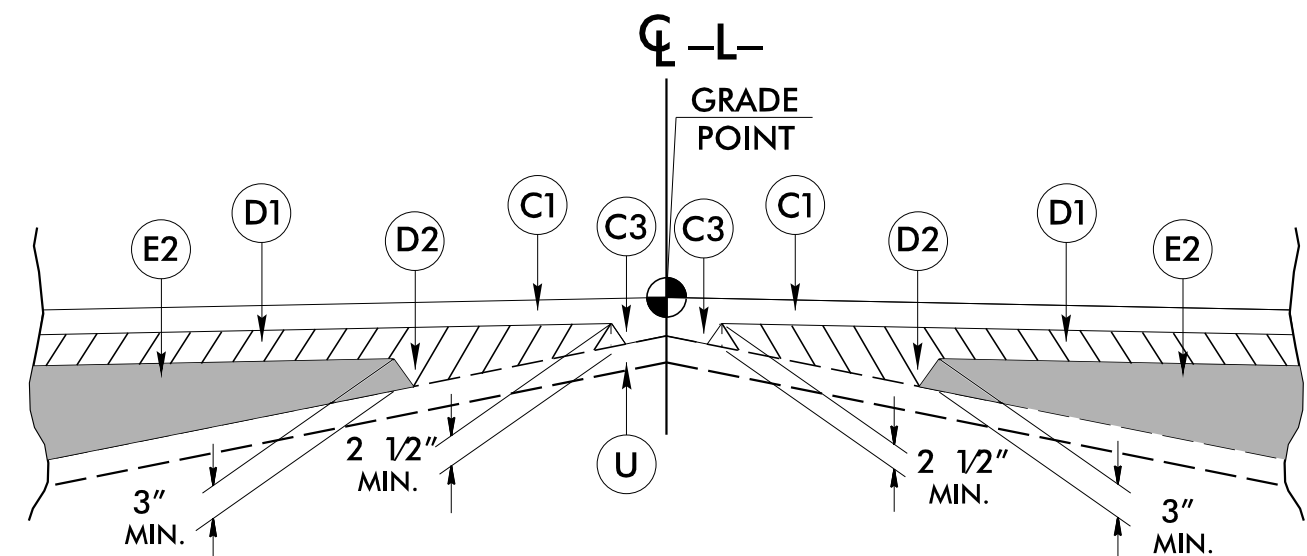




### Detail Showing Method of Wedging

PAVEMENT SCHEDULE	
C1	PROP. APPROX. 1½" ASPHALT CONCRETE SURFACE COURSE, TYPE S9.5C, AT AN AVERAGE RATE OF 168 LBS. PER SQ. YD.
C2	PROP. APPROX. 3" ASPHALT CONCRETE SURFACE COURSE, TYPE S9.5C, AT AN AVERAGE RATE OF 168 LBS. PER SQ. YD. IN EACH OF TWO LAYERS.
C3	PROP. VAR. DEPTH ASPHALT CONCRETE SURFACE COURSE, TYPE S9.5C, AT AN AVERAGE RATE OF 112 LBS. PER SQ. YD. PER 1" DEPTH. TO BE PLACED IN LAYERS NOT LESS THAN 1½" IN DEPTH OR GREATER THAN 2" IN DEPTH.
D1	PROP. APPROX. 2½" ASPHALT CONCRETE INTERMEDIATE COURSE, TYPE I19.0C, AT AN AVERAGE RATE OF 285 LBS. PER SQ. YD.
D2	PROP. VAR. DEPTH ASPHALT CONCRETE INTERMEDIATE COURSE, TYPE I19.0C, AT AN AVERAGE RATE OF 114 LBS. PER SQ. YD. PER 1" DEPTH, TO BE PLACED IN LAYERS NOT LESS THAN 2½" IN DEPTH OR GREATER THAN 4" IN DEPTH.
E1	PROP. APPROX. 4" ASPHALT CONCRETE BASE COURSE, TYPE B25.0C, AT AN AVERAGE RATE OF 456 LBS. PER SQ. YD.
E2	PROP. VAR. DEPTH ASPHALT CONCRETE BASE COURSE, TYPE B25.0C, AT AN AVERAGE RATE OF 114 LBS. PER SQ. YD. PER 1" DEPTH TO BE PLACED IN LAYERS NOT LESS THAN 3" IN DEPTH OR GREATER THAN 5½" IN DEPTH.
T	EARTH MATERIAL.
U	EXISTING PAVEMENT.
W	WEDGING (SEE DETAIL SHOWING METHOD OF WEDGING).

NOTE: PAVEMENT EDGE SLOPES ARE 1:1 UNLESS SHOWN OTHERWISE.





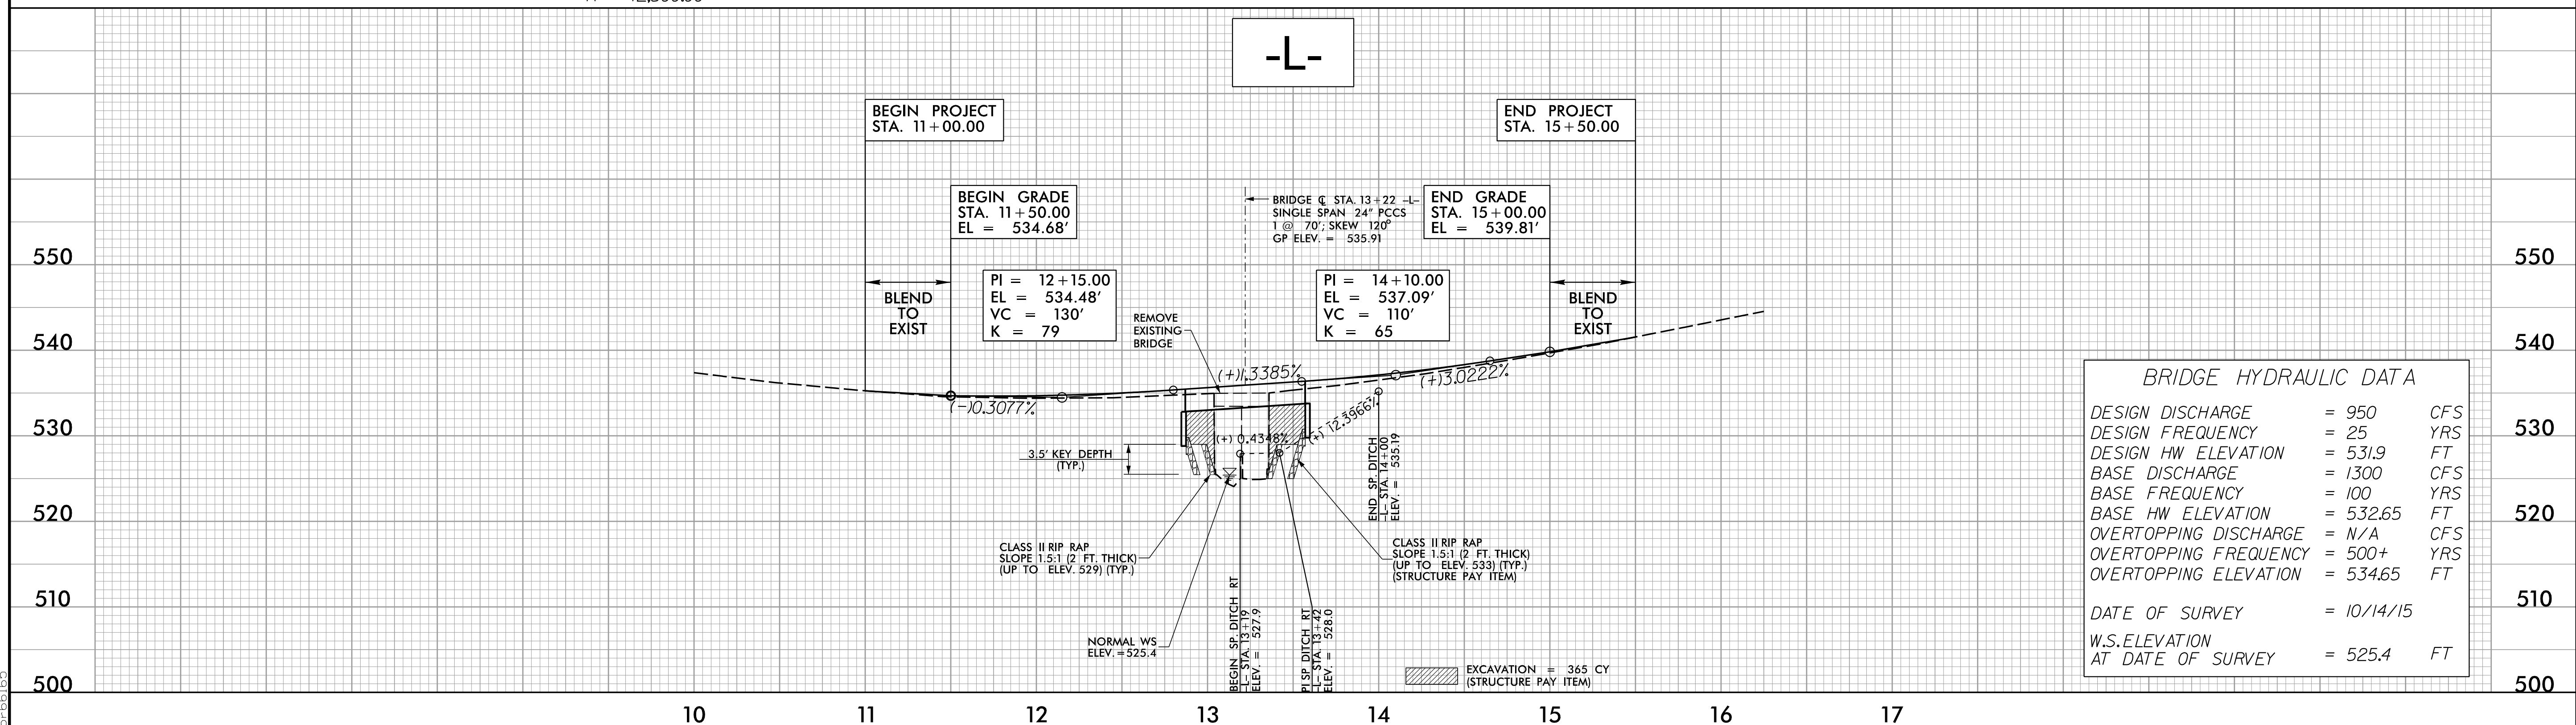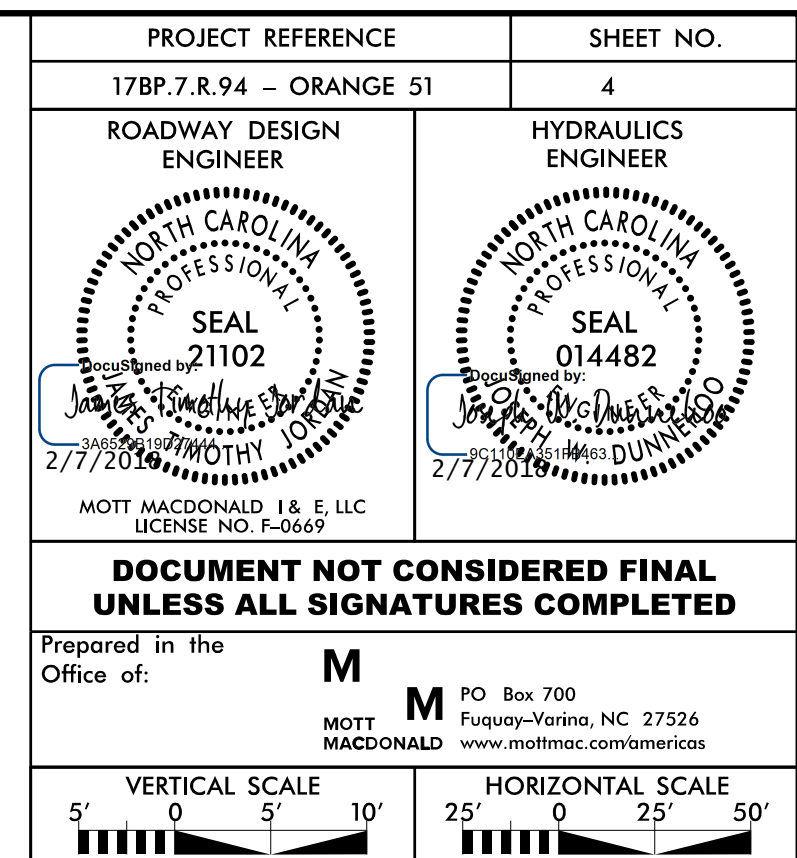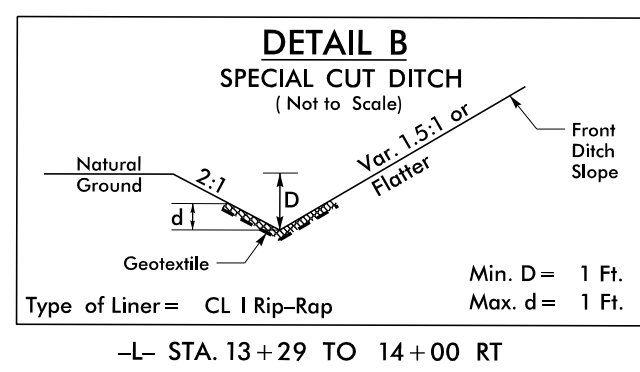



THE FOLLOWING ROADWAY STANDARDS AS APPEAR IN “ROADWAY STANDARD DRAWINGS” – HIGHWAY DESIGN BRANCH– N.C. DEPARTMENT OF TRANSPORTATION – RALEIGH, N.C., DATED JANUARY 2018 ARE APPLICABLE TO THIS PROJECT AND BY REFERENCE HEREBY ARE CONSIDERED A PART OF THESE PLANS:

STD.	TITLE
1101.03	TEMPORARY ROAD CLOSURES
1110.01	STATIONARY WORK ZONE SIGNS
1145.01	BARRICADES
1205.01	PAVEMENT MARKINGS – LINE TYPES AND OFFSETS
1205.02	PAVEMENT MARKINGS – TWO-LANE AND MULTI-LANE ROADWAYS
1205.12	PAVEMENT MARKINGS – BRIDGES
1261.01	GUARDRAIL AND BARRIER DELINEATORS – INSTALLATION SPACING
1261.02	GUARDRAIL AND BARRIER DELINEATORS – TYPES AND MOUNTING
1262.01	GUARDRAIL END DELINEATION

GENERAL NOTES

CHANGES MAY BE REQUIRED WHEN PHYSICAL DIMENSIONS IN THE DETAIL DRAWINGS, STANDARD DETAILS, AND ROADWAY DETAILS ARE NOT ATTAINABLE TO MEET FIELD CONDITIONS OR RESULT IN DUPLICATE OR UNDESIREED OVERLAPPING OF DEVICES. MODIFICATION MAY INCLUDE: MOVING, SUPPLEMENTING, COVERING, OR REMOVAL OF DEVICES AS DIRECTED BY THE ENGINEER.

THE FOLLOWING GENERAL NOTES APPLY AT ALL TIMES FOR THE DURATION OF THE CONSTRUCTION PROJECT EXCEPT WHEN OTHERWISE NOTED IN THE PLAN OR DIRECTED BY THE ENGINEER.

TRAFFIC PATTERN ALTERATIONS

A) NOTIFY THE ENGINEER TWENTY ONE (21) CALENDAR DAYS PRIOR TO ANY TRAFFIC PATTERN ALTERATION.

SIGNING

B) PROVIDE PERMANENT SIGNING.

C) PROVIDE SIGNING AND DEVICES REQUIRED TO CLOSE THE ROAD ACCORDING TO THE ROADWAY STANDARD DRAWINGS AND TRAFFIC CONTROL PLANS.

PROVIDE SIGNING REQUIRED FOR THE OFF-SITE DETOUR ROUTE AS SHOWN IN THE TRAFFIC CONTROL PLANS.

D) COVER OR REMOVE ALL SIGNS AND DEVICES REQUIRED TO CLOSE THE ROAD WHEN ROAD CLOSURE IS NOT IN OPERATION.

COVER OR REMOVE ALL SIGNS REQUIRED FOR THE OFF-SITE DETOUR WHEN THE DETOUR IS NOT IN OPERATION.


E) ENSURE ALL NECESSARY SIGNING IS IN PLACE PRIOR TO ALTERING ANY TRAFFIC PATTERN.

TRAFFIC CONTROL DEVICES

F) PLACE TYPE III BARRICADES, WITH “ROAD CLOSED” SIGN R11-2 ATTACHED, OF SUFFICIENT LENGTH TO CLOSE ENTIRE ROADWAY.

PAVEMENT MARKINGS AND MARKERS

G) INSTALL PAVEMENT MARKINGS ON THE FINAL SURFACE.



PROJECT REFERENCE		SHEET NO.
17BP.7.R.94 – ORANGE 51		TMP-1
ROADWAY DESIGN ENGINEER		
		
DOCUMENT NOT CONSIDERED FINAL UNLESS ALL SIGNATURES COMPLETED		
Prepared in the Office of:		<div>MOTT MACDONALD</div> <div>PO Box 700 Fuquay-Varina, NC 27526 www.mottmac.com/americas</div>

PHASING

- STEP 1: USING ROADWAY STANDARD DRAWING NUMBER 1101.03, SHEET 1 OF 9, AND SHEET TMP-2, PERFORM THE FOLLOWING:  
– INSTALL ALL ROAD CLOSURE AND DETOUR SIGNING INCLUDING BARRICADES  
– CLOSE SR 1534 (MCKEE ROAD)  
– PLACE TRAFFIC ONTO OFF- SITE DETOUR
- STEP 2: REMOVE EXISTING BRIDGE #51 AND CONSTRUCT THE PROPOSED BRIDGE AND APPROACHES AS SHOWN IN THE CONSTRUCTION PLANS.
- STEP 3: INSTALL FINAL PAVEMENT MARKINGS.
- STEP 4: REMOVE ALL TRAFFIC CONTROL SIGNING AND DEVICES AND RE-OPEN SR 1534 (MCKEE ROAD) TO THE FINAL TRAFFIC PATTERN.

PAVEMENT MARKING

THERMOPLASTIC (4” – 90 MILS)	900 LF
THERMOPLASTIC (4” – 120 MILS)	900 LF

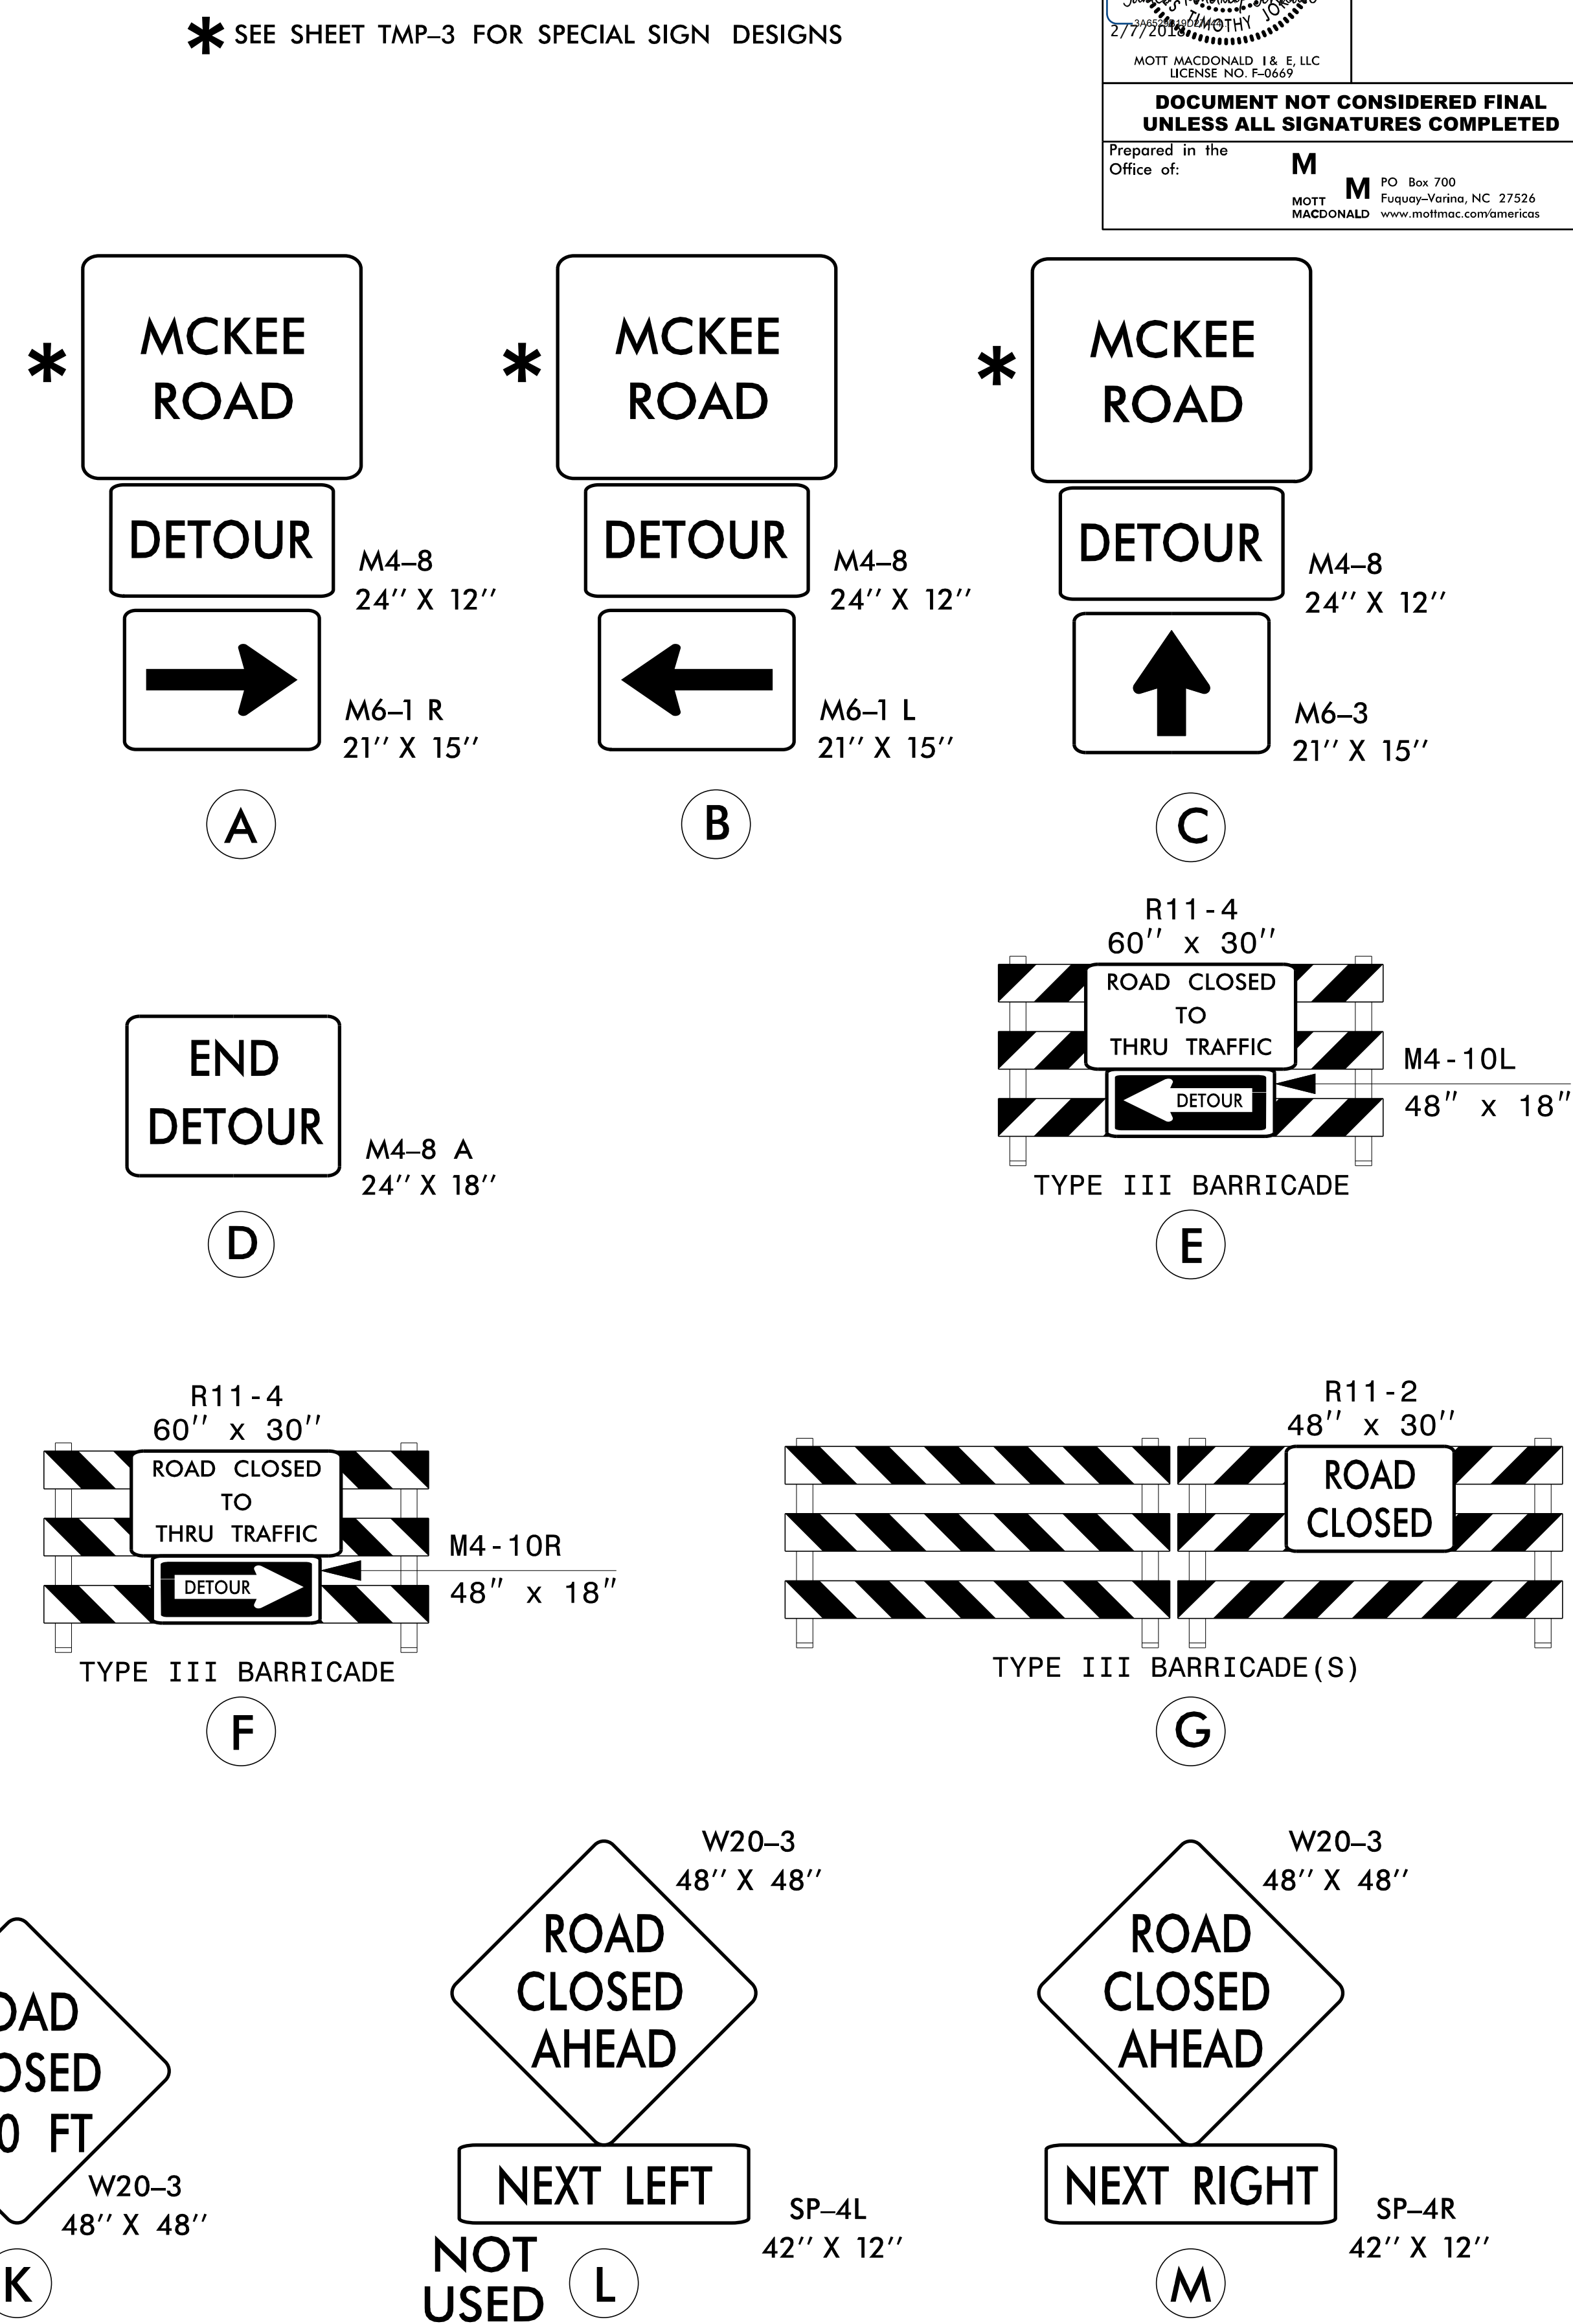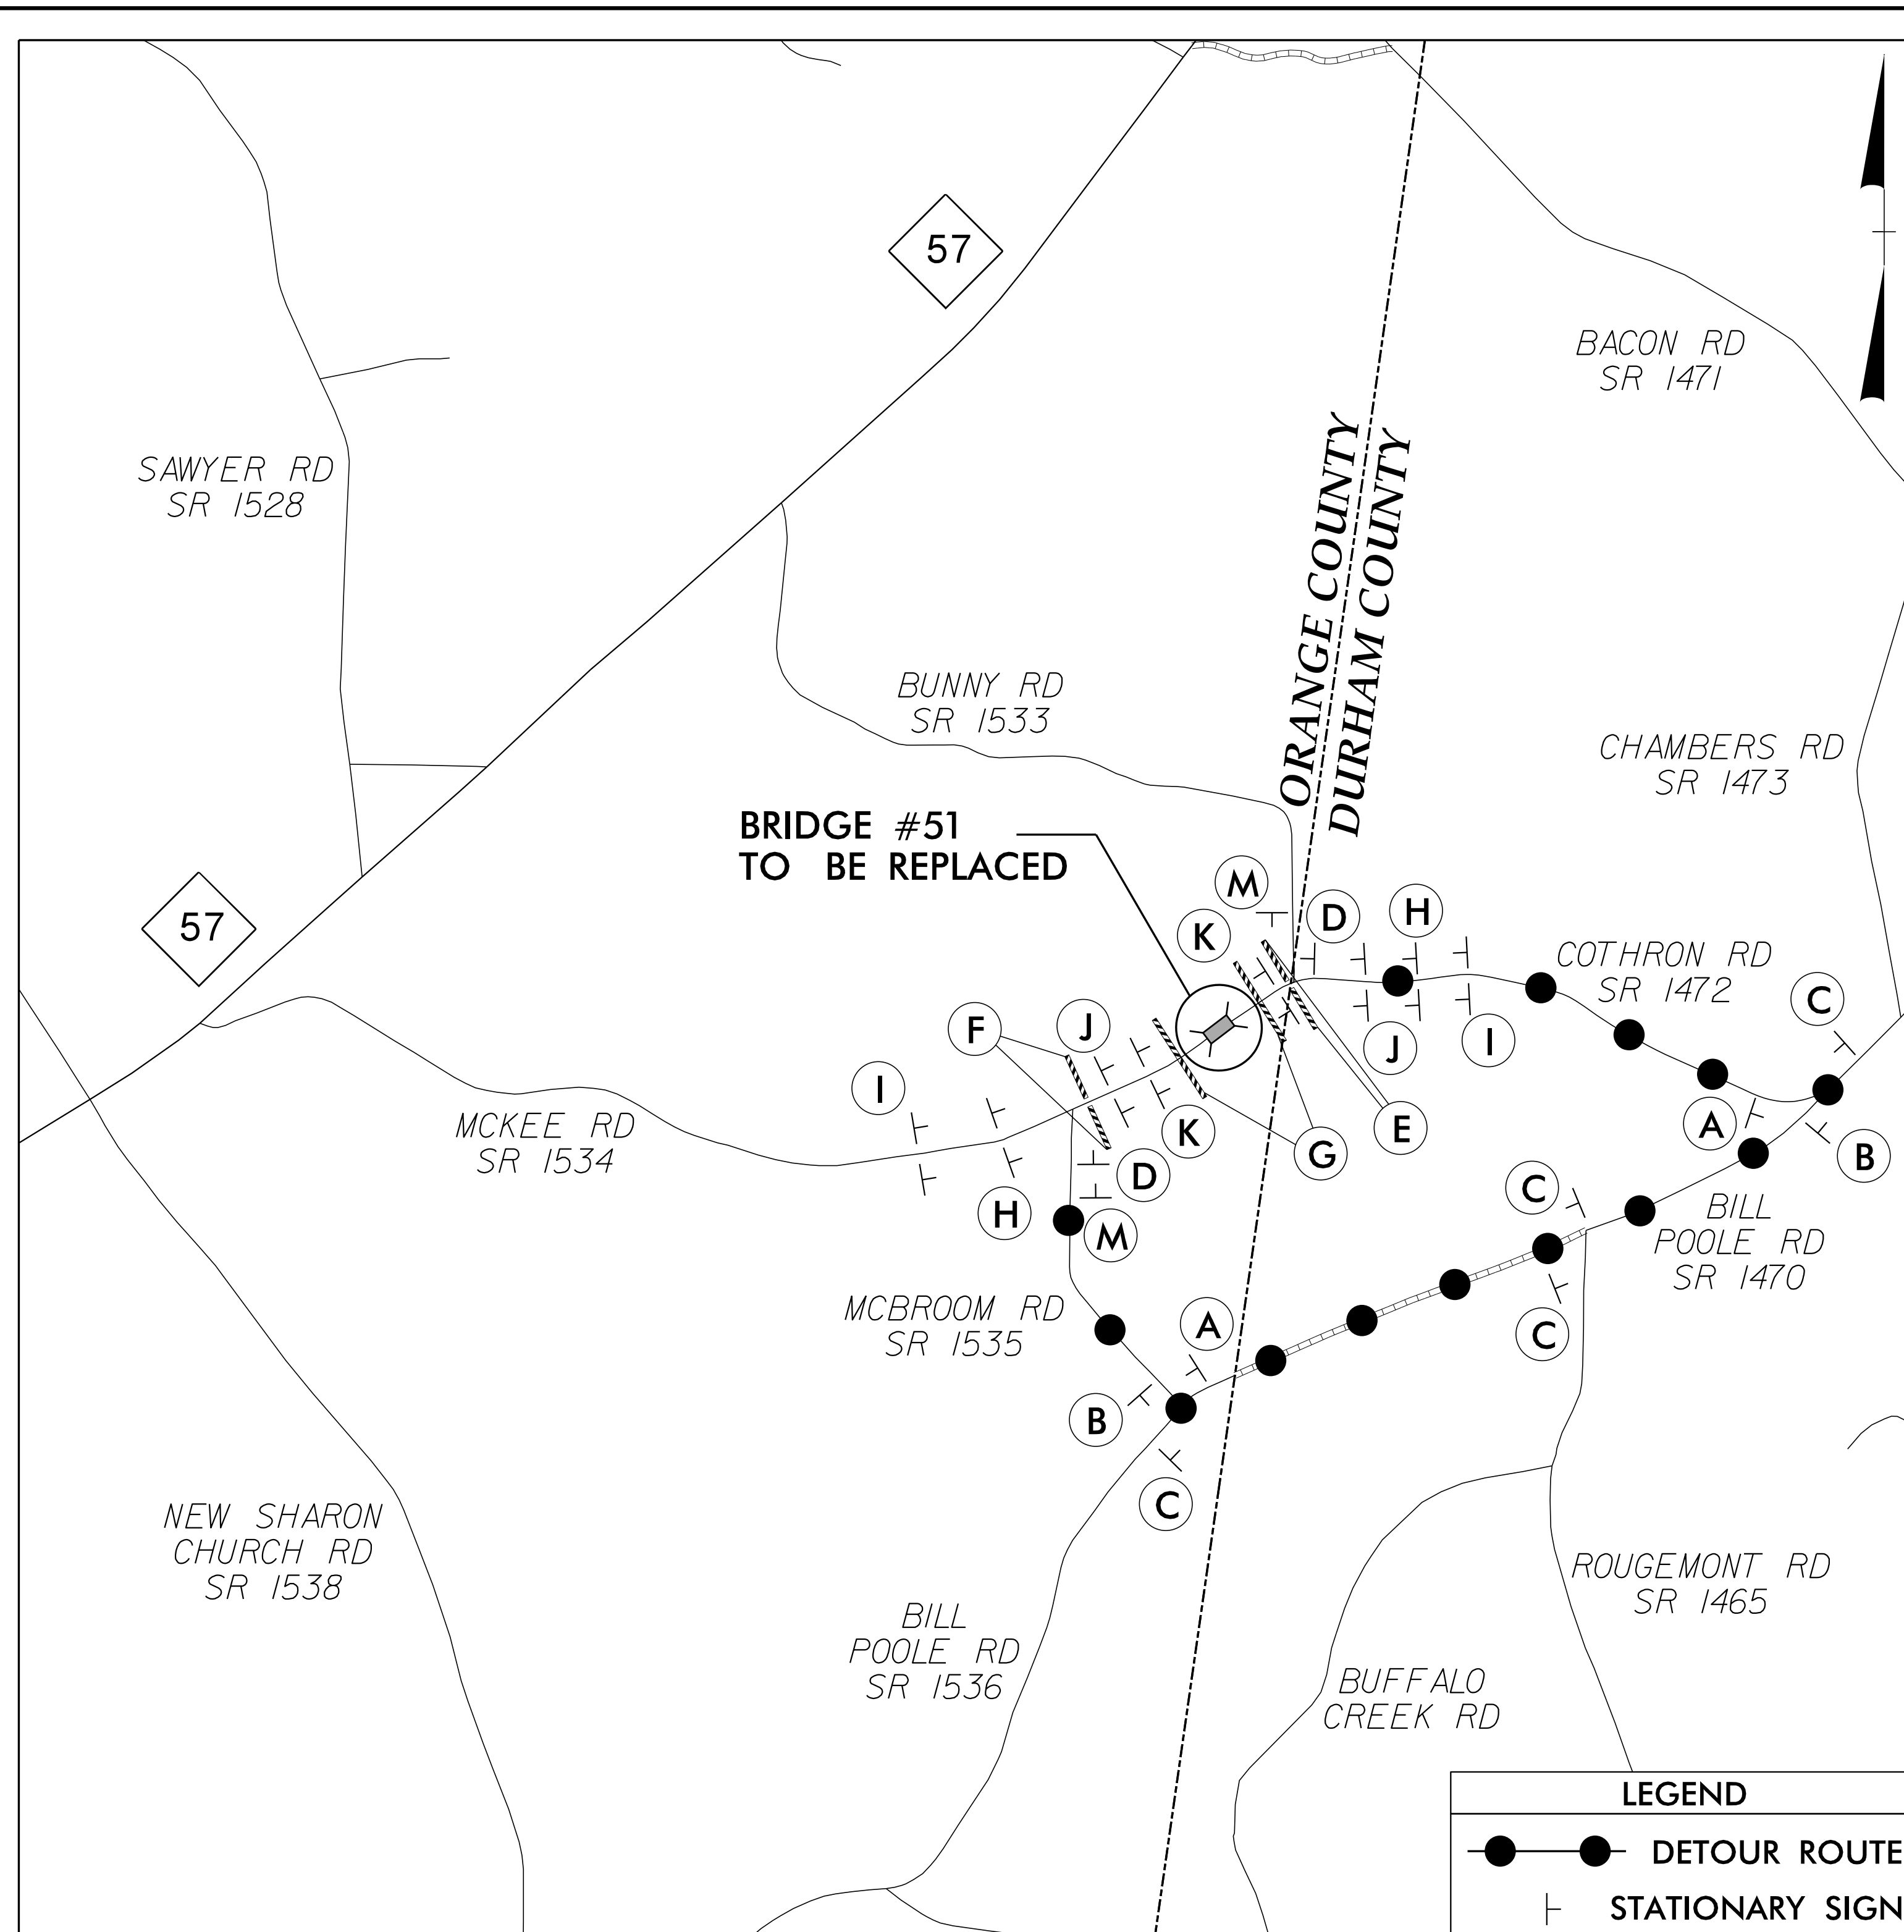

PROJECT REFERENCE

17BP.7.R.94 -- ORANGE 51

SHEET NO.

TMP-3

TRAFFIC ENGINEER

SEAL

032711

2/12/2015

THOMAS W. THOMPSON

2/12/2015

MOTT MACDONALD 1 & E, LLC

LICENSE NO. E-0669

DOCUMENT NOT CONSIDERED FINAL

UNLESS ALL SIGNATURES COMPLETED

Prepared in the Office of:

M

MOTT MACDONALD

PO Box 700

Fuquay-Varina, NC 27526

www.mottmac.com/americas

SIGN NUMBER: SD-1

TYPE: D

QUANTITY: SEE PLANS

SIGN WIDTH: 3'-0"

HEIGHT: 2'-6"

TOTAL AREA: 7.5 Sq.Ft.

BORDER TYPE: INSET

RECESS: 0.38"

WIDTH: 0.5"

RADII: 1.5"

NO. Z BARS:

LENGTH:

BACKG COLOR: Fluorescent Orange

COPY COLOR: Black

SYMBOL	X	Y	WID	HT

MAT'L: 0.080" (2.0 mm) ALUMINUM

DESIGN BY: PJ

PROJECT ID: 17BP.7.R.94

CHECKED BY: RWT

DIV: 7

DATE: Oct 20, 2015

3'-0"

2'-6"

6.75"

6"C

4.5"

6"C

6.75"

7.4"

21.2"

7.4"

MCKEE

ROAD

BORDER

R=1.5"

TH=0.5"

IN=0.38"

Spacing Factor is 1 unless specified otherwise

LETTER POSITIONS

Letter locations are panel edge to lower left corner																										Series/Size		
																										Text Length		
	M	C	K	E	E																						C 2000	
	7.4	12.5	17.1	21.5	25.6																							21.2
	R	O	A	D																								C 2000
	9.7	14	18.2	22.9																								16.6

FILENAME: 670051\_rdy\_tmp3

NORTH CAROLINA D.O.T. SIGN DETAIL

I:\or66165  
R:\Roadway\Proj\670051\_rdy\_tmp3.dgn  
2/7/2018 8:05:27 AM




D:\orange\SYSTEM\EROSION CONTROL\17BP.7.R.94\17BP.7.R.94.dgn

TIP PROJECT: 17BP.7.R.94

STATE OF NORTH CAROLINA  
DIVISION OF HIGHWAYS  
PLAN FOR PROPOSED  
HIGHWAY EROSION CONTROL  
**ORANGE COUNTY**

LOCATION: BRIDGE NO. 51 OVER BUFFALO CREEK ON SR 1534 (MCKEE ROAD)  
TYPE OF WORK: GRADING, PAVING, DRAINAGE AND STRUCTURE

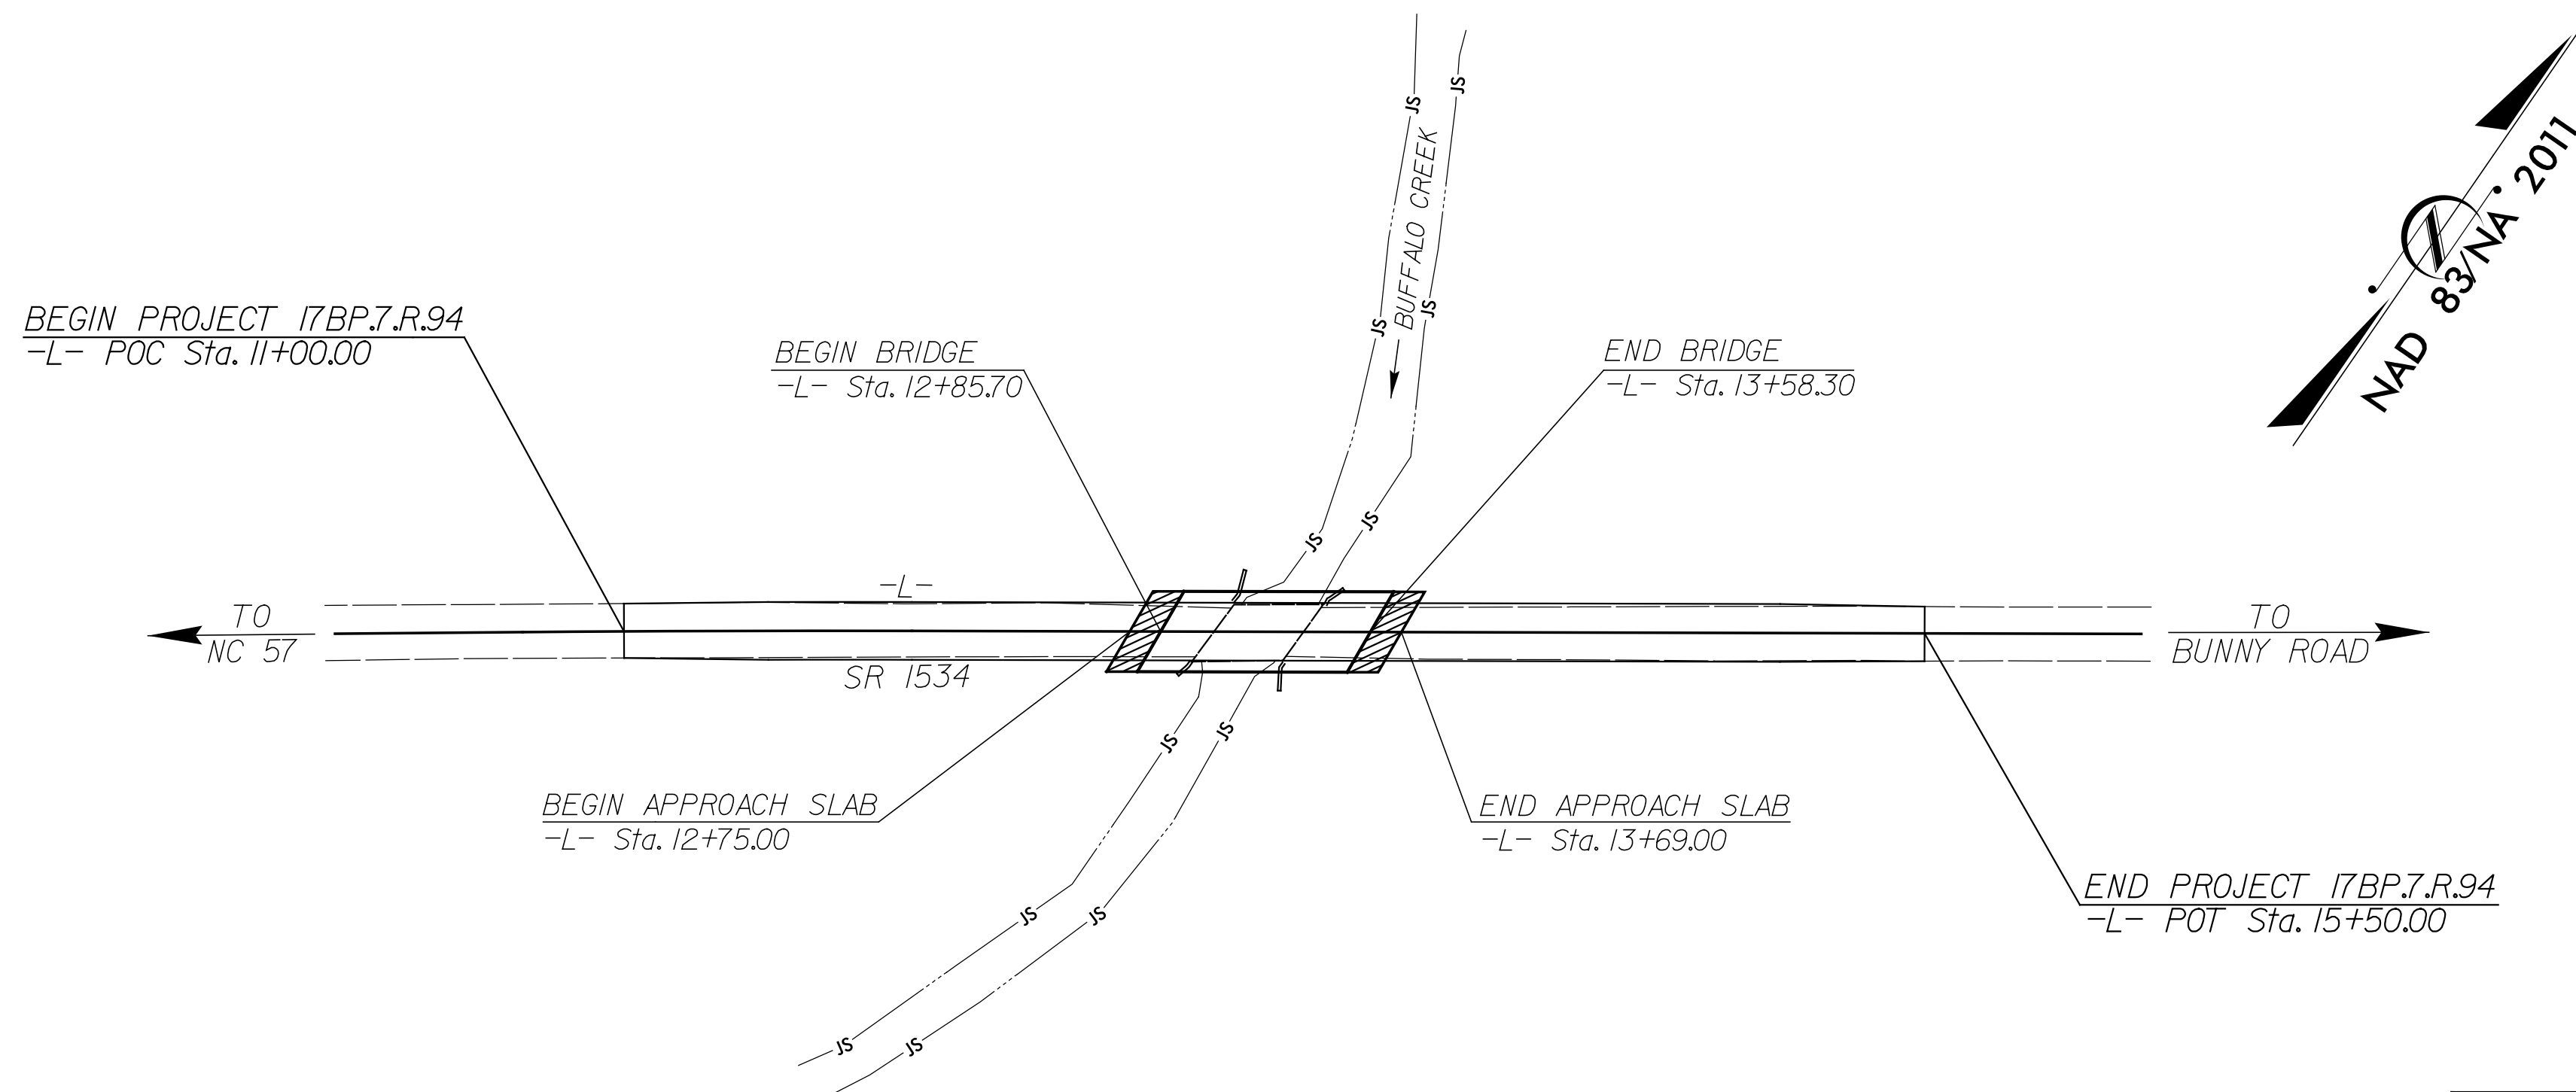

STATE	STATE PROJECT REFERENCE NO.	SHEET NO.	TOTAL SHEETS
N.C.	17BP.7.R.94	EC-1	
STATE PROJ. NO.	F.A. PROJ. NO.	DESCRIPTION	

EROSION AND SEDIMENT CONTROL MEASURES

Std. #	Description	Symbol
1630.03	Temporary Silt Ditch	TS
1630.05	Temporary Diversion	TD
1605.01	Temporary Silt Fence	TSF
1606.01	Special Sediment Control Fence	SSCF
1622.01	Temporary Berms and Slope Drains	TBSD
1630.02	Silt Basin Type B	SB
1633.01	Temporary Rock Silt Check Type-A	TRSCA
	Temporary Rock Silt Check Type-A with Matting and Polyacrylamide (PAM)	TRSCA-PAM
1633.02	Temporary Rock Silt Check Type-B	TRSCB
	Wattle/Coir Fiber Wattle	W/CFW
	Wattle/Coir Fiber Wattle with Polyacrylamide (PAM)	W/CFW-PAM
1634.01	Temporary Rock Sediment Dam Type-A	TRSDA
1634.02	Temporary Rock Sediment Dam Type-B	TRSDA-B
1635.01	Rock Pipe Inlet Sediment Trap Type-A	RPIST-A
1635.02	Rock Pipe Inlet Sediment Trap Type-B	RPIST-B
1630.04	Stilling Basin	SB
1630.06	Special Stilling Basin	SSB
	Rock Inlet Sediment Trap:	
1632.01	Type A	A
1632.02	Type B	B
1632.03	Type C	C
	Skimmer Basin	SB
	Tiered Skimmer Basin	TSB
	Infiltration Basin	IB

THIS PROJECT CONTAINS  
EROSION CONTROL PLANS  
FOR CLEARING AND  
GRUBBING PHASE OF  
CONSTRUCTION.

THIS PROJECT HAS  
BEEN DESIGNED TO  
SENSITIVE WATERSHED  
STANDARDS.


ENVIRONMENTALLY  
SENSITIVE AREA(S) EXIST  
ON THIS PROJECT

Refer To E. C. Special Provisions  
for Special Considerations.

HIGH QUALITY WATER(S) EXIST  
ON THIS PROJECT

High Quality Water Zone(s) Exist  
From Sta. 11+00  
to Sta. 15+50  
Refer To E. C. Special Provisions  
for Special Considerations.

GRAPHIC SCALE

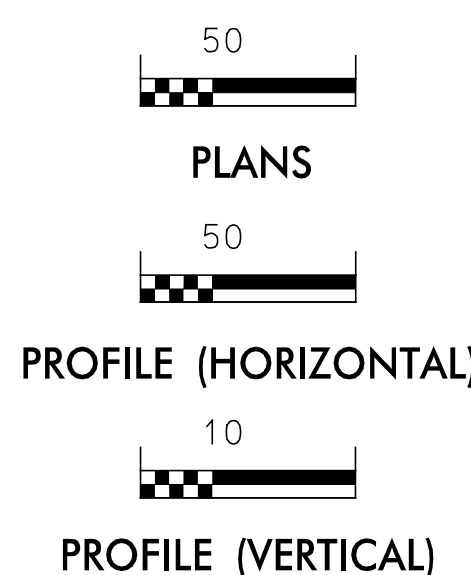

THESE EROSION AND SEDIMENT  
CONTROL PLANS COMPLY WITH  
THE REGULATIONS SET FORTH  
BY THE NCG-010000 GENERAL  
CONSTRUCTION PERMIT EFFECTIVE  
AUGUST 1, 2016 AND ISSUED BY  
THE NORTH CAROLINA DEPARTMENT  
OF ENVIRONMENT AND NATURAL  
RESOURCES DIVISION OF WATER  
RESOURCES.

Prepared In the Office of:



HDR Engineering, Inc. of the Carolinas  
555 Fayetteville St., Suite 900 Raleigh, N.C. 27601  
N.C.B.E.L.S. License Number: F-0116

Designed by:

**ALEXANDER D. SNIDER, PE** 3064  
NAME LEVEL III CERTIFICATION NO.

Reviewed In the Office of:

**ROADSIDE ENVIRONMENTAL UNIT**

1 South Wilmington St.  
Raleigh, NC 27611

**2018 STANDARD SPECIFICATIONS**

Reviewed by:


**JEFF WALSTON, PE, CPESC, CPSWQ**

Roadway Standard Drawings

The following roadway english standards as appear in "Roadway Standard Drawings"- Roadway Design Unit - N. C. Department of Transportation - Raleigh, N. C., dated January 2018 and the latest revision thereto are applicable to this project and by reference hereby are considered a part of these plans.

1604.01	Railroad Erosion Control Detail	1632.01	Rock Inlet Sediment Trap Type A
1605.01	Temporary Silt Fence	1632.02	Rock Inlet Sediment Trap Type B
1606.01	Special Sediment Control Fence	1632.03	Rock Inlet Sediment Trap Type C
1607.01	Gravel Construction Entrance	1633.01	Temporary Rock Silt Check Type A
1622.01	Temporary Berms and Slope Drains	1633.02	Temporary Rock Silt Check Type B
1630.01	Riser Basin	1634.01	Temporary Rock Sediment Dam Type A
1630.02	Silt Basin Type B	1634.02	Temporary Rock Sediment Dam Type B
1630.03	Temporary Silt Ditch	1635.01	Rock Pipe Inlet Sediment Trap Type A
1630.04	Stilling Basin	1635.02	Rock Pipe Inlet Sediment Trap Type B
1630.05	Temporary Diversion	1640.01	Coir Fiber Baffle
1630.06	Special Stilling Basin	1645.01	Temporary Stream Crossing
1631.01	Matting Installation		

# TEMPORARY ROCK SILT CHECK TYPE 'A' WITH EXCELSIOR MATTING AND POLYACRYLAMIDE (PAM)

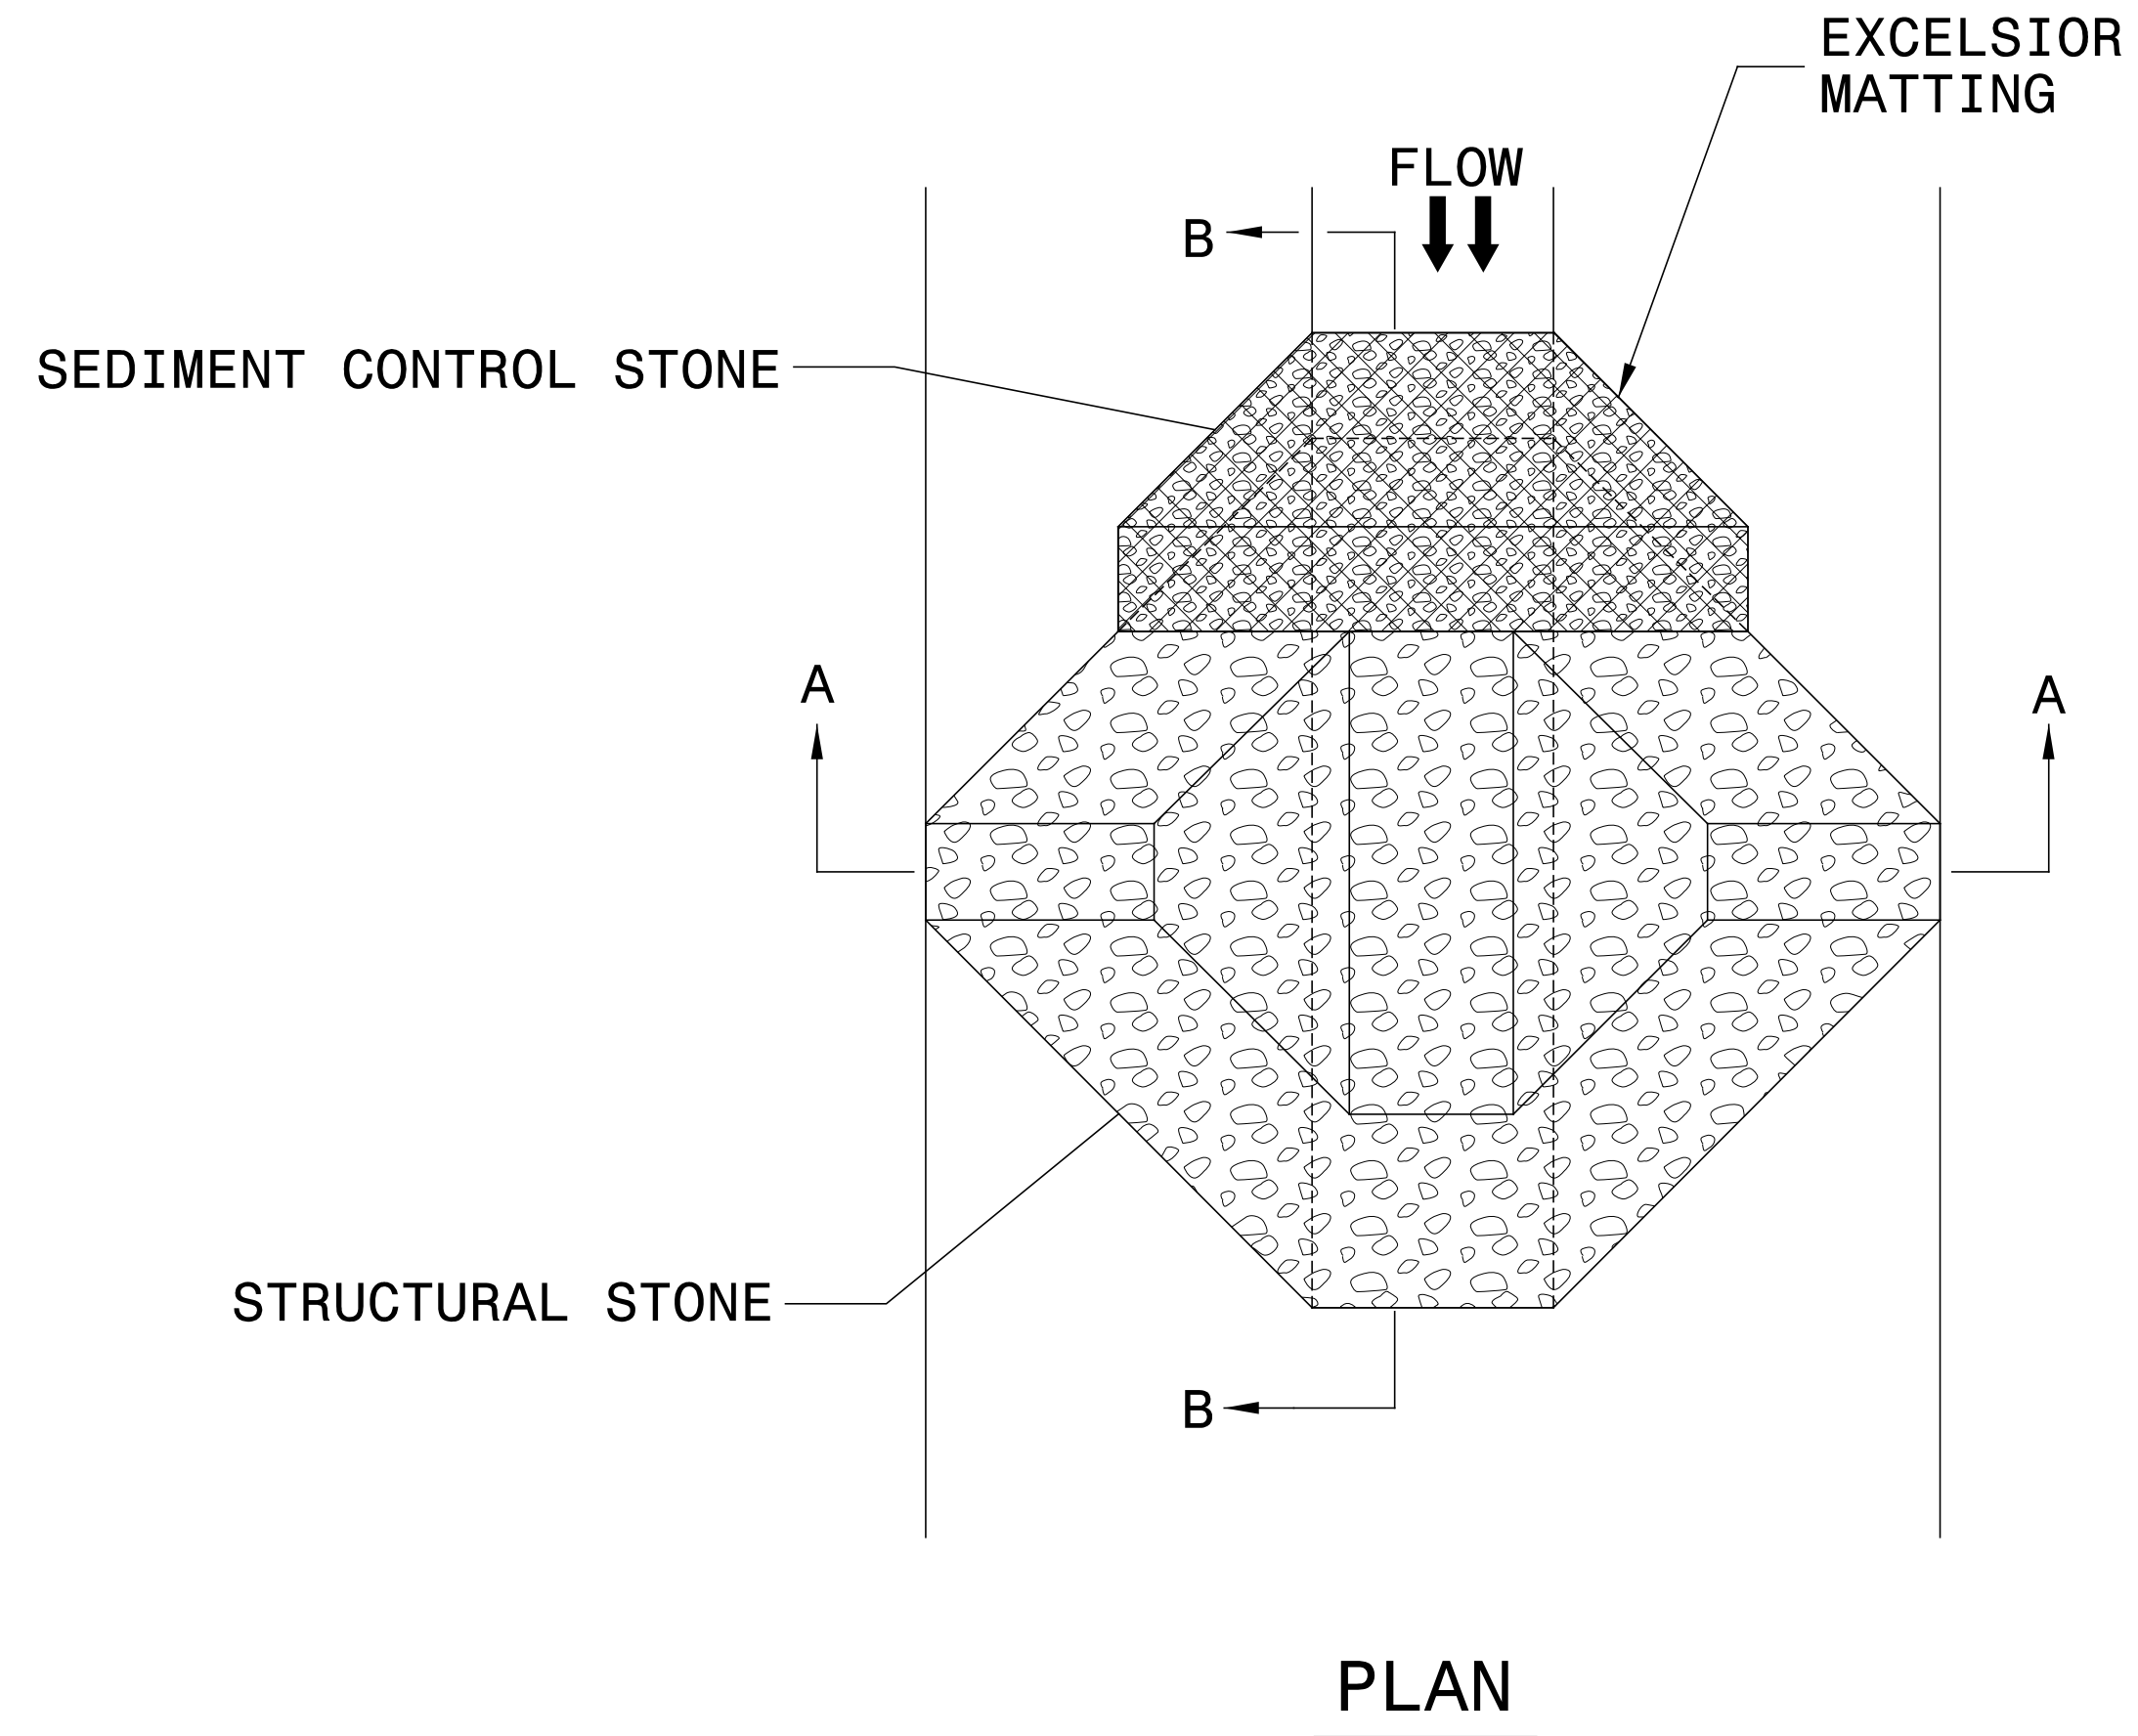




## NOTES:

INSTALL TEMPORARY ROCK SILT CHECK TYPE A IN ACCORDANCE WITH ROADWAY STANDARD DRAWING NO. 1633.01.

USE EXCELSIOR FOR MATTING MATERIAL AND ANCHOR MATTING SECTION AT TOP AND BOTTOM WITH CLASS B STONE.

PRIOR TO POLYACRYLAMIDE (PAM) APPLICATION, OBTAIN A SOIL SAMPLE FROM PROJECT LOCATION, AND FROM OFFSITE MATERIAL, AND ANALYZE FOR APPROPRIATE PAM FLOCCULANT TO BE APPLIED TO EACH ROCK SILT CHECK.

INITIALLY APPLY 4 OUNCES OF POLYACRYLAMIDE (PAM) TO TOP OF MATTING SECTION AND AFTER EVERY RAINFALL EVENT THAT EQUALS OR EXCEEDS 0.50 INCHES.

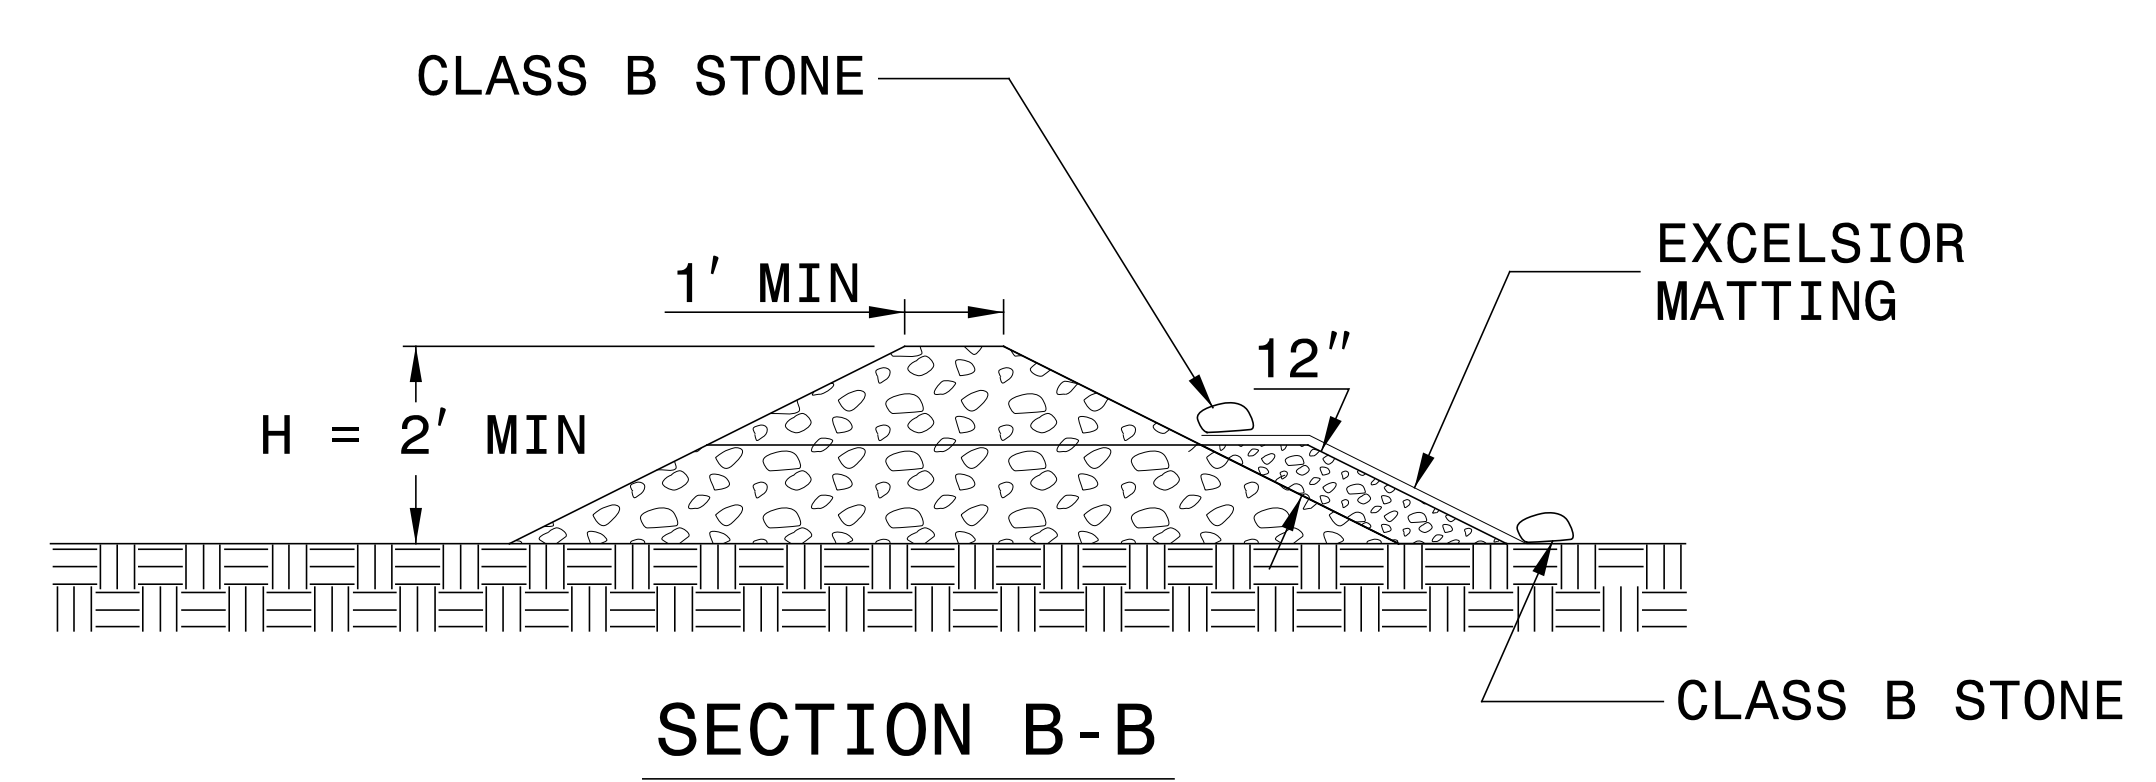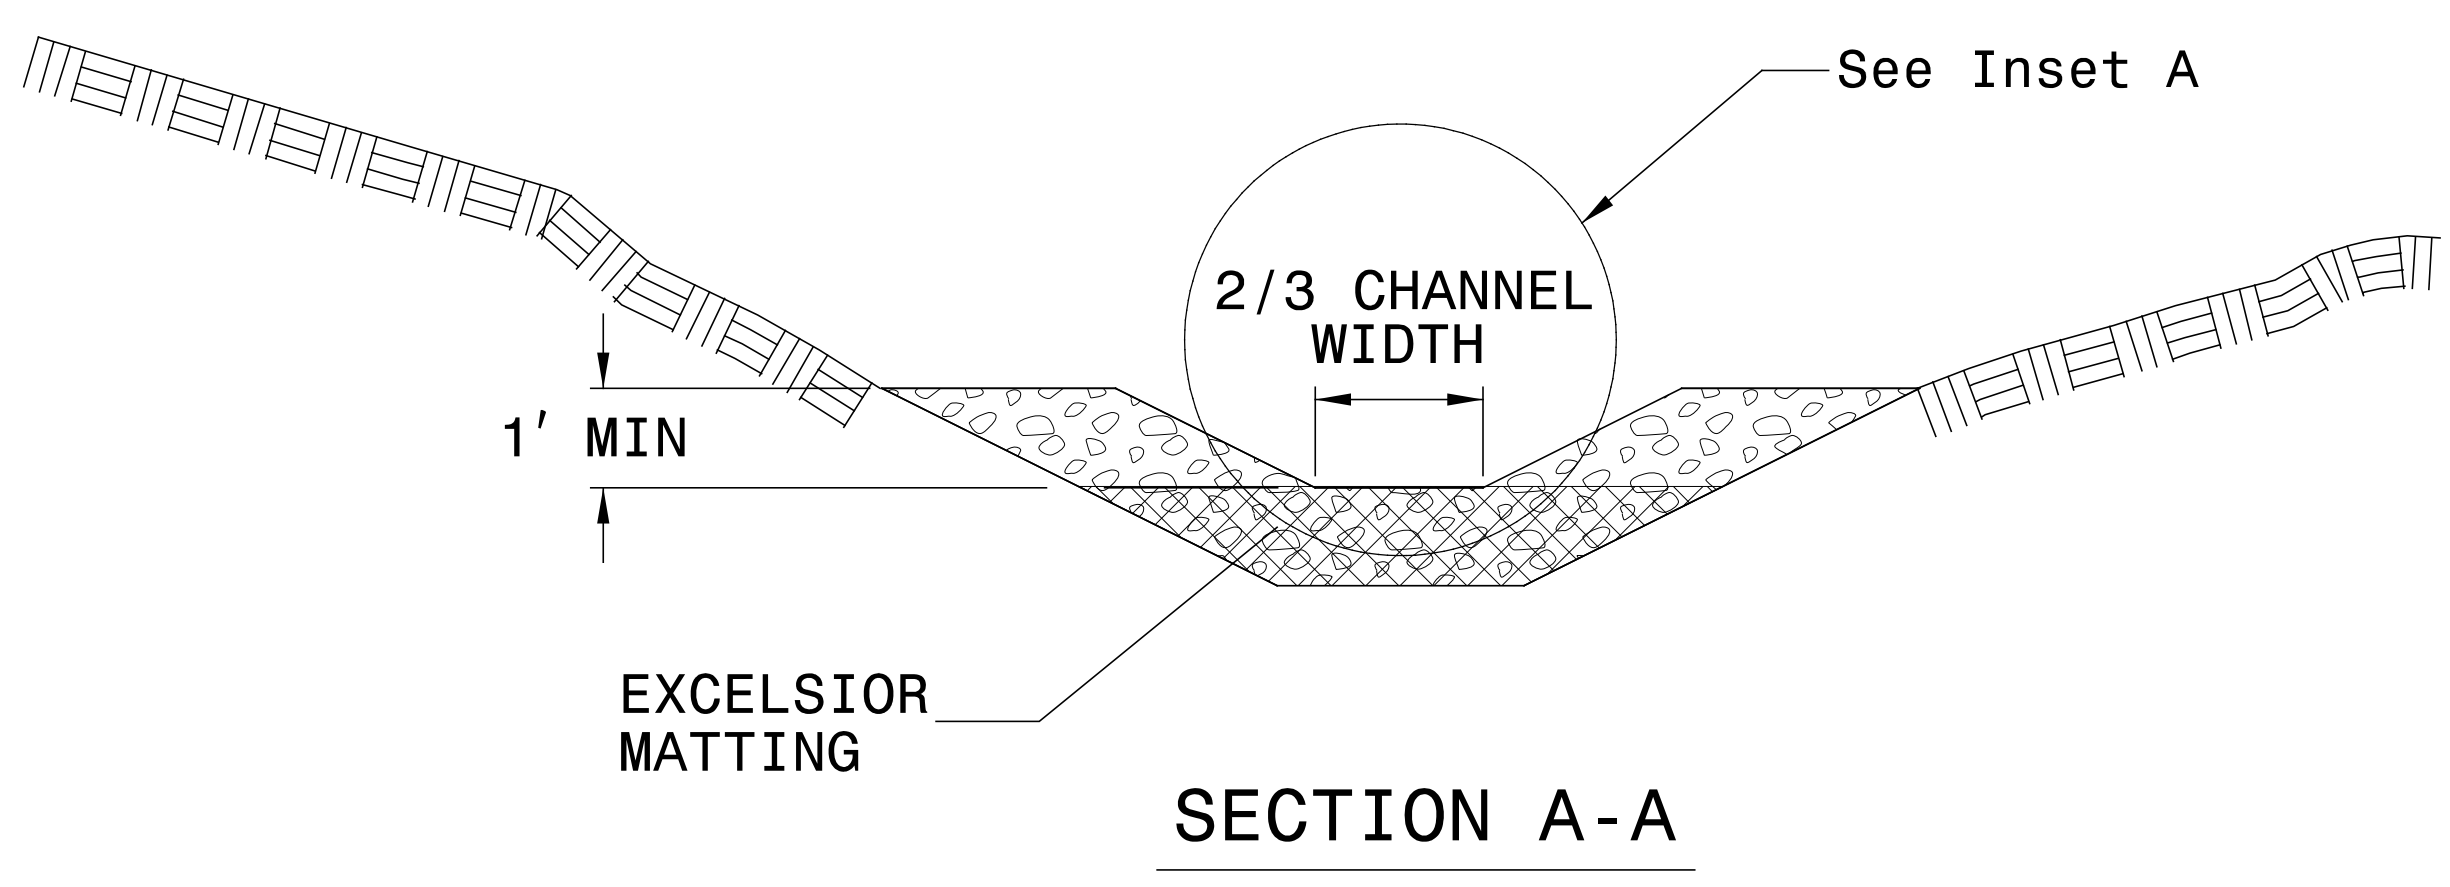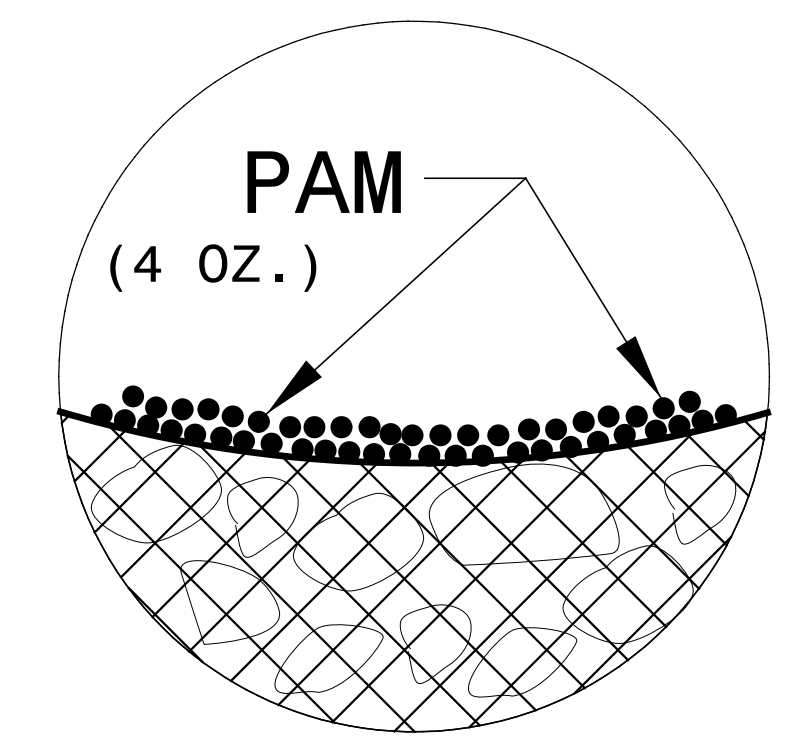



NOT TO SCALE

DIVISION OF HIGHWAYS  
STATE OF NORTH CAROLINA

SOIL STABILIZATION TIMEFRAMES


SITE DESCRIPTION	STABILIZATION TIME	TIMEFRAME EXCEPTIONS
PERIMETER DIKES, SWALES, DITCHES AND SLOPES	7 DAYS	NONE
HIGH QUALITY WATER (HQW) ZONES	7 DAYS	NONE
SLOPES STEEPER THAN 3:1	7 DAYS	IF SLOPES ARE 10' OR LESS IN LENGTH AND ARE NOT STEEPER THAN 2:1, 14 DAYS ARE ALLOWED.
SLOPES 3:1 OR FLATTER	14 DAYS	7 DAYS FOR SLOPES GREATER THAN 50' IN LENGTH.
ALL OTHER AREAS WITH SLOPES FLATTER THAN 4:1	14 DAYS	NONE, EXCEPT FOR PERIMETERS AND HQW ZONES.



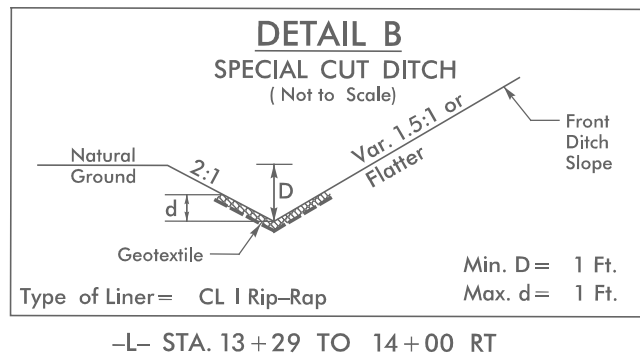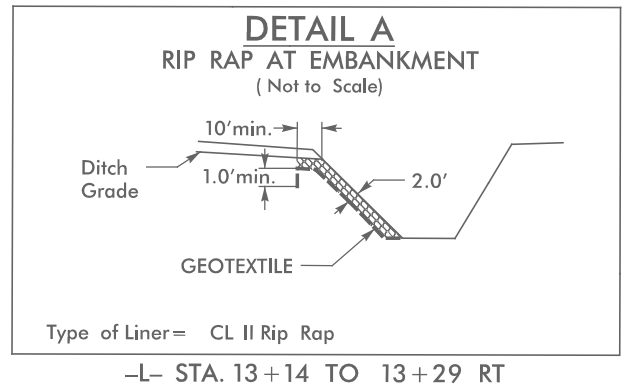

CLEARING AND GRUBBING  
EROSION CONTROL FOR  
CONSTRUCTION SHEET 04

PROJECT REFERENCE	SHEET NO.
17BP.7.R.94 - ORANGE 51	EC-04/CONST.04
ROADSIDE ENVIRONMENTAL PROJECT ENGINEER	
LEVEL III CERTIFIED BY: ALEXANDER D. SNIDER, PE CERTIFICATION NUMBER: 3064 ISSUED: JANUARY 30, 2018	
Prepared in the Office of:	MOTT MACDONALD PO Box 700 Fuquay-Varina, NC 27526 www.mottmac.com/americas
HDR Engineering, Inc. of the Carolinas 555 Fayetteville St., Suite 900, Raleigh, NC 27601 N.C. B.E.L.S. License Number: F-0110	
VERTICAL SCALE 5' 0 5' 10'	HORIZONTAL SCALE 25' 0 25' 50'

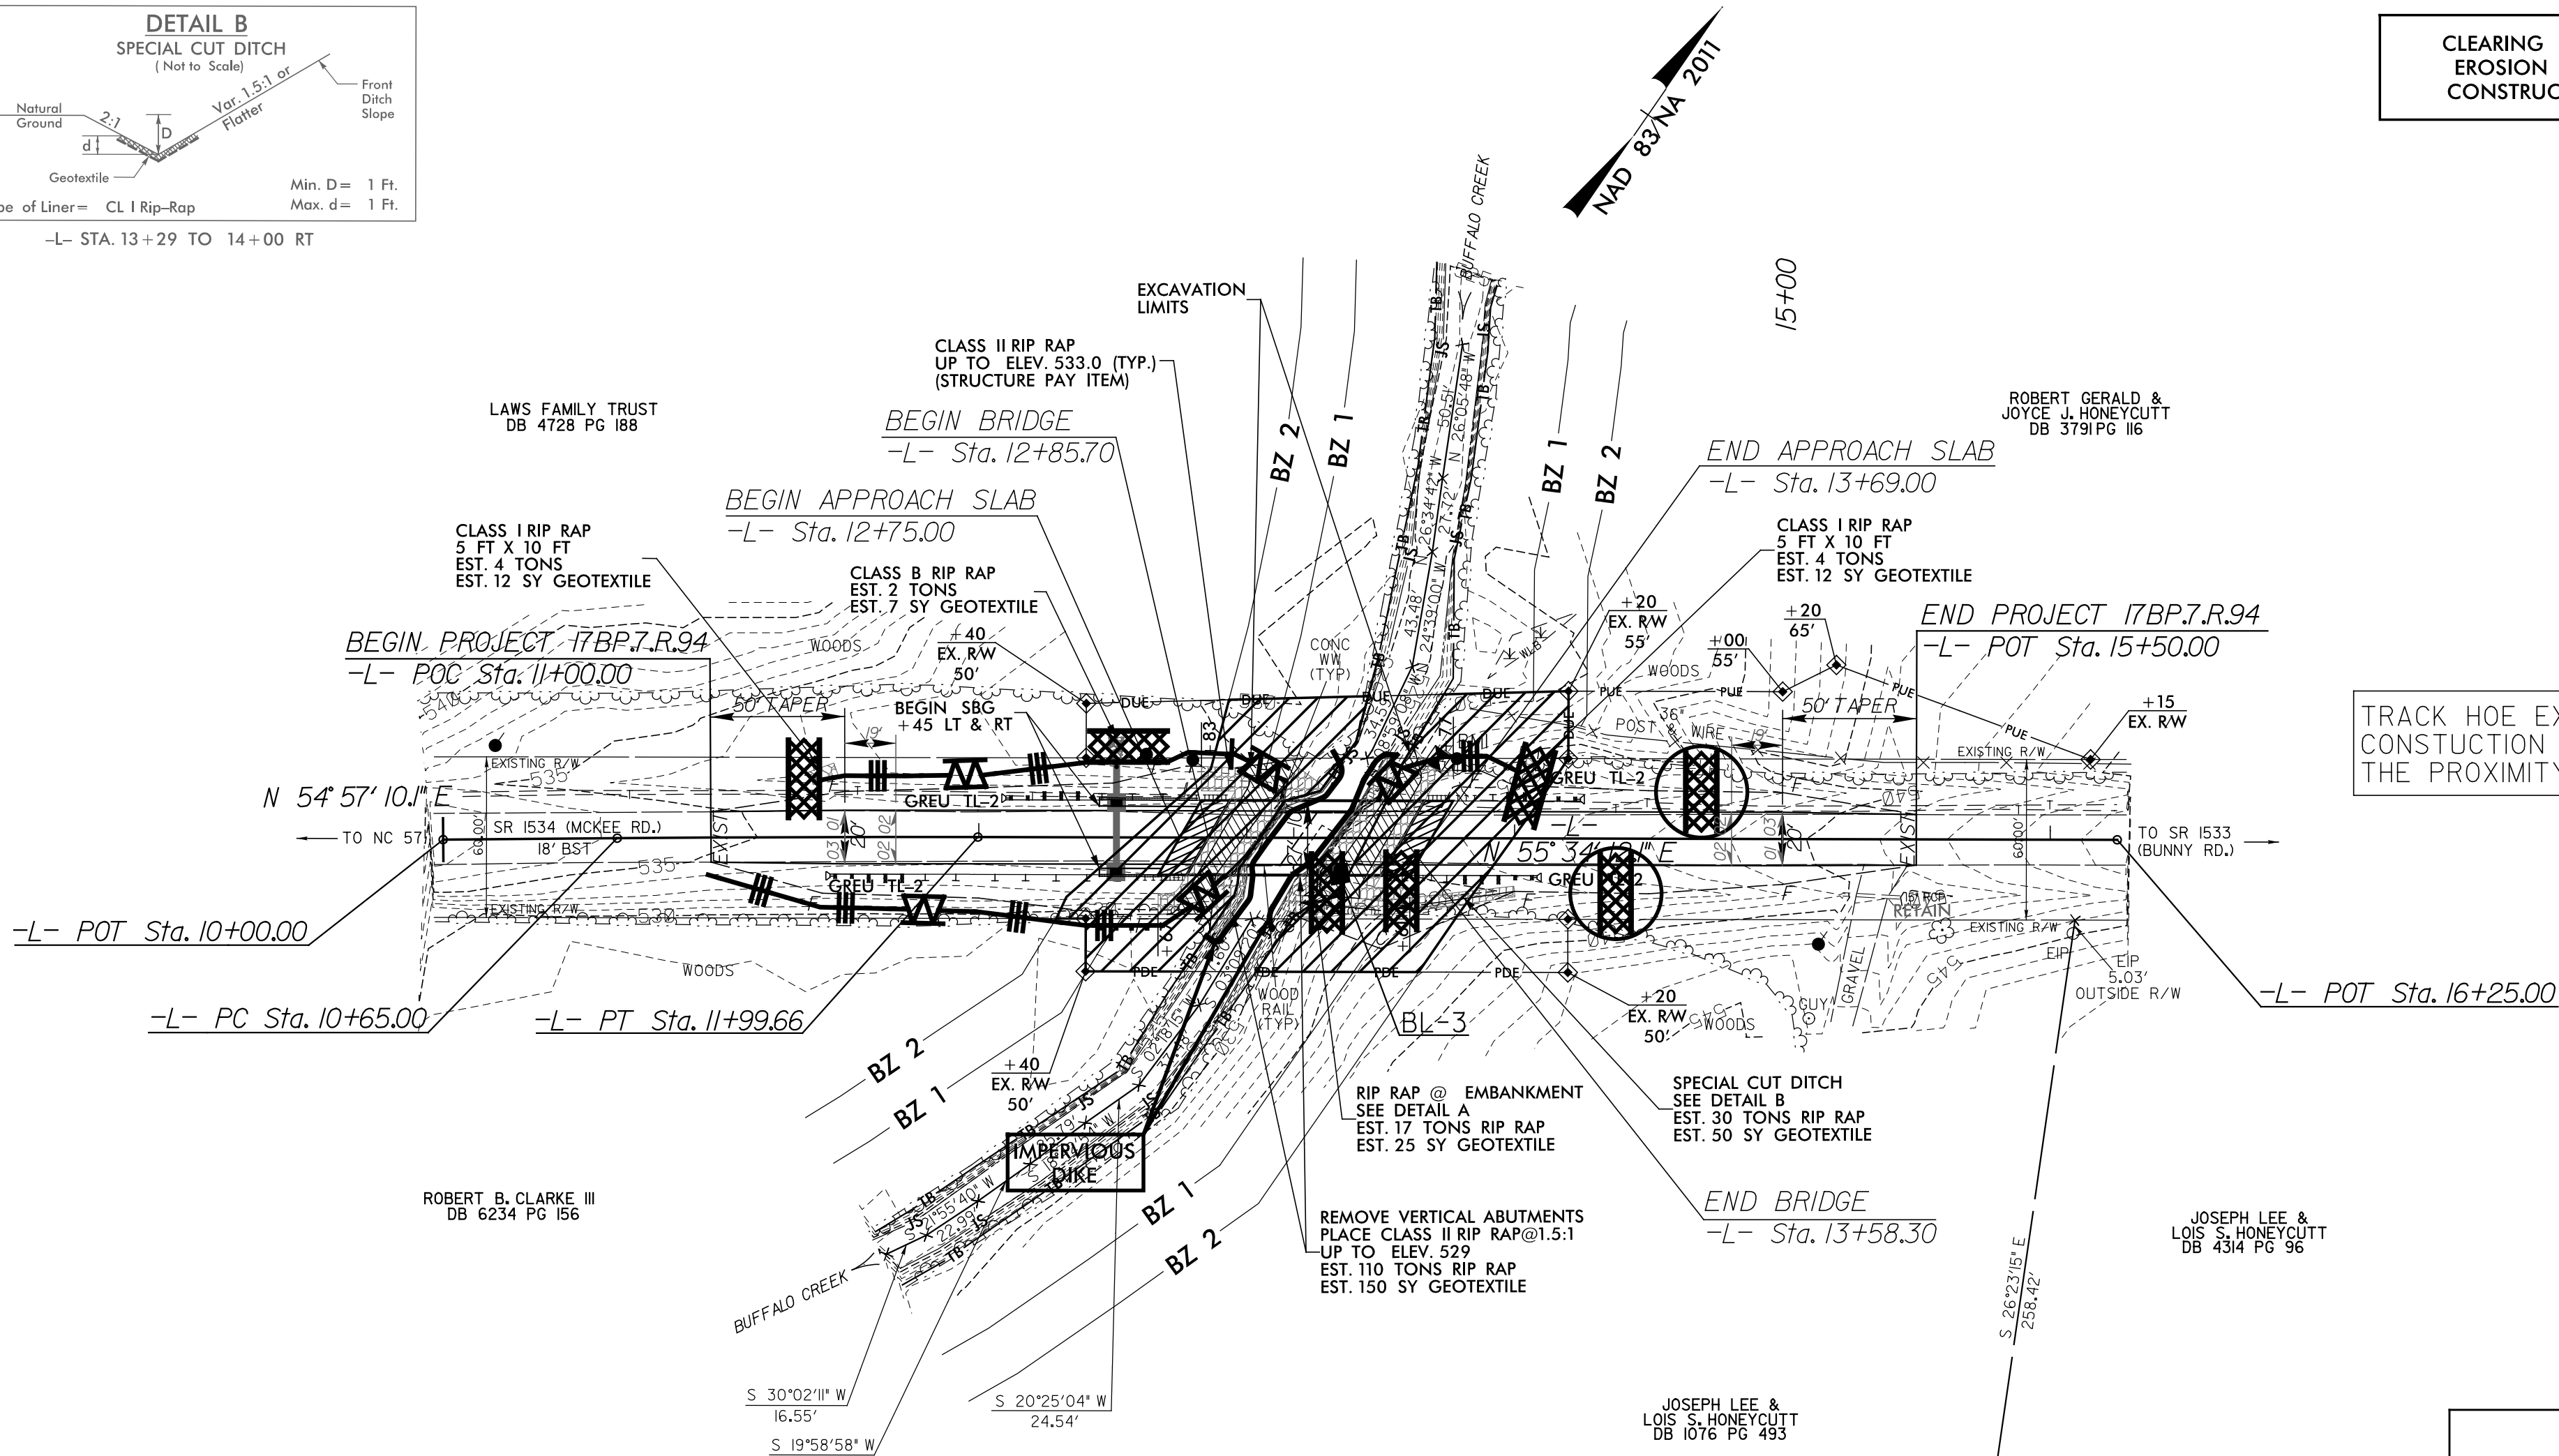


TRACK HOE EXCAVATOR SHALL BE USED FOR  
CONSTRUCTION IN LIEU OF A CRANE DUE TO  
THE PROXIMITY OF OVERHEAD POWER LINES

NOTE:  
ALL EROSION CONTROL DEVICES SHOWN ARE  
LOCATED WITHIN EXISTING RW OR EASMENT.


NOTE:  
PERIMETER EROSION CONTROL MEASURES SHALL BE  
INSTALLED DURING CLEARING AND GRUBBING PHASE.

NOTE:  
PLACE TEMPORARY ROCK SEDIMENT DAMS TYPE - B  
AND TEMPORARY ROCK SILT CHECKS TYPE - A AT  
DRAINAGE OUTLETS.



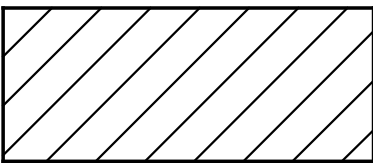


ENVIRONMENTALLY SENSITIVE AREA  
SEE PROJECT SPECIAL PROVISIONS

DATE: 08/14/15  
J:\Hydro\DDC\Orange\051\Hydraulics\Erosion Control\cadd\670051\_hyd\_ec\_c&g\_psh.dgn  
ICA ENGINEERING, INC.

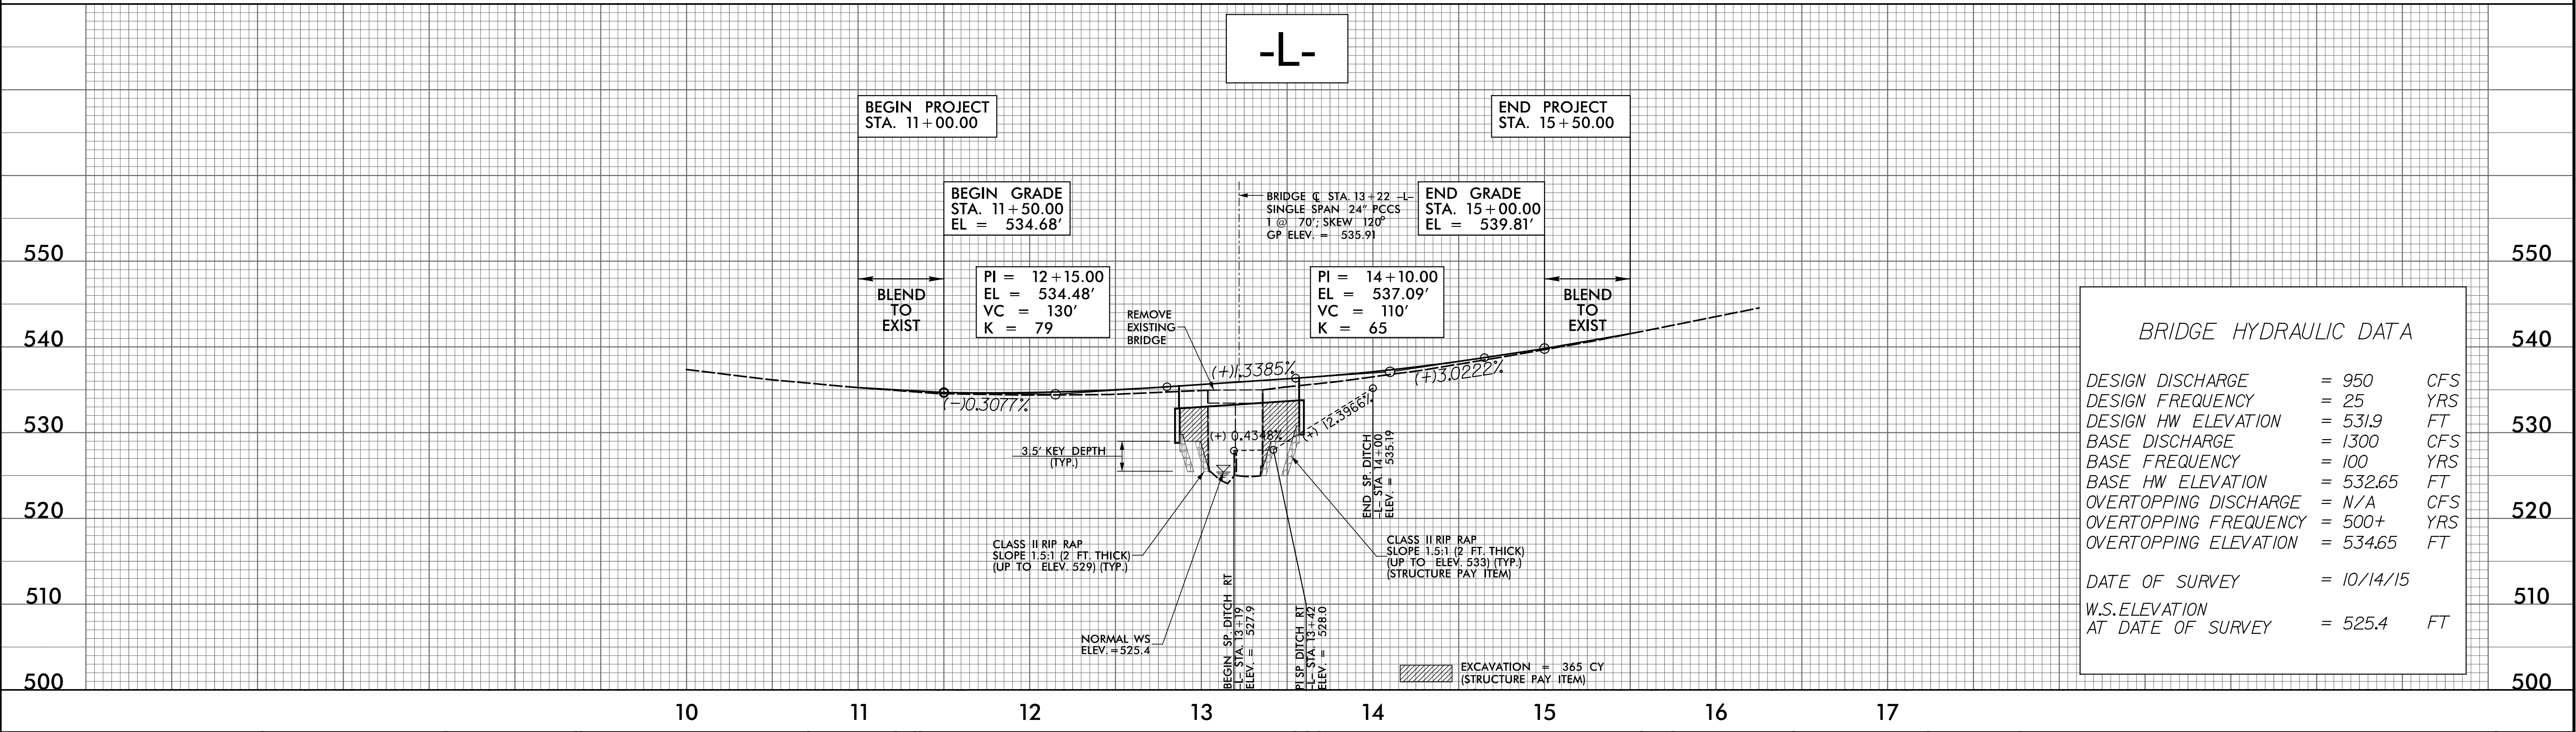


BRIDGE HYDRAULIC DATA		
DESIGN DISCHARGE	= 950	CFS
DESIGN FREQUENCY	= 25	YRS
DESIGN HW ELEVATION	= 531.9	FT
BASE DISCHARGE	= 1300	CFS
BASE FREQUENCY	= 100	YRS
BASE HW ELEVATION	= 532.65	FT
OVERTOPPING DISCHARGE	= N/A	CFS
OVERTOPPING FREQUENCY	= 500+	YRS
OVERTOPPING ELEVATION	= 534.65	FT
DATE OF SURVEY	= 10/14/15	
W.S.ELEVATION AT DATE OF SURVEY	= 525.4	FT

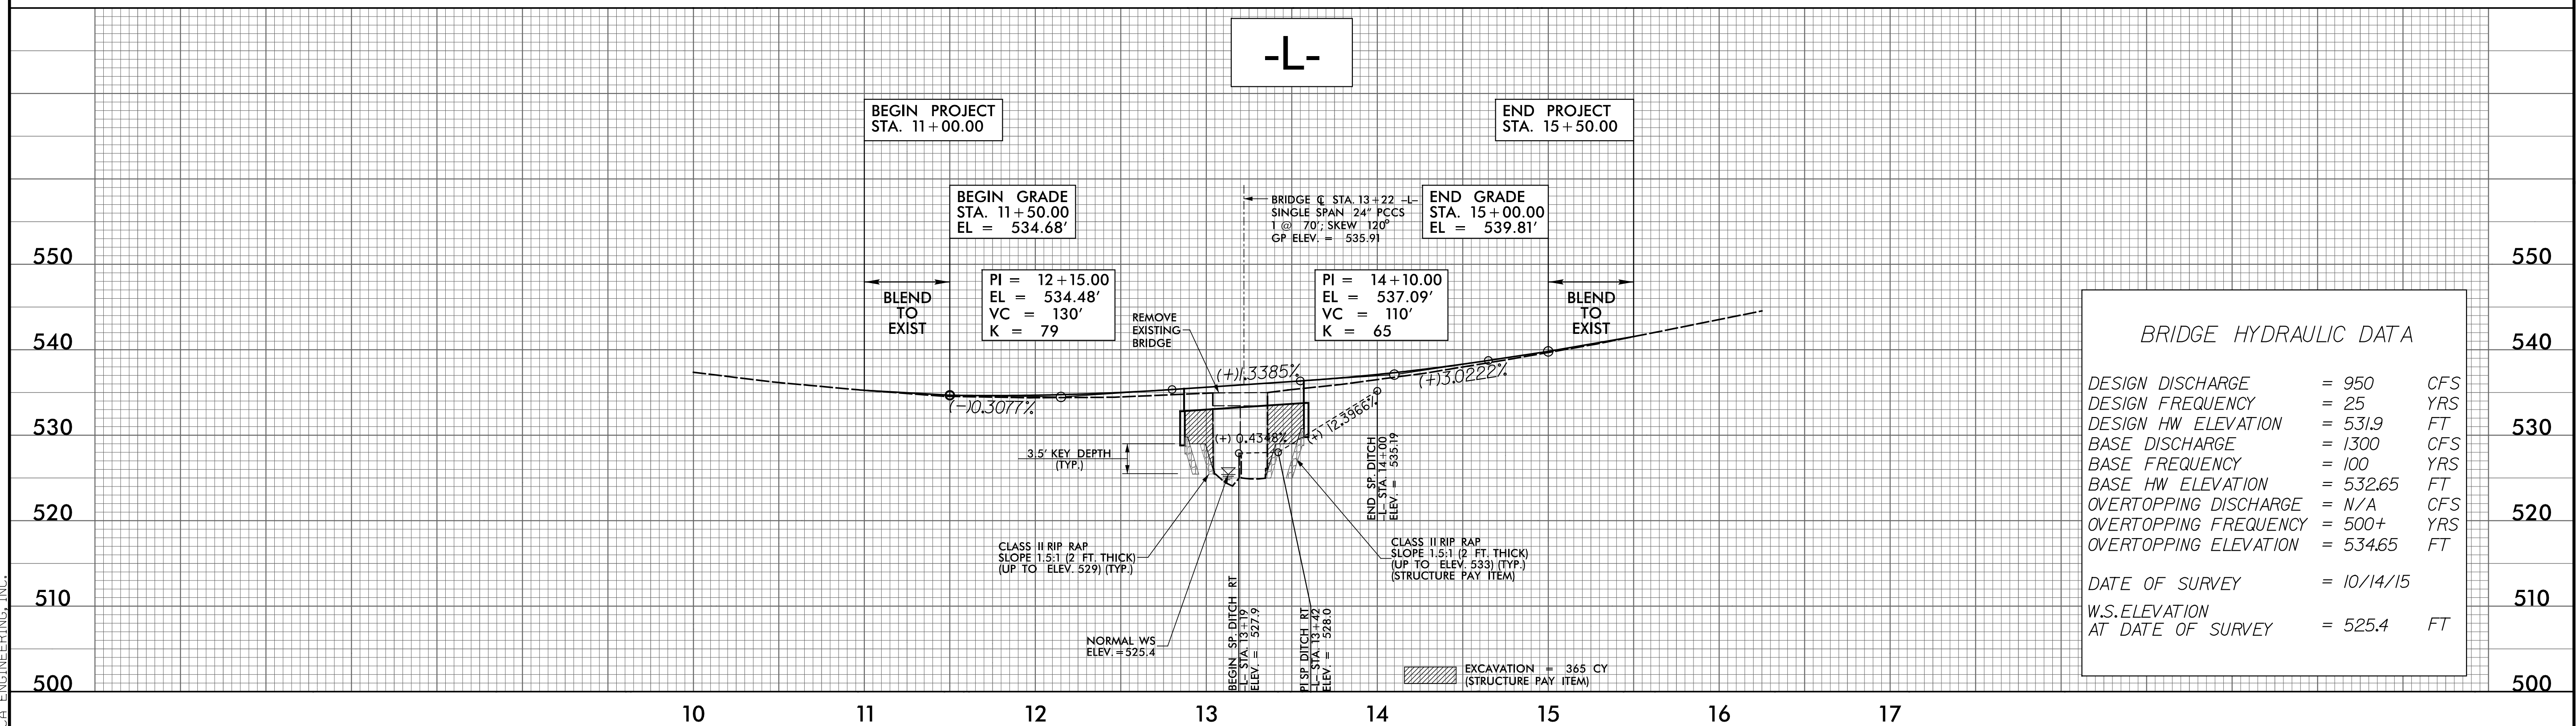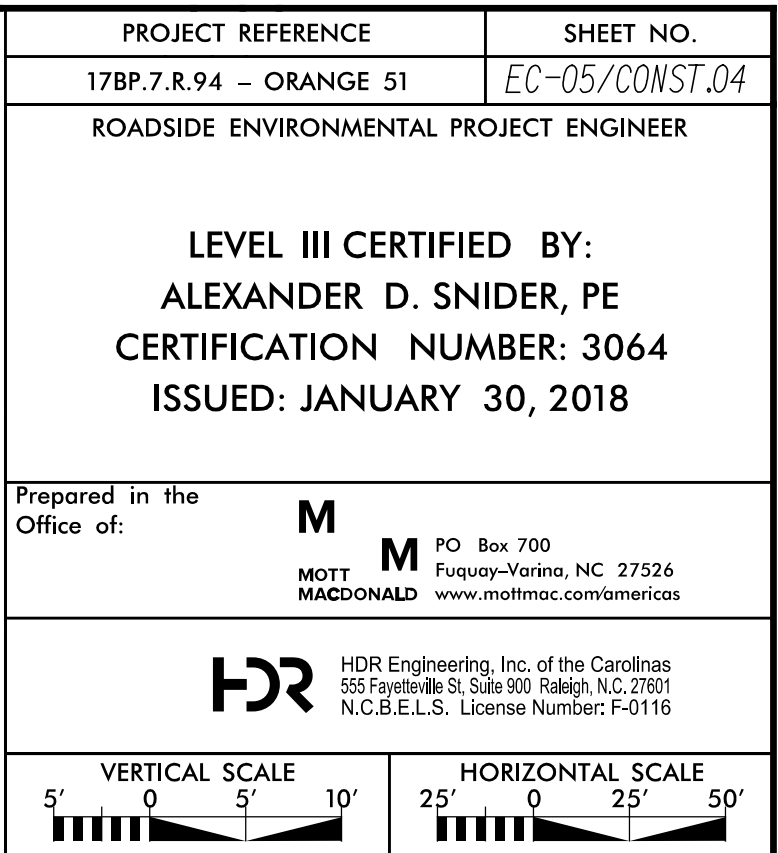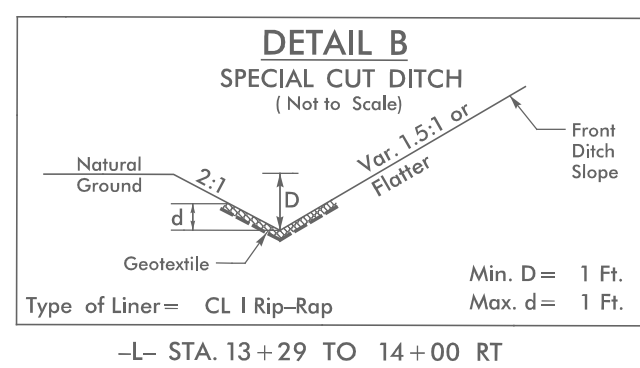


PLANTING DETAILS  
SEEDLING / LINER BAREROOT PLANTING DETAIL

HEALING IN


1. Locate a healing-in site in a shady, well protected area.  
2. Excavate a flat bottom trench 12 inches deep and provide drainage.

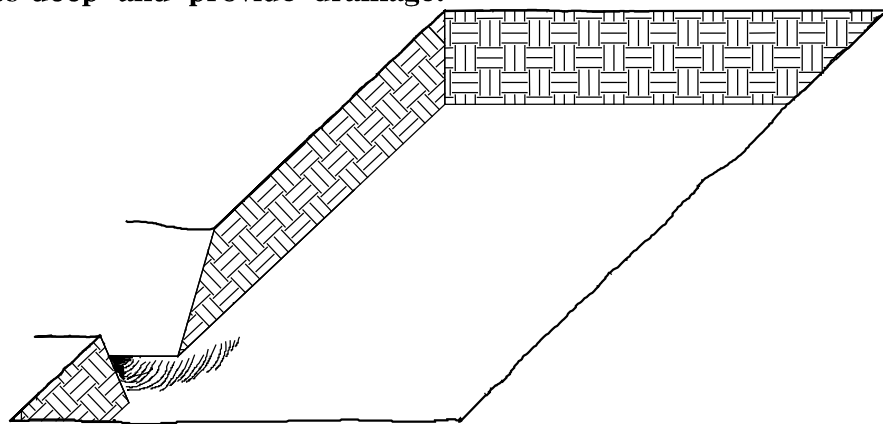


3. Backfill the trench with 2 inches well rotted sawdust. Place a 2 inch layer of well rotted sawdust at a sloping angle at one end of the trench.

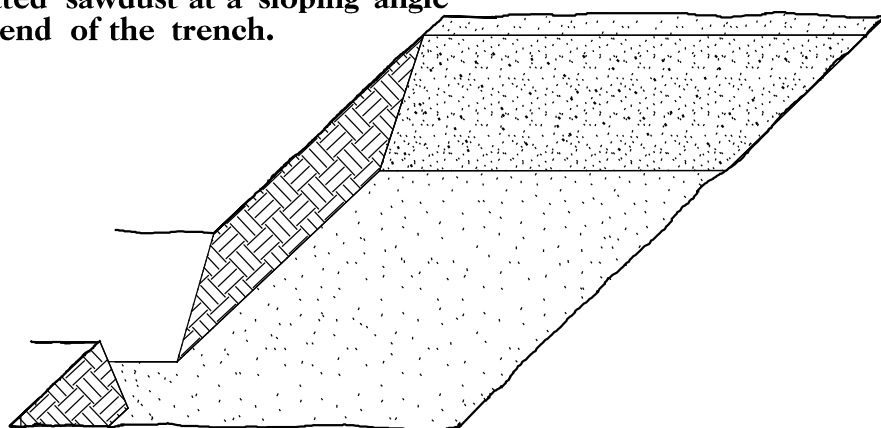

4. Place a single layer of plants against the sloping end so that the root collar is at ground level.

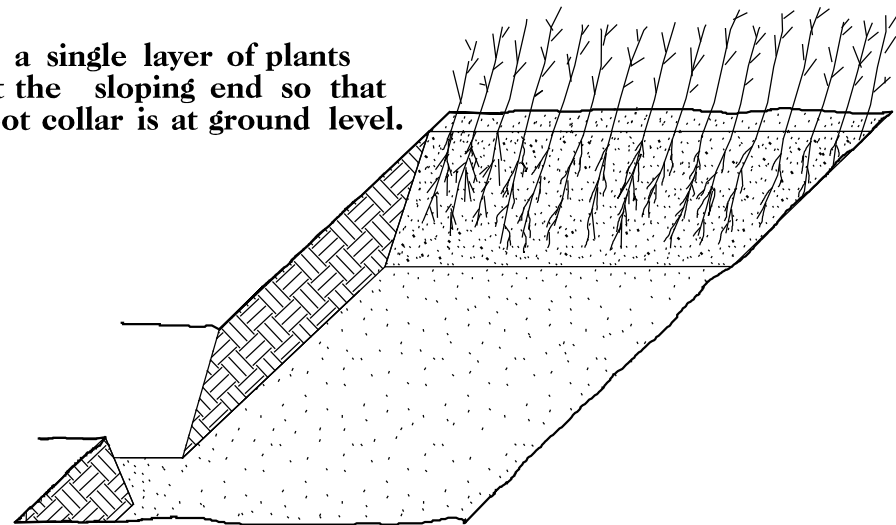


5. Place a 2 inch layer of well rotted sawdust over the roots maintaining a sloping angle.

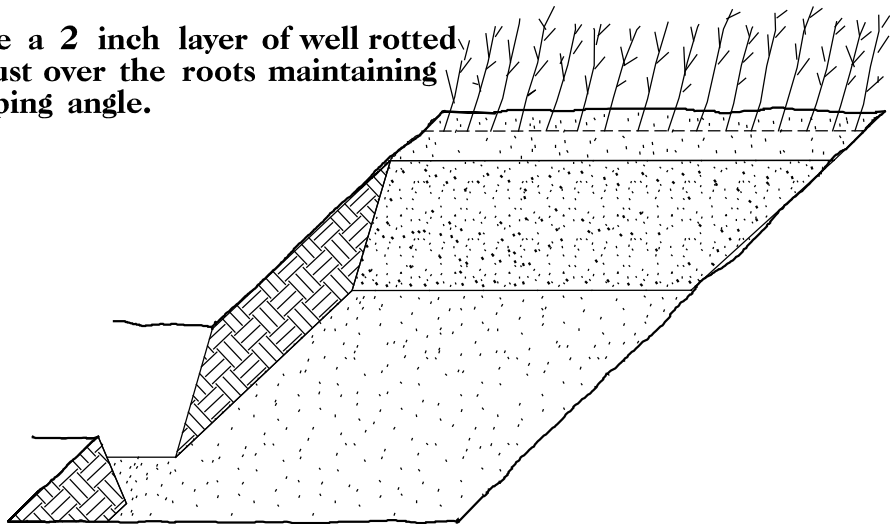


6. Repeat layers of plants and sawdust as necessary and water thoroughly.


DIBBLE PLANTING METHOD  
USING THE KBC PLANTING BAR

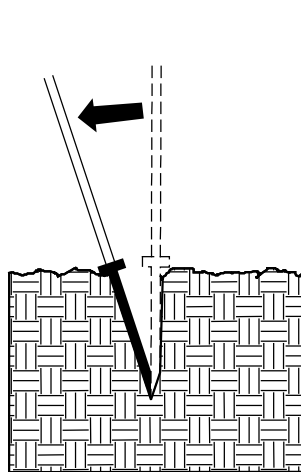


1. Insert planting bar as shown and pull handle toward planter.

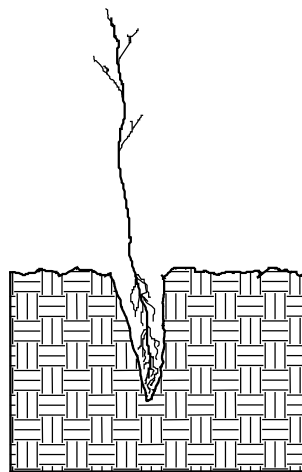


2. Remove planting bar and place seedling at correct depth.

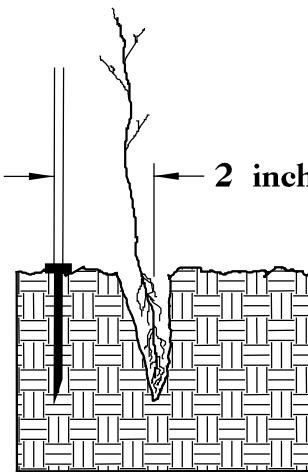


3. Insert planting bar 2 inches toward planter from seedling.

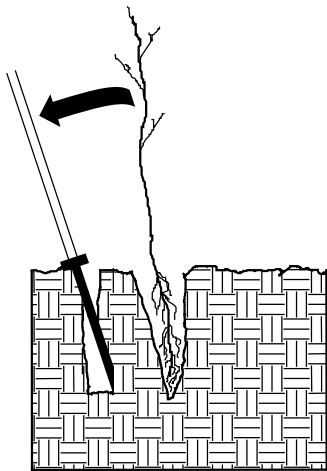

4. Pull handle of bar toward planter, firming soil at bottom.

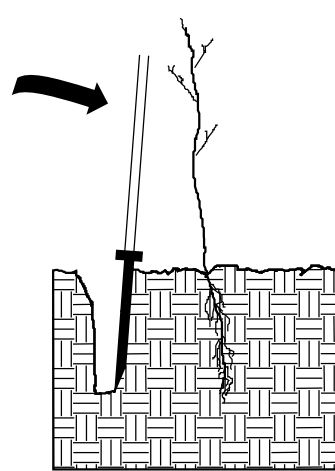

5. Push handle forward firming soil at top.

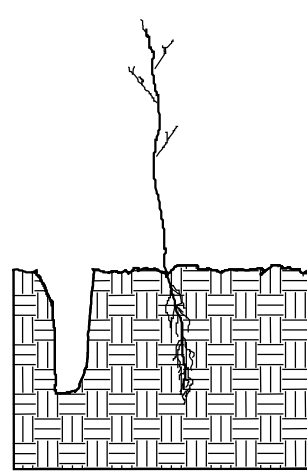


6. Leave compaction hole open. Water thoroughly.

PLANTING NOTES:

**PLANTING BAG**  
During planting, seedlings shall be kept in a moist canvas bag or similar container to prevent the root systems from drying.



**KBC PLANTING BAR**  
Planting bar shall have a blade with a triangular cross section, and shall be 12 inches long, 4 inches wide and 1 inch thick at center.

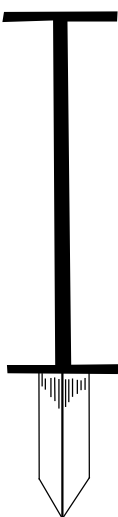

**ROOT PRUNING**  
All seedlings shall be root pruned, if necessary, so that no roots extend more than 10 inches below the root collar.

REFORESTATION

- ☐ TREE REFORESTATION SHALL BE PLANTED 6 FT. TO 10 FT. ON CENTER, RANDOM SPACING, AVERAGING 8 FT. ON CENTER, APPROXIMATELY 680 PLANTS PER ACRE.

REFORESTATION



MIXTURE, TYPE, SIZE, AND FURNISH SHALL CONFORM TO THE FOLLOWING:

25%	LIRIODENDRON TULIPIFERA	TULIP POPLAR	12 in - 18 in BR
25%	PLATANUS OCCIDENTALIS	AMERICAN SYCAMORE	12 in - 18 in BR
25%	FRAXINUS PENNSYLVANICA	GREEN ASH	12 in - 18 in BR
25%	BETULA NIGRA	RIVER BIRCH	12 in - 18 in BR


REFORESTATION DETAIL SHEET

N.C.D.O.T. - ROADSIDE ENVIRONMENTAL UNIT



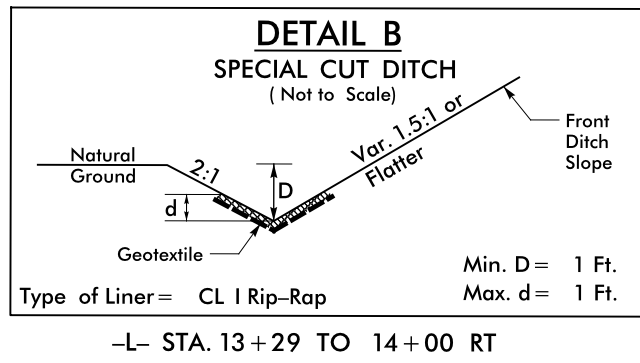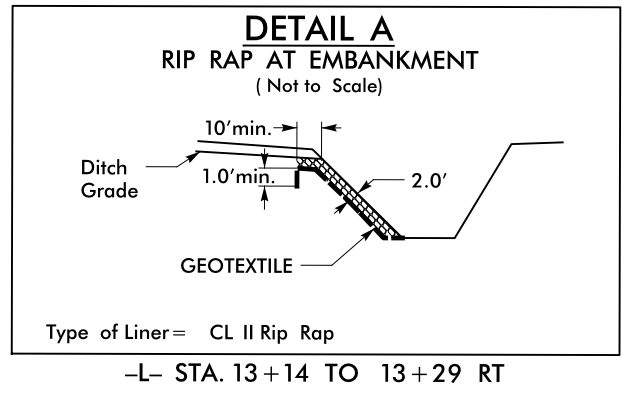

CENTURYLINK CABLES OUT OF SERVICE  
AND ARE ABANDONED IN PLACE ACCORD-  
ING TO UTILITY OWNER

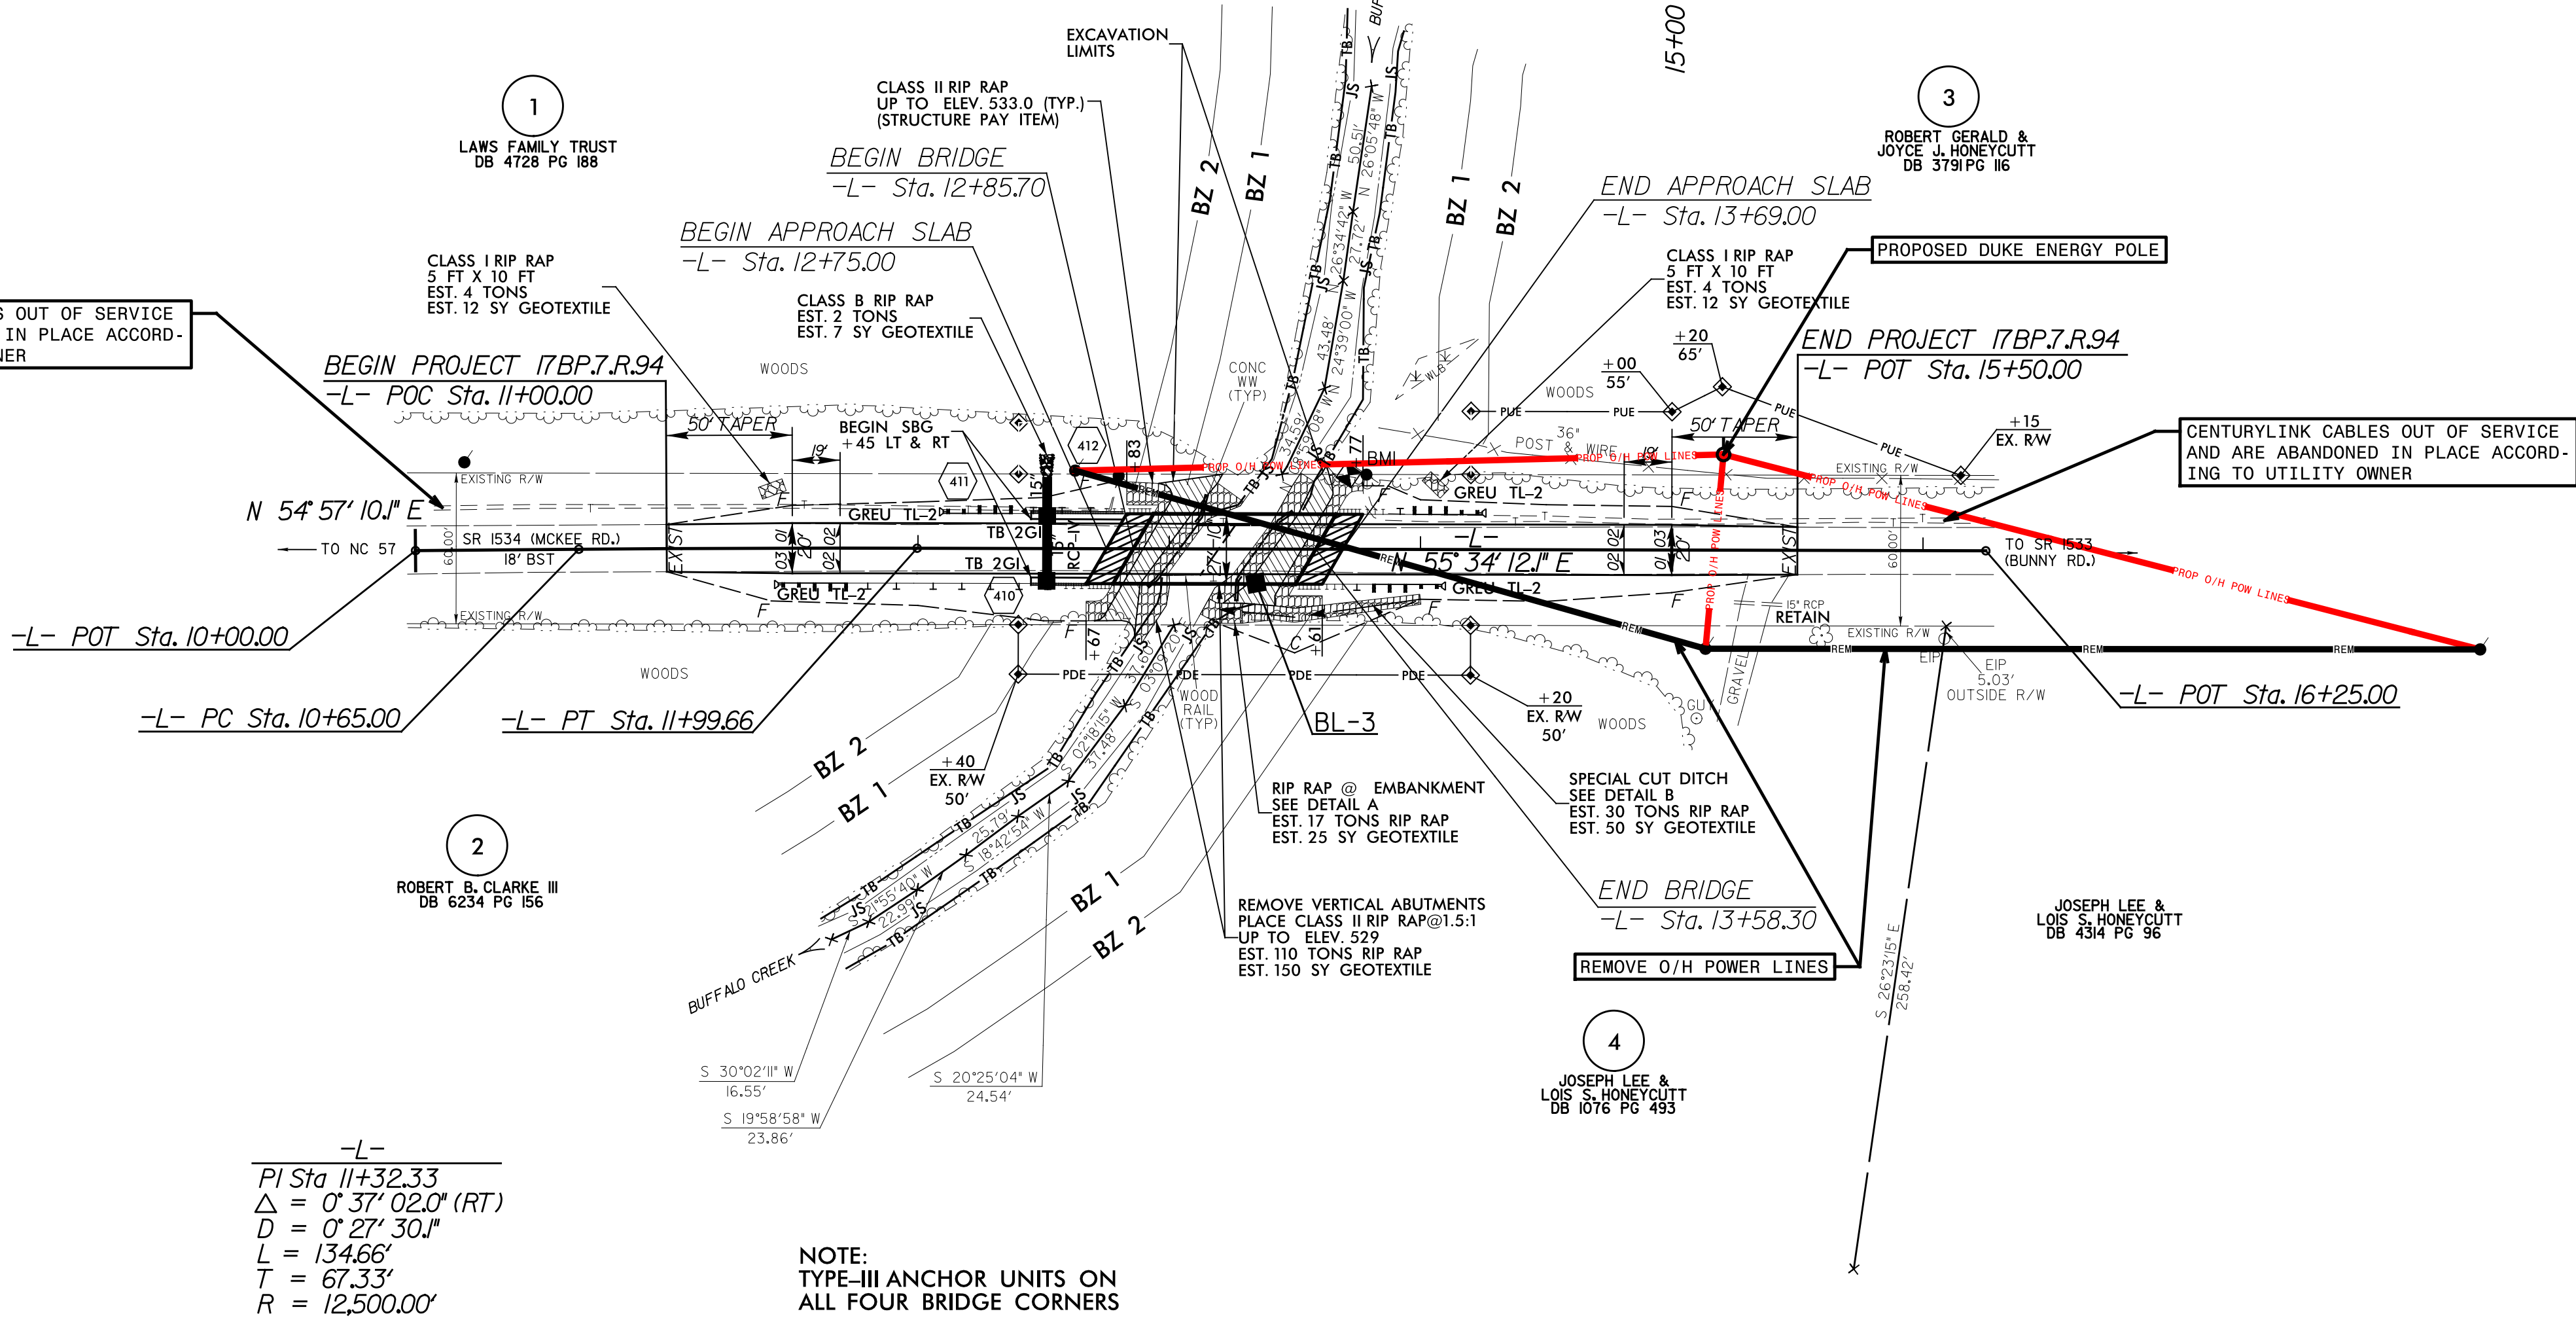

PROJECT REFERENCE	SHEET NO.
17BP.7.R.94 - ORANGE 51	UO-1

Prepared in the Office of:

**THE WOOTEN COMPANY**  
120 North Boylan Avenue Raleigh, NC 27603-1423  
919.828.0531 fax 919.834.3589  
License Number: F-0115

**DOCUMENT NOT CONSIDERED FINAL  
UNLESS ALL SIGNATURES COMPLETED**

GRAPHIC SCALE  
25' 0 25' 50'


UTILITIES BY OTHERS

NOTE:  
ALL PROPOSED UTILITY WORK  
SHOWN ON THIS SHEET WILL  
BE DONE BY OTHERS

670051-I


2/7/2018 8:05:31 AM  
R:\Roadway\Xsc\Xpl\670001\_rdy\_xpl.dgn  
0960103

	PROJECT REFERENCE	SHEET NO.
	17BP.7.R.94 – ORANGE 51	X-1

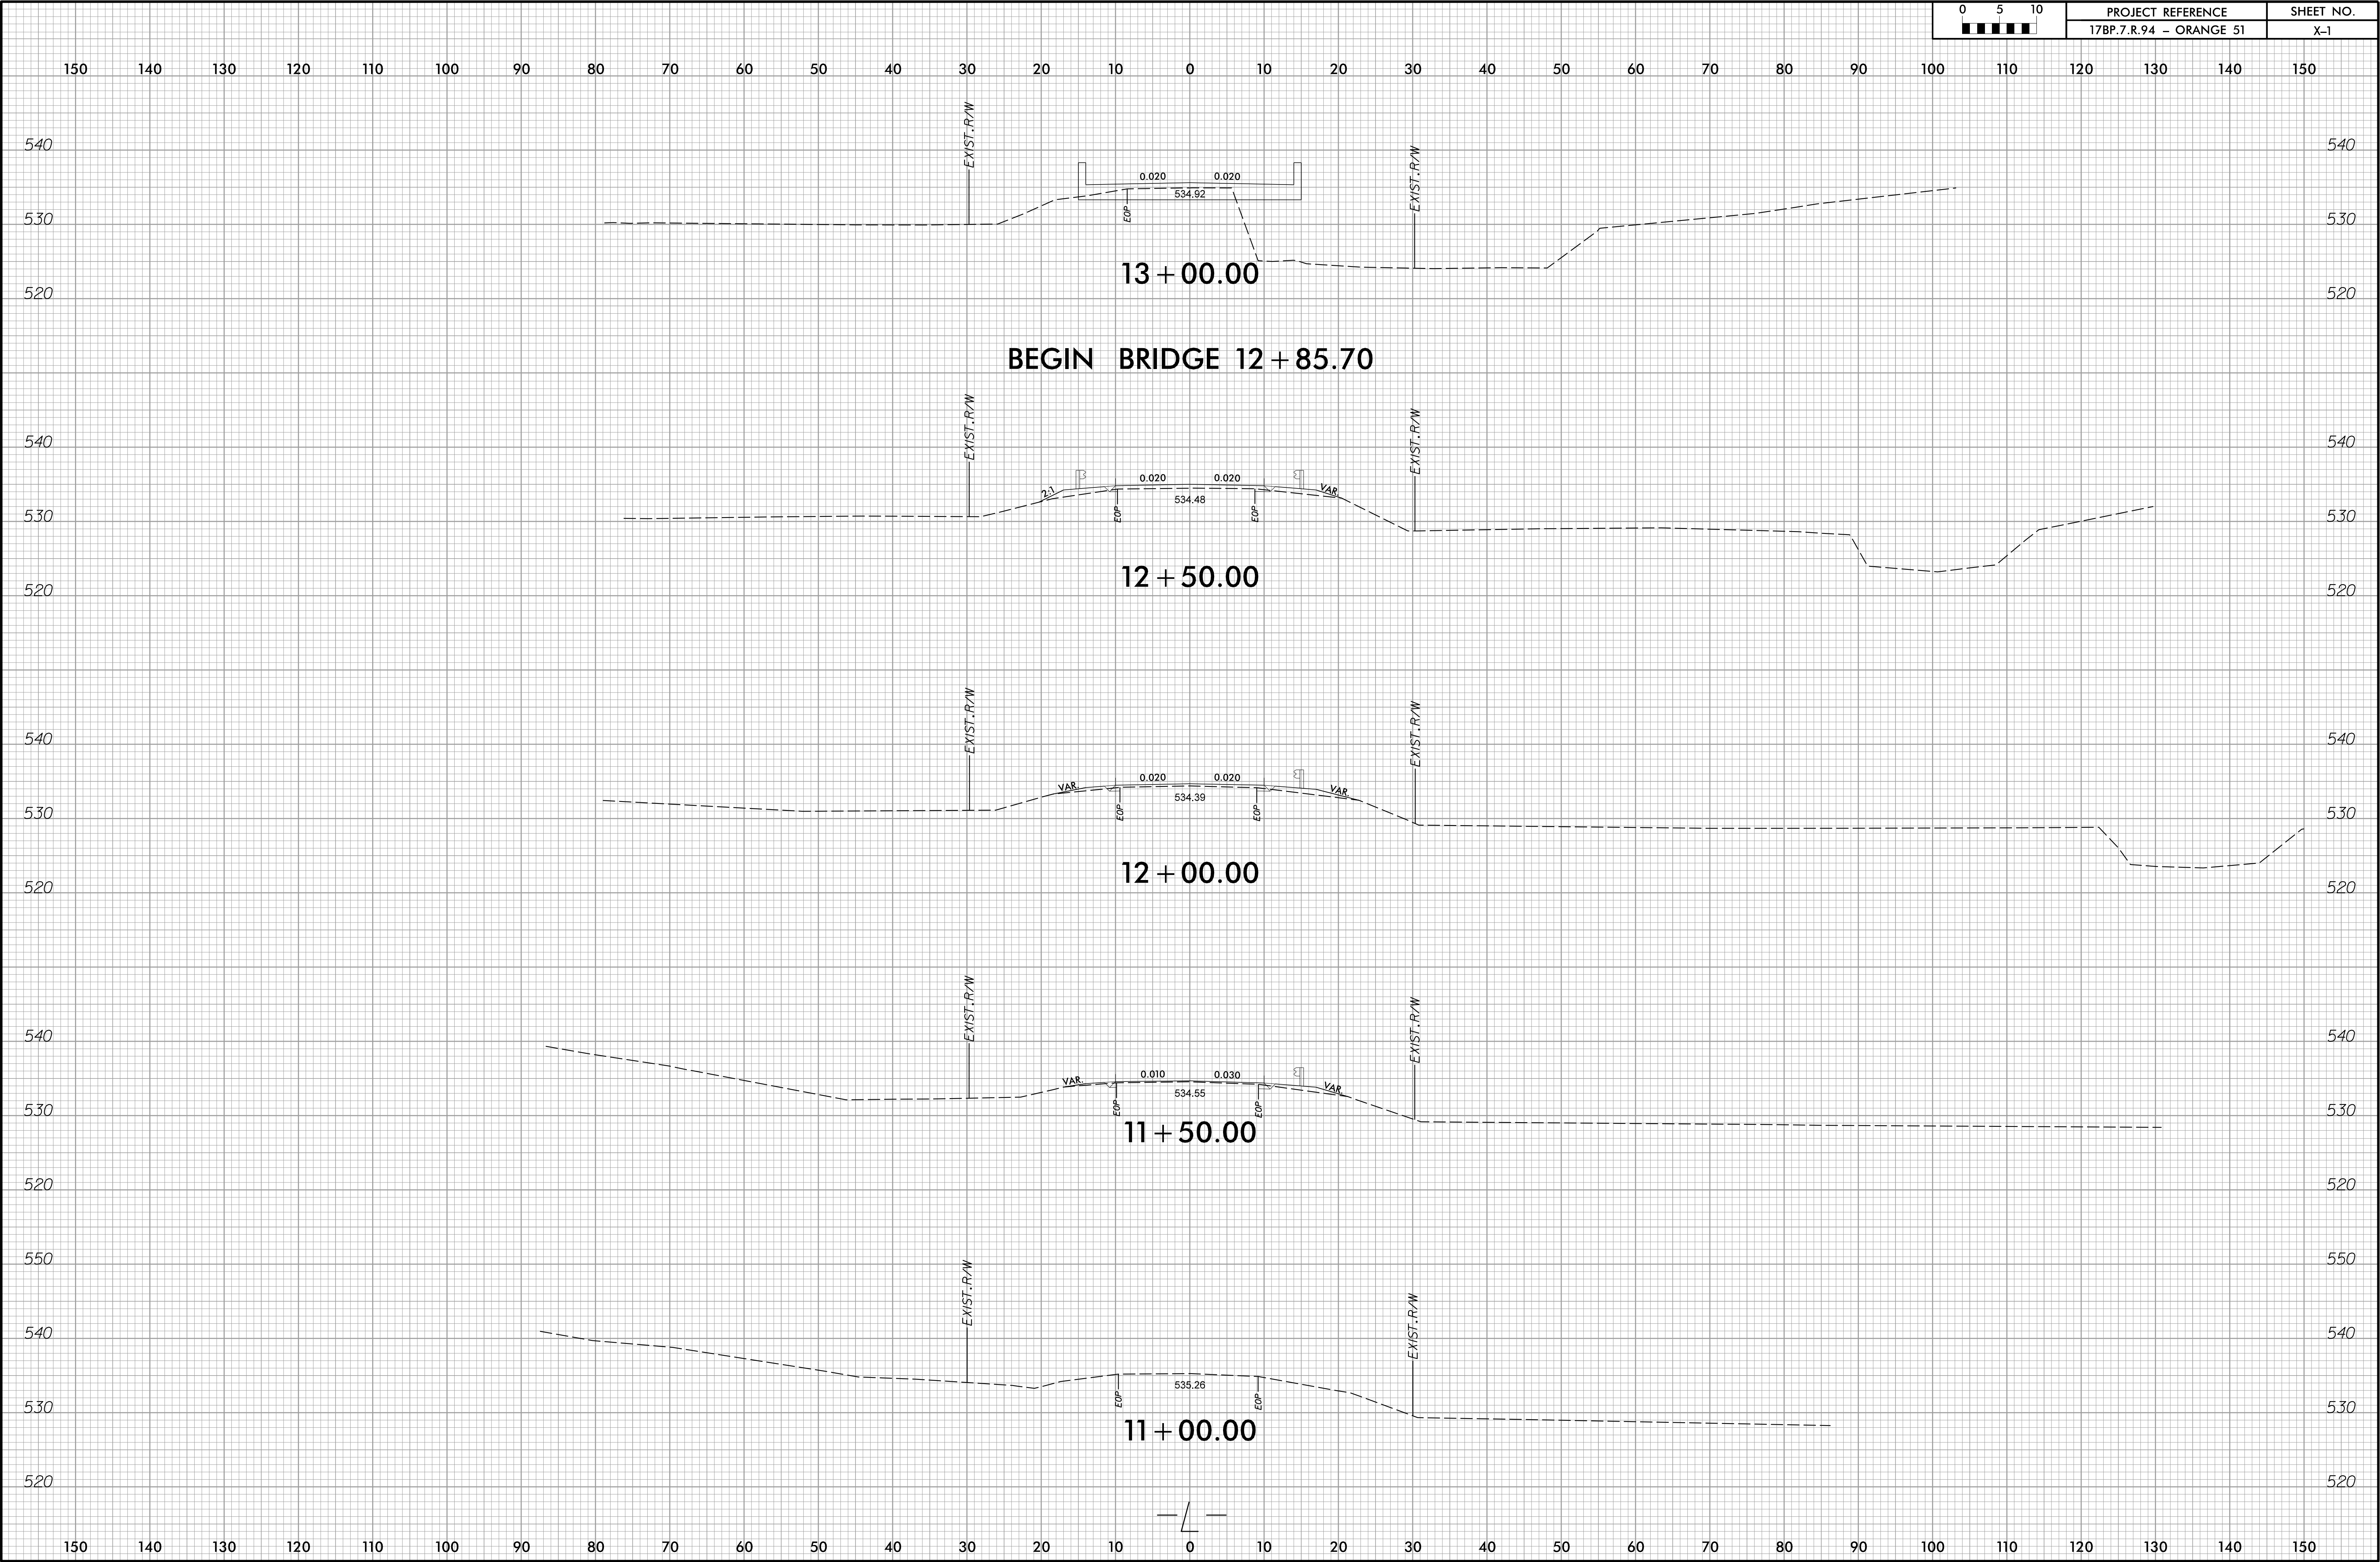


2/7/2018 8:05:32 AM  
R:\R\_Corridor\Xsc\Xpl\670001\_Fdy\_xpl.dgn  
0960103

0 5 10 ■■■■■	PROJECT REFERENCE	SHEET NO.
	17BP.7.R.94 - ORANGE 51	X-2

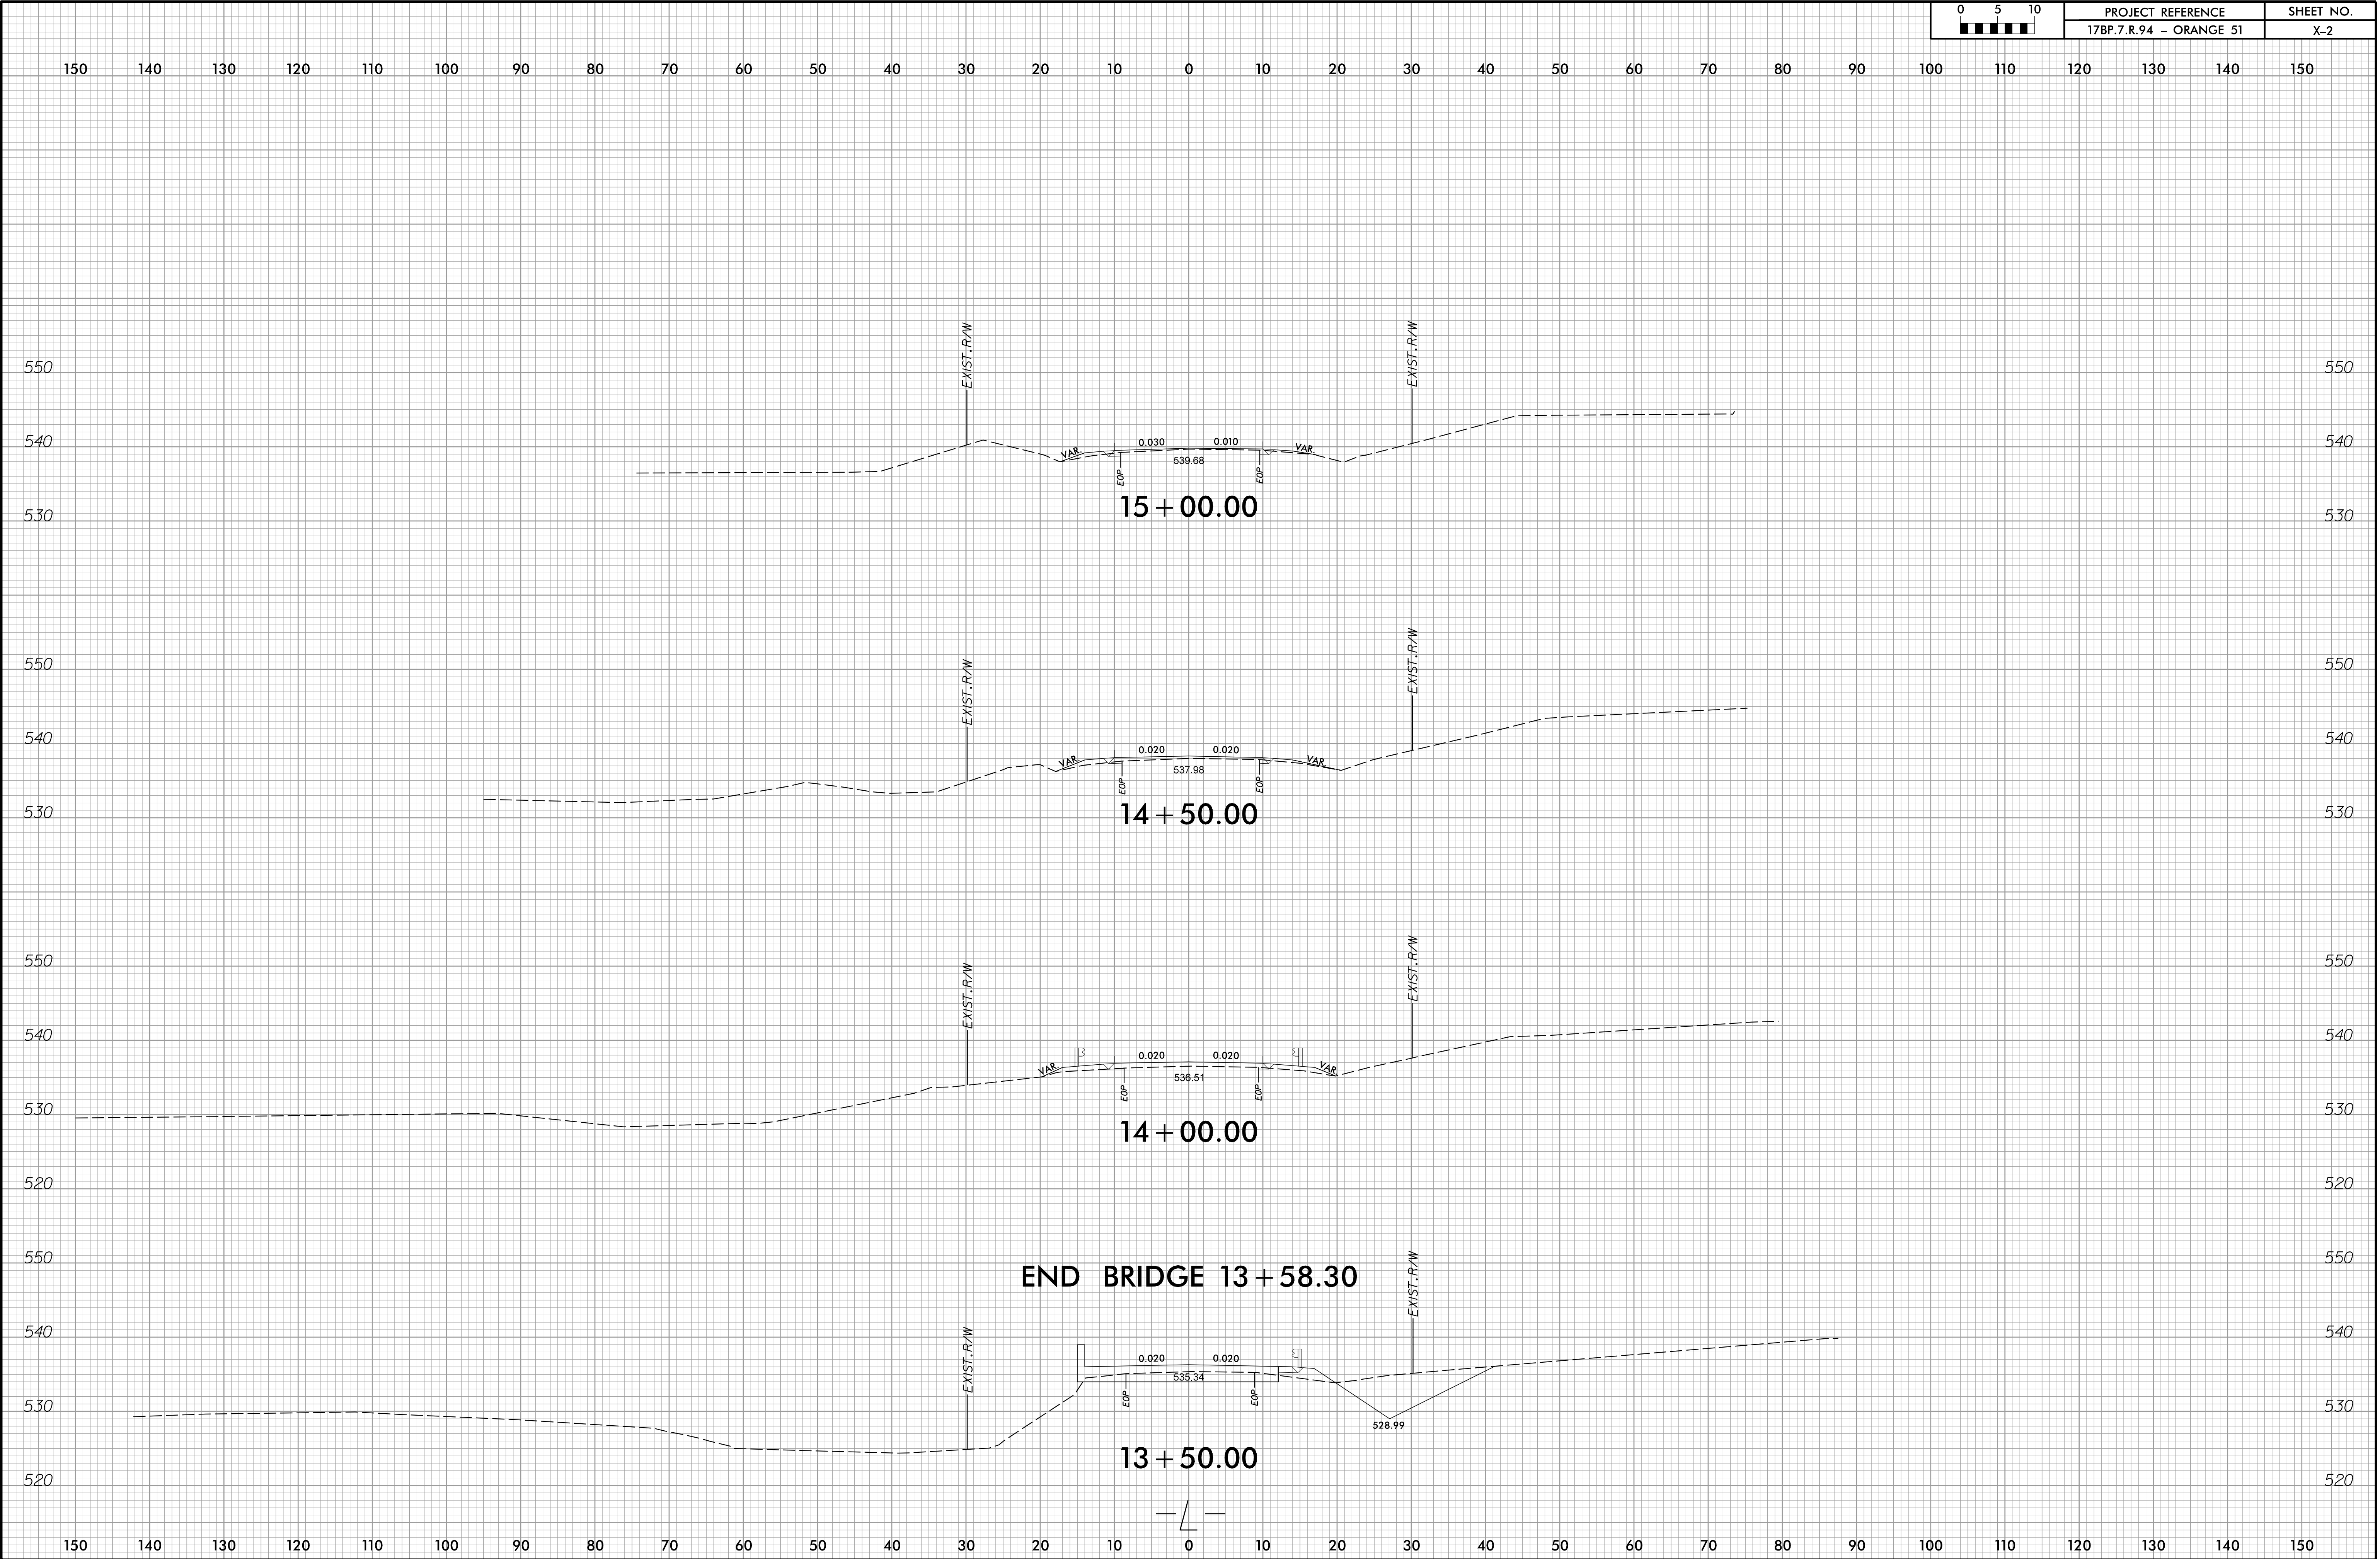




2/7/2018 8:05:32 AM  
R:\R\_Corridor\Xsc\Xpl\G70001.Fdy.xpl.dgn  
0960103

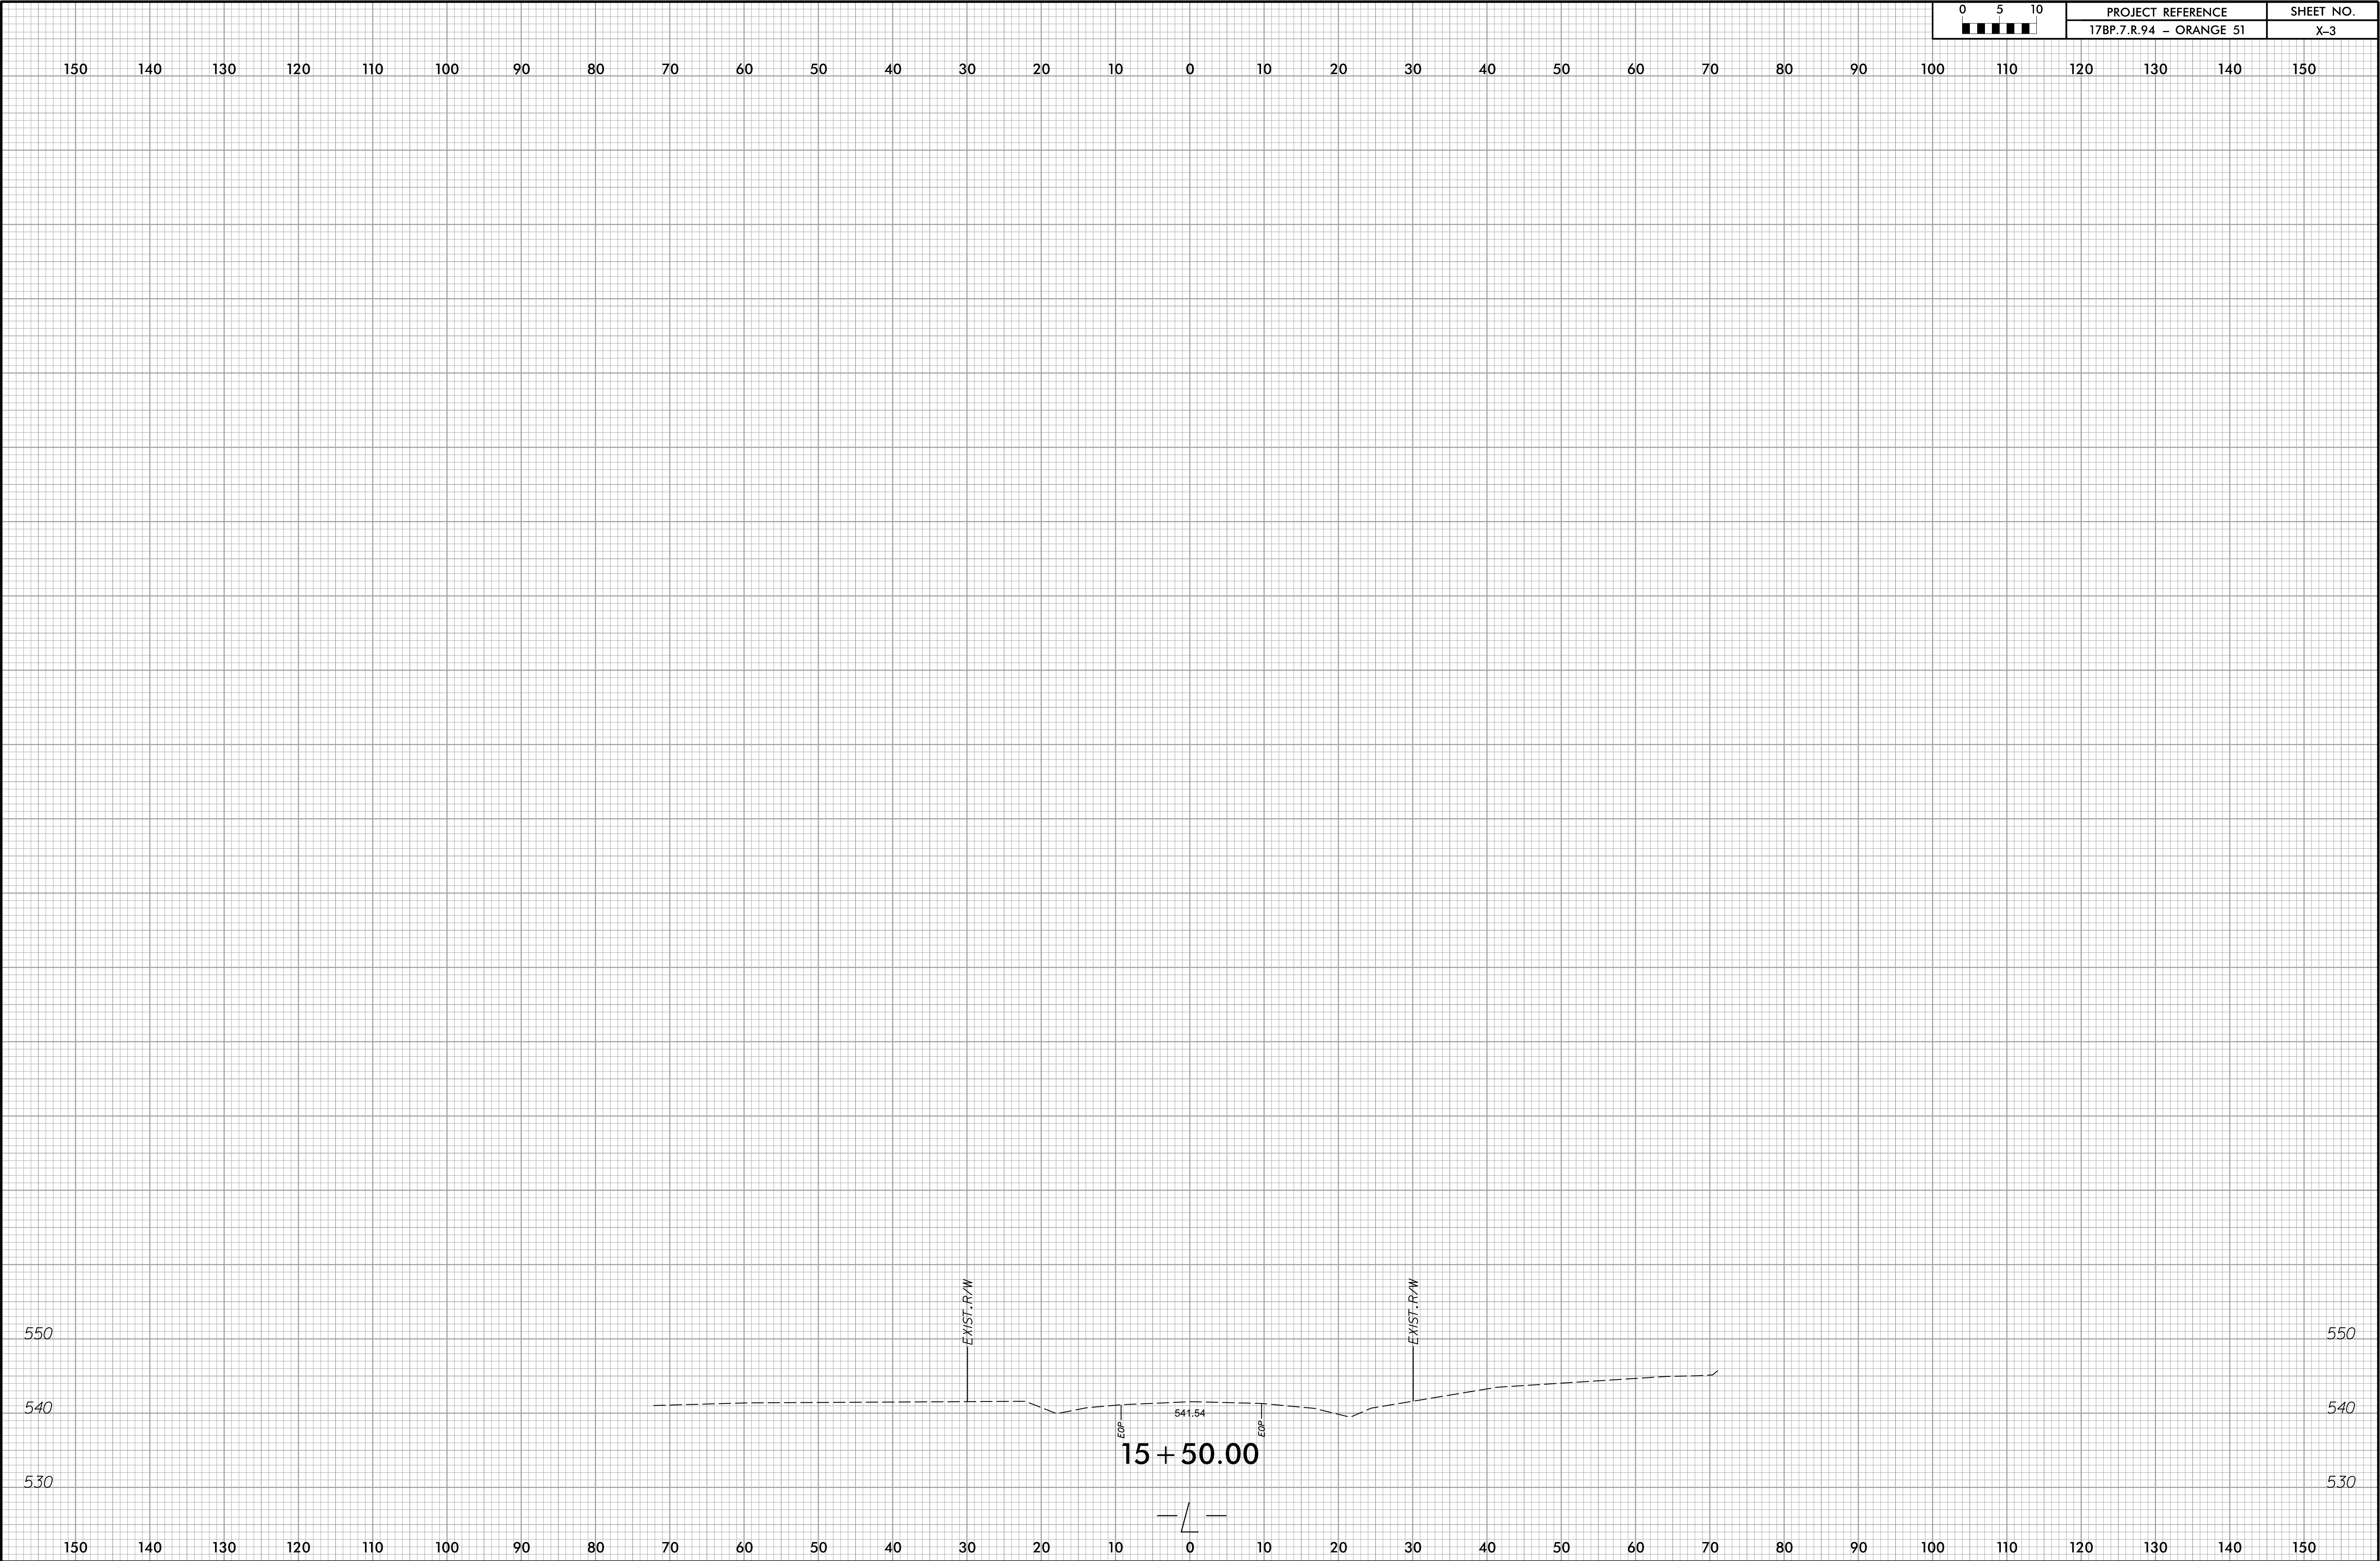

3/6/2018 8:35:16 AM G:\Projects\2015\Division 7 (Hatch Mot)\17BP7R94 (Orange 51) (20 24CS VR)\Structures\Final (revised)\401.17BP7R94\_SMJ.gdgn

PROJ:17BP.7.R.94

DRAWN BY: T. BANKOVICH DATE: 3-18  
CHECKED BY: B.S. COX DATE: 3-18  
DESIGN ENGINEER OF RECORD: B.S. COX DATE: 3-18

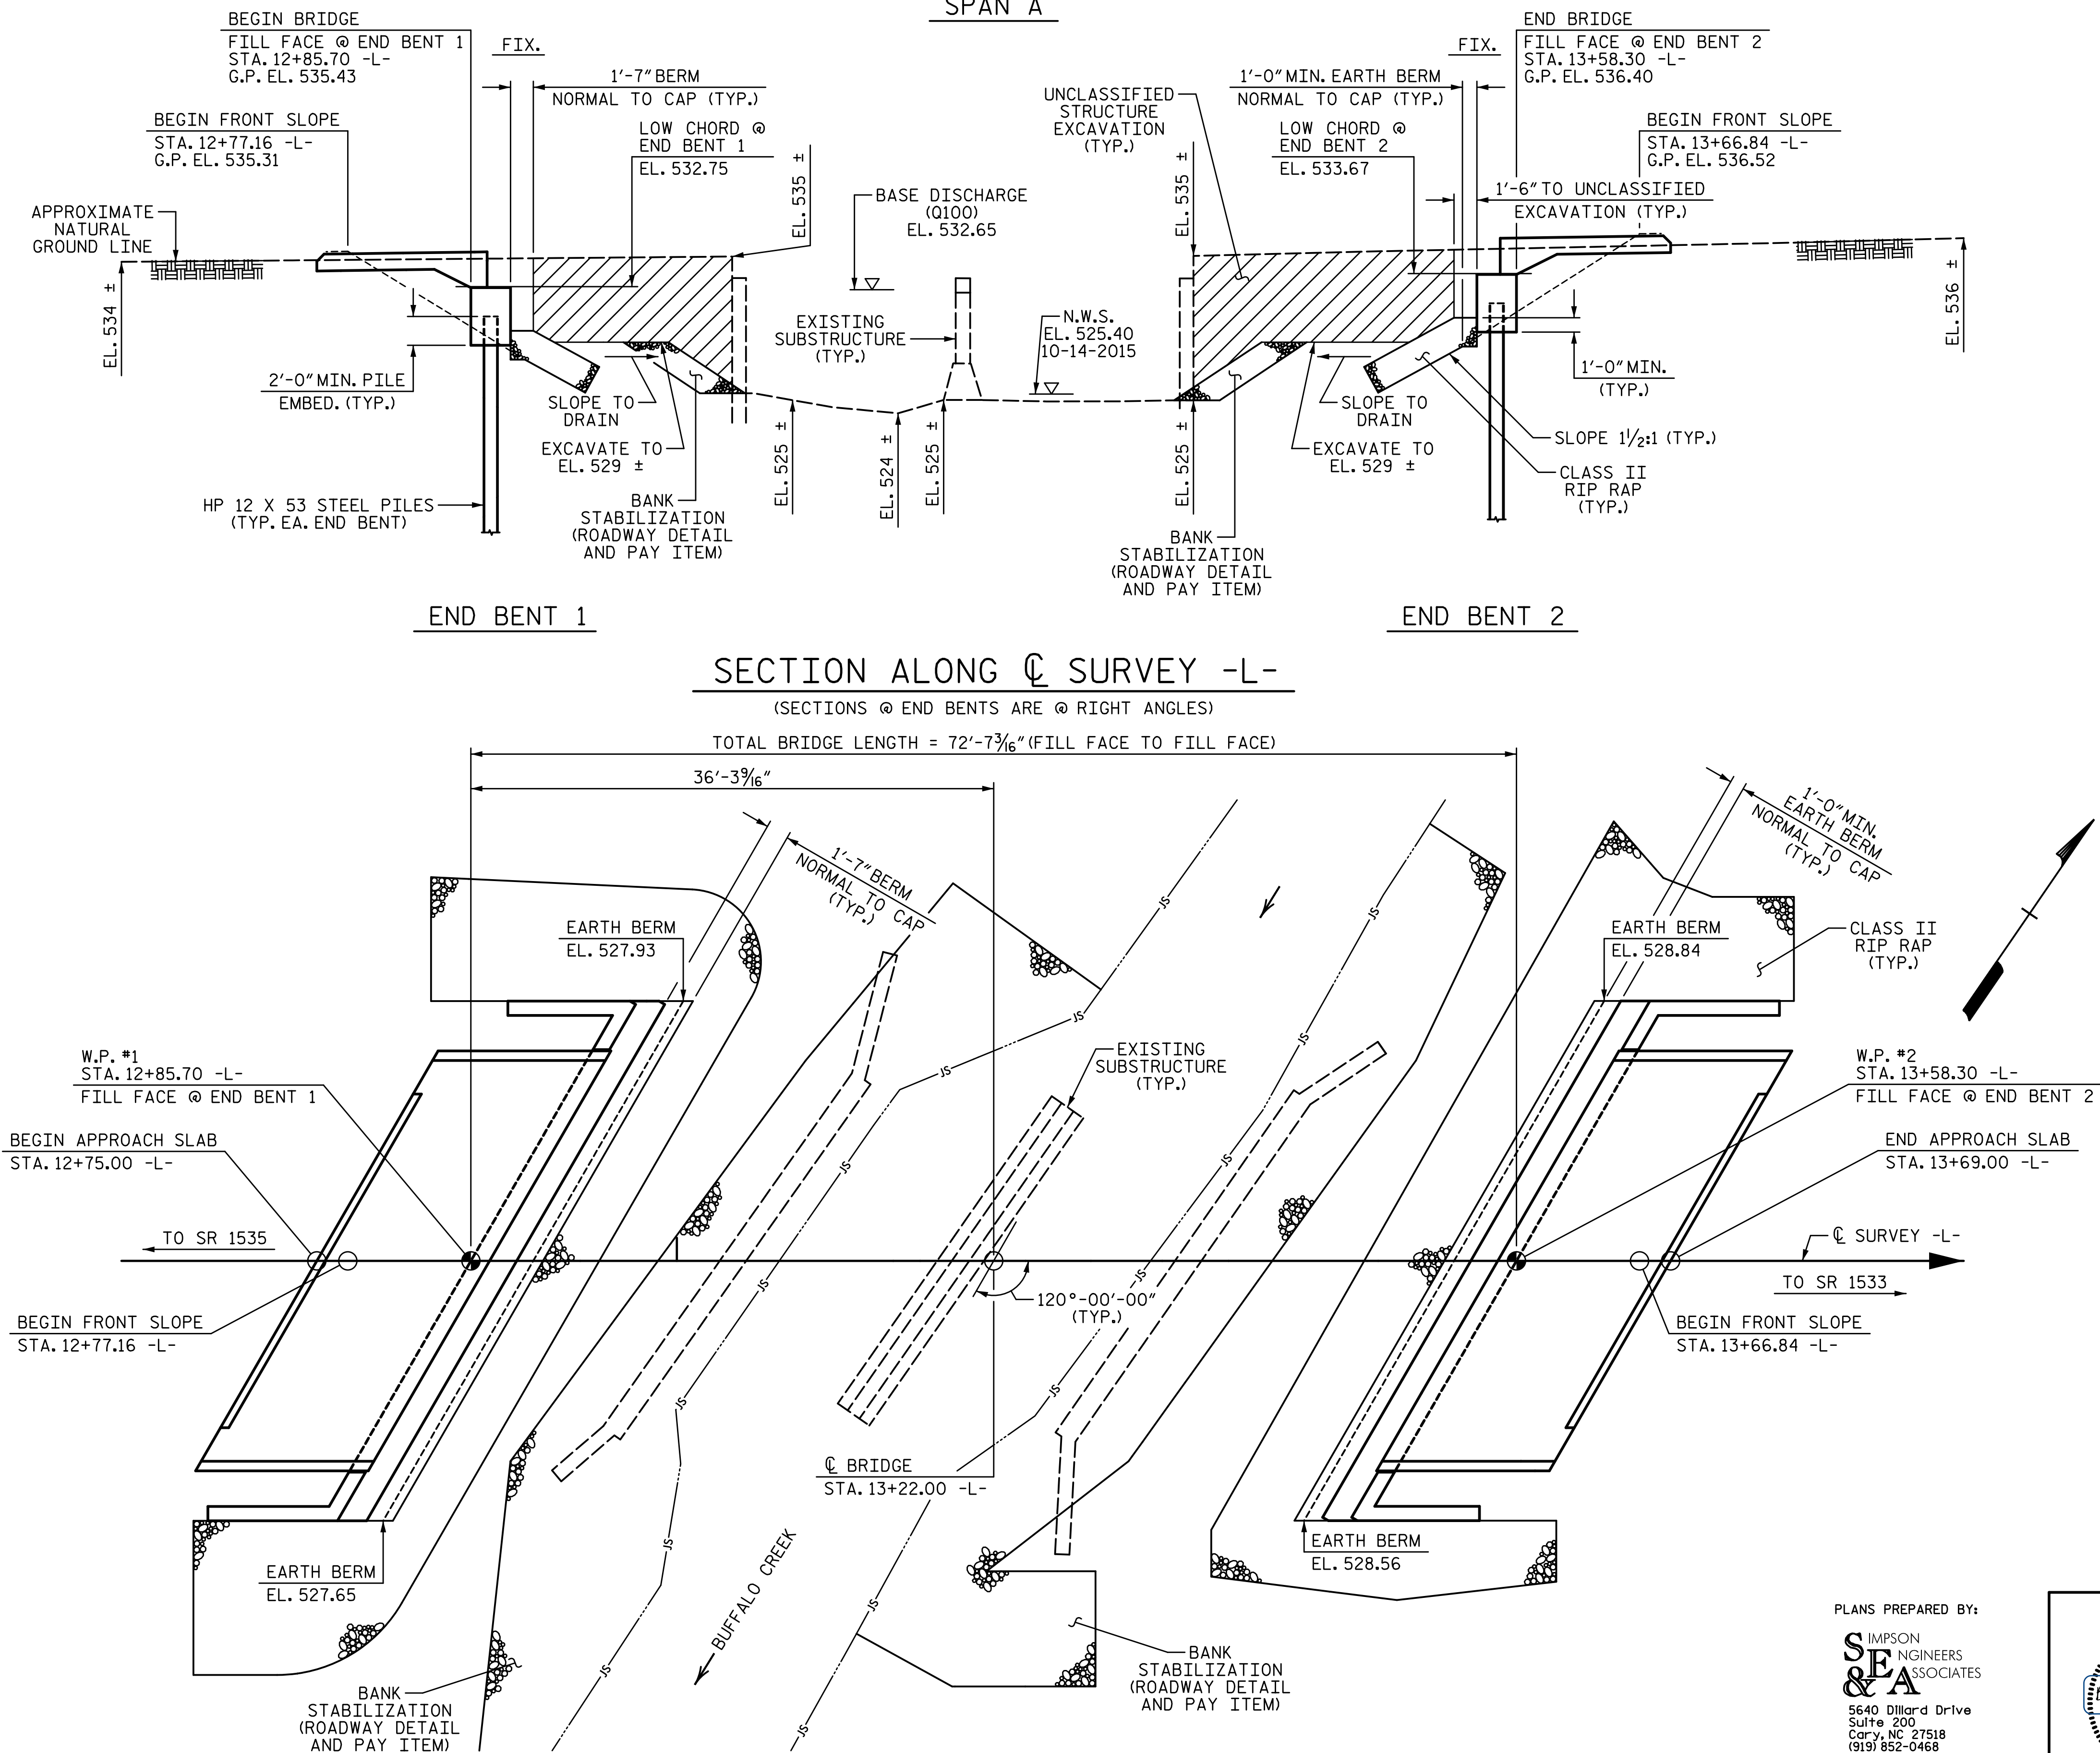

PLAN  
(PILES NOT SHOWN IN PLAN VIEW)

(-)0.3077%	(+)1.3385%
PVI STA. 12+15.00 EL. = 534.48 VC = 130'	
(+)1.3385%	(+)3.0222%
PVI STA. 14+10.00 EL. = 537.09 VC = 110'	
GRADE DATA -L-	

HYDRAULIC DATA:	
DESIGN DISCHARGE	= 950 CFS
FREQUENCY OF DESIGN FLOOD	= 25 YEAR
DESIGN HIGH WATER ELEVATION	= 531.90
DRAINAGE AREA	= 2.5 SQ. MI.
BASE DISCHARGE (Q 100)	= 1300 CFS
BASE HIGH WATER ELEVATION	= 532.65
OVERTOPPING FLOOD DATA:	
OVERTOPPING DISCHARGE	= N/A
FREQUENCY OF OVERTOPPING FLOOD	= 500+ YEAR
OVERTOPPING FLOOD ELEVATION	= 534.65 **
** OVERTOPPING OCCURS AT APPROXIMATELY 97' WEST OF THE BRIDGE	

I HEREBY CERTIFY THESE PLANS  
ARE THE AS-BUILT PLANS

PROJECT NO. 17BP.7.R.94  
ORANGE COUNTY  
STATION: 13+22.00 -L-

SHEET 1 OF 2 REPLACES BRIDGE #51


STATE OF NORTH CAROLINA  
DEPARTMENT OF TRANSPORTATION  
RALEIGH

GENERAL DRAWING

FOR BRIDGE ON SR 1534  
(MCKEE RD.) OVER  
BUFFALO CREEK  
BETWEEN SR 1535 AND SR 1533  
27'-10" CLEAR ROADWAY - 120° SKEW

REVISIONS						SHEET NO. S-1
NO.	BY:	DATE:	NO.	BY:	DATE:	
1			3			TOTAL SHEETS 14
2			4			


PLANS PREPARED BY:  
SEMPSON ENGINEERS & ASSOCIATES  
5640 Dillard Drive  
Suite 200  
Cary, NC 27518  
(919) 852-0468  
(919) 852-0598 (Fax)  
www.sempsonengr.com  
LICENSURE NO. C-2521

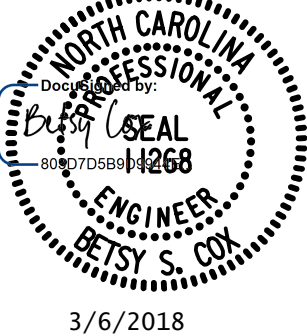

DOCUMENT NOT CONSIDERED FINAL  
UNLESS ALL SIGNATURES COMPLETED



3/6/2018 8:35:16 AM G:\Projects\2015\Division 7 (Hatch Mot+)\17BP7R94 (Orange 51) (120 24CS VR)\Structures\Drawings\Final (revised)\401.17BP7R94\_SMU.gdp.dgn

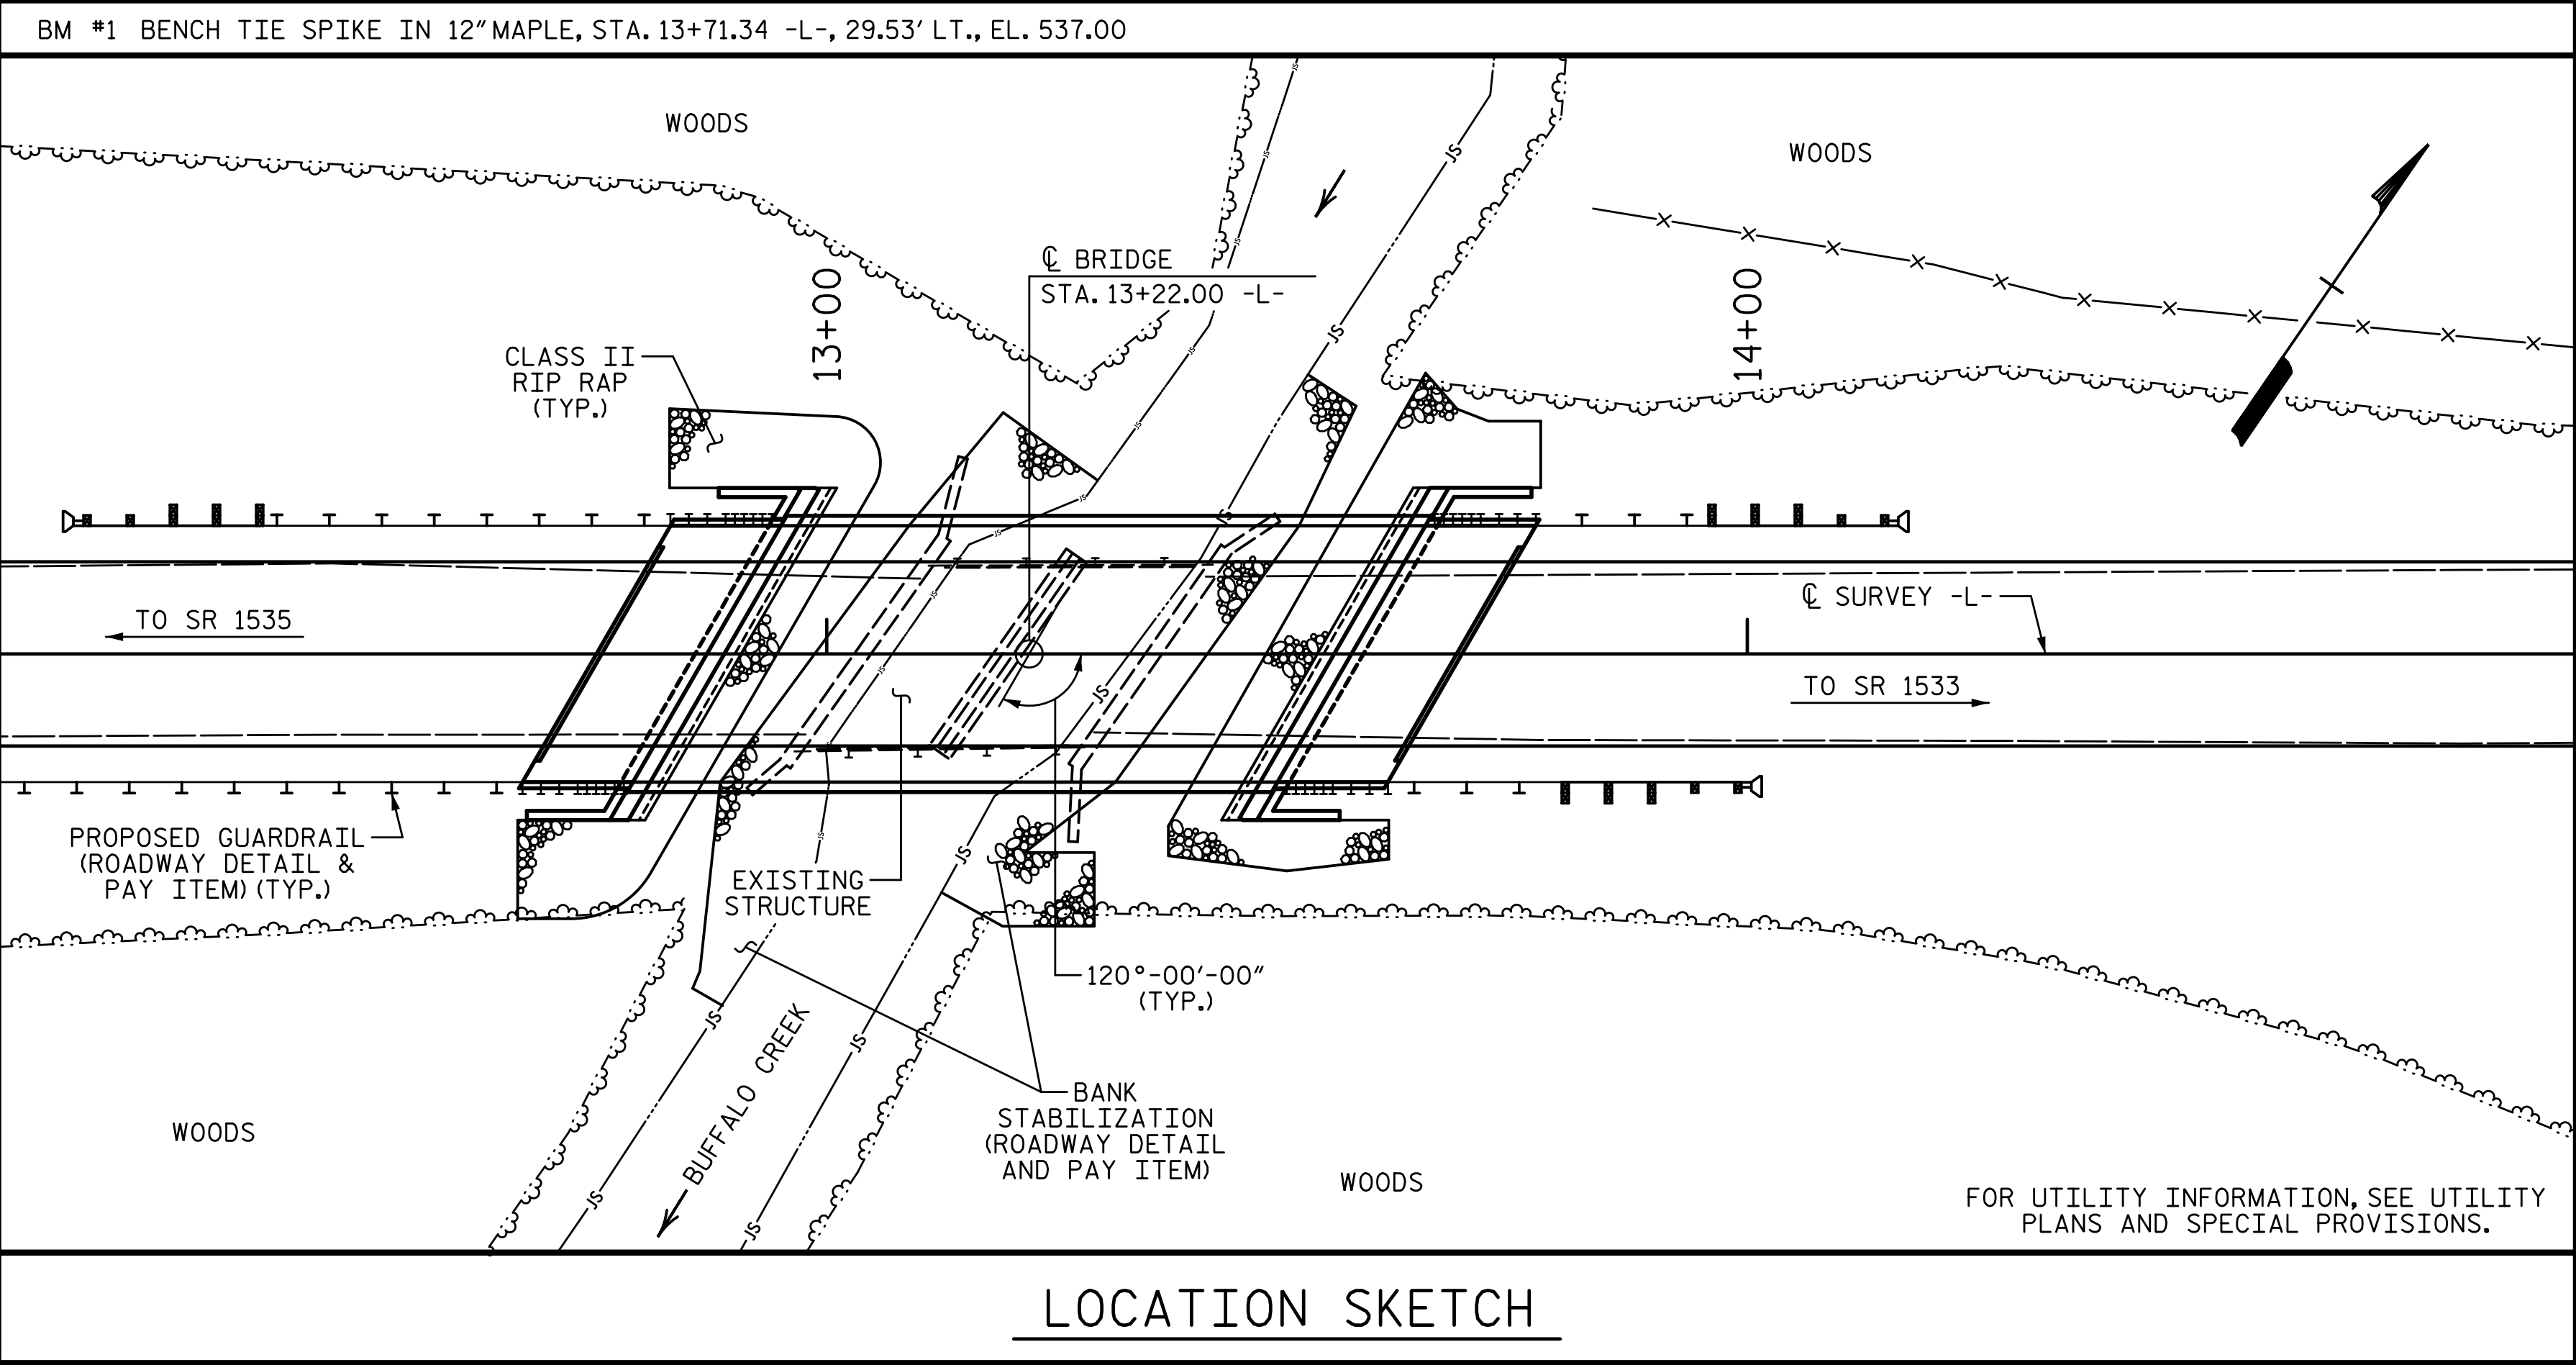

NOTES:

- ASSUMED LIVE LOAD = HL-93 OR ALTERNATE LOADING.
- THIS BRIDGE HAS BEEN DESIGNED IN ACCORDANCE WITH THE AASHTO LRFD BRIDGE DESIGN SPECIFICATIONS.
- THIS BRIDGE IS LOCATED IN SEISMIC ZONE 1.
- FOR OTHER DESIGN DATA AND GENERAL NOTES, SEE SHEET SN.
- FOR EROSION CONTROL MEASURES, SEE EROSION CONTROL PLANS.
- REMOVAL OF THE EXISTING BRIDGE SHALL BE PERFORMED SO AS NOT TO ALLOW DEBRIS TO FALL INTO THE WATER. THE CONTRACTOR SHALL REMOVE THE BRIDGE AND SUBMIT PLANS FOR DEMOLITION IN ACCORDANCE WITH ARTICLE 402-2 OF THE STANDARD SPECIFICATIONS.
- THE MATERIAL SHOWN IN THE CROSS-HATCHED AREA SHALL BE EXCAVATED FOR A DISTANCE OF 35 FT. LT. AND RT. OF CENTERLINE ROADWAY AS DIRECTED BY THE ENGINEER. THIS WORK WILL BE PAID FOR AT THE CONTRACT LUMP SUM PRICE FOR UNCLASSIFIED STRUCTURE EXCAVATION. SEE SECTION 412 OF THE STANDARD SPECIFICATIONS.
- THE EXISTING STRUCTURE CONSISTS OF 1 SPAN @ 15'-9" AND 1 SPAN @ 16'-4". THE SUPERSTRUCTURE HAS A CLEAR ROADWAY WIDTH OF 19.08' AND HAS A TIMBER DECK ON TIMBER JOISTS. THE END BENTS CONSIST OF MASS CONCRETE ABUTMENTS AND THE INTERIOR BENT CONSISTS OF TIMBER CAP ON CONCRETE ENCASED TIMBER PILES. THE EXISTING STRUCTURE, WHICH IS LOCATED AT THE SITE OF THE PROPOSED STRUCTURE, SHALL BE REMOVED. THE EXISTING BRIDGE IS PRESENTLY POSTED FOR LOAD LIMIT. SHOULD THE STRUCTURAL INTEGRITY OF THE BRIDGE DETERIORATE DURING CONSTRUCTION OF THE PROPOSED BRIDGE, THE LOAD LIMIT MAY BE REDUCED AS NECESSARY DURING THE LIFE OF THE PROJECT.
- THE SUBSTRUCTURE OF THE EXISTING BRIDGE INDICATED ON THE PLANS IS FROM THE BEST INFORMATION AVAILABLE. SINCE THIS INFORMATION IS SHOWN FOR THE CONVENIENCE OF THE CONTRACTOR, THE CONTRACTOR SHALL HAVE NO CLAIM WHATSOEVER AGAINST THE DEPARTMENT OF TRANSPORTATION FOR ANY DELAYS OR ADDITIONAL COST INCURRED BASED ON DIFFERENCES BETWEEN THE EXISTING BRIDGE SUBSTRUCTURE SHOWN ON THE PLANS AND THE ACTUAL CONDITIONS AT THE PROJECT SITE.
- THIS STRUCTURE HAS BEEN DESIGNED IN ACCORDANCE WITH "HEC 18-EVALUATING SCOUR AT BRIDGES."
- FOR SUBMITTAL OF WORKING DRAWINGS, SEE SPECIAL PROVISIONS.
- FOR FALSEWORK AND FORMWORK, SEE SPECIAL PROVISIONS.
- FOR CRANE SAFETY, SEE SPECIAL PROVISIONS.
- FOR GROUT FOR STRUCTURES, SEE SPECIAL PROVISIONS.
- ASPHALT WEARING SURFACE IS INCLUDED IN ROADWAY QUANTITY ON ROADWAY PLANS.
- FOR ASBESTOS ASSESSMENT FOR BRIDGE DEMOLITION AND RENOVATION ACTIVITIES, SEE SPECIAL PROVISIONS.
- AT THE CONTRACTOR'S OPTION, PRESTRESSED CONCRETE END BENT CAPS MAY BE SUBSTITUTED IN PLACE OF THE CAST-IN-PLACE CAPS. THE CONTRACTOR SHALL COORDINATE WITH THE ENGINEER TO RECEIVE REVISED PLANS AND DETAILS FROM THE STRUCTURES MANAGEMENT UNIT. THE REDESIGN AND ANY ADDITIONAL MATERIALS NEEDED WILL BE AT NO ADDITIONAL COST TO THE CONTRACTOR.

TOTAL BILL OF MATERIAL

	REMOVAL OF EXISTING STRUCTURE	PILE EXCAVATION IN SOIL	PILE EXCAVATION NOT IN SOIL	UNCLASSIFIED STRUCTURE EXCAVATION	CLASS A CONCRETE	BRIDGE APPROACH SLABS	REINFORCING STEEL	PILE DRIVING EQUIPMENT SETUP FOR HP 12 X 53 STEEL PILES	HP 12 X 53 STEEL PILES		VERTICAL CONCRETE BARRIER RAIL	RIP RAP CLASS II (2'-0" THICK)	GEOTEXTILE FOR DRAINAGE	ELASTOMERIC BEARINGS	3'-0" X 2'-0" PRESTRESSED CONCRETE CORED SLABS		ASBESTOS ASSESSMENT
	LS	LF	LF	LS	CY	LS	LB	EA	NO.	LF	LF	TON	SY	LS	NO.	LF	LS
SUPERSTRUCTURE						LS					140.29			LS	10	700.00	
END BENT 1		35	25	LS	22.6		2,736	5	5	60		80	90				
END BENT 2		25	25	LS	22.6		2,736	5	5	60		95	105				
TOTAL	LS	60	50	LS	45.2	LS	5,472	10	10	120	140.29	175	195	LS	10	700.00	LS

FOUNDATION NOTES:

- FOR PILES, SEE SECTION 450 OF THE STANDARD SPECIFICATIONS.
- PILES AT END BENT 1 ARE DESIGNED FOR A FACTORED RESISTANCE OF 100 TONS PER PILE.
- DRIVE PILES AT END BENT 1 TO A REQUIRED DRIVING RESISTANCE OF 170 TONS PER PILE.
- DRILLED-IN PILES MAY BE REQUIRED FOR END BENT 1. IF REQUIRED, EXCAVATE HOLES AT PILE LOCATIONS TO ELEVATION 518.8 FT. FOR PILE EXCAVATION, SEE SECTION 450 OF THE STANDARD SPECIFICATIONS.
- CONCRETE OR GROUT IS REQUIRED TO FILL HOLES FOR PILE EXCAVATION AT END BENT 1.
- PILES AT END BENT 2 ARE DESIGNED FOR A FACTORED RESISTANCE OF 100 TONS PER PILE.
- DRIVE PILES AT END BENT 2 TO A REQUIRED DRIVING RESISTANCE OF 170 TONS PER PILE.
- DRILLED-IN PILES MAY BE REQUIRED FOR END BENT 2. IF REQUIRED, EXCAVATE HOLES AT PILE LOCATIONS TO ELEVATION 519.8 FT. FOR PILE EXCAVATION, SEE SECTION 450 OF THE STANDARD SPECIFICATIONS.
- CONCRETE OR GROUT IS REQUIRED TO FILL HOLES FOR PILE EXCAVATION AT END BENT 2.

PROJECT NO. 17BP.7.R.94

ORANGE COUNTY


STATION: 13+22.00 -L-

SHEET 2 OF 2

DRAWN BY: T. BANKOVICH	DATE: 3-18
CHECKED BY: B.S. COX	DATE: 3-18
DESIGN ENGINEER OF RECORD: B.S. COX	DATE: 3-18

PLANS PREPARED BY:

SIMPSON  
ENGINEERS  
& ASSOCIATES  
5640 Dillard Drive  
Suite 200  
Cary, NC 27518  
(919) 852-0468  
(919) 852-0598 (Fax)  
www.simpsonengr.com  
LICENSURE NO. C-2521

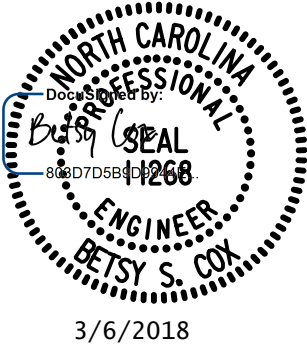

GENERAL DRAWING

FOR BRIDGE ON SR 1534 (MCKEE RD.) OVER BUFFALO CREEK BETWEEN SR 1535 AND SR 1533 27'-10" CLEAR ROADWAY - 120° SKEW


REVISIONS						SHEET NO.
NO.	BY:	DATE:	NO.	BY:	DATE:	S-2
1			3			TOTAL SHEETS 14
2			4			

DOCUMENT NOT CONSIDERED FINAL  
UNLESS ALL SIGNATURES COMPLETED



3/6/2018 8:35:17 AM G:\Projects\2015\Division 7 (Hatch Mot+1)\17BP7R94 (Orange 51) (120 24CS VR)\Structures\Drawings\Final (revised)\401\_17BP7R94\_SML\_LRFR.dgn

LOAD AND RESISTANCE FACTOR RATING (LRFD) SUMMARY FOR PRESTRESSED CONCRETE GIRDERS																								
LEVEL	VEHICLE	WEIGHT (W) (TONS)	CONTROLLING LOAD RATING	MINIMUM RATING FACTORS (RF)	TONS = W X RF	STRENGTH I LIMIT STATE											SERVICE III LIMIT STATE						COMMENT NUMBER	
						LIVELOAD FACTORS	MOMENT					SHEAR					LIVELOAD FACTORS	MOMENT						
							DISTRIBUTION FACTORS (DF)	RATING FACTOR	SPAN	GIRDER LOCATION	DISTANCE FROM LEFT END OF SPAN (ft)	DISTRIBUTION FACTORS (DF)	RATING FACTOR	SPAN	GIRDER LOCATION	DISTANCE FROM LEFT END OF SPAN (ft)		DISTRIBUTION FACTORS (DF)	RATING FACTOR	SPAN	GIRDER LOCATION	DISTANCE FROM LEFT END OF SPAN (ft)		
DESIGN LOAD RATING	HL-93(Inv)	N/A	1	1.06	--	1.75	0.248	1.14	70'	EL	34.423	0.655	1.06	70'	EL	6.885	0.80	0.248	1.11	70'	EL	34.423		
	HL-93(0pr)	N/A	--	1.374	--	1.35	0.248	1.48	70'	EL	34.423	0.655	1.37	70'	EL	6.885	N/A	--	--	--	--	--		
	HS-20(Inv)	36.000	2	1.32	47.508	1.75	0.248	1.48	70'	EL	34.423	0.655	1.32	70'	EL	6.885	0.80	0.248	1.44	70'	EL	34.423		
	HS-20(0pr)	36.000	--	1.711	61.585	1.35	0.248	1.91	70'	EL	34.423	0.655	1.71	70'	EL	6.885	N/A	--	--	--	--	--		
LEGAL LOAD RATING	SV	SNSH	13.500	--	3.204	43.258	1.4	0.248	4.12	70'	EL	34.423	0.655	3.9	70'	EL	6.885	0.80	0.248	3.20	70'	EL	34.423	
		SNGARBS2	20.000	--	2.403	48.063	1.4	0.248	3.09	70'	EL	34.423	0.655	2.78	70'	EL	6.885	0.80	0.248	2.40	70'	EL	34.423	
		SNAGRIS2	22.000	--	2.282	50.21	1.4	0.248	2.94	70'	EL	34.423	0.655	2.58	70'	EL	6.885	0.80	0.248	2.28	70'	EL	34.423	
		SNCOTTS3	27.250	--	1.595	43.463	1.4	0.248	2.05	70'	EL	34.423	0.655	1.95	70'	EL	6.885	0.80	0.248	1.59	70'	EL	34.423	
		SNAGGRS4	34.925	--	1.339	46.755	1.4	0.248	1.72	70'	EL	34.423	0.655	1.62	70'	EL	6.885	0.80	0.248	1.34	70'	EL	34.423	
		SNS5A	35.550	--	1.309	46.526	1.4	0.248	1.68	70'	EL	34.423	0.655	1.65	70'	EL	6.885	0.80	0.248	1.31	70'	EL	34.423	
		SNS6A	39.950	--	1.203	48.069	1.4	0.248	1.55	70'	EL	34.423	0.655	1.5	70'	EL	6.885	0.80	0.248	1.20	70'	EL	34.423	
		SNS7B	42.000	--	1.146	48.129	1.4	0.248	1.47	70'	EL	34.423	0.655	1.48	70'	EL	6.885	0.80	0.248	1.15	70'	EL	34.423	
	TTST	TNAGRIT3	33.000	--	1.468	48.444	1.4	0.248	1.89	70'	EL	34.423	0.655	1.79	70'	EL	6.885	0.80	0.248	1.47	70'	EL	34.423	
		TNT4A	33.075	--	1.475	48.79	1.4	0.248	1.9	70'	EL	34.423	0.655	1.74	70'	EL	6.885	0.80	0.248	1.48	70'	EL	34.423	
		TNT6A	41.600	--	1.208	50.272	1.4	0.248	1.55	70'	EL	34.423	0.655	1.58	70'	EL	6.885	0.80	0.248	1.21	70'	EL	34.423	
		TNT7A	42.000	--	1.216	51.061	1.4	0.248	1.56	70'	EL	34.423	0.655	1.55	70'	EL	6.885	0.80	0.248	1.22	70'	EL	34.423	
		TNT7B	42.000	--	1.261	52.955	1.4	0.248	1.62	70'	EL	34.423	0.655	1.44	70'	EL	6.885	0.80	0.248	1.26	70'	EL	34.423	
		TNAGRIT4	43.000	--	1.197	51.476	1.4	0.248	1.54	70'	EL	34.423	0.655	1.4	70'	EL	6.885	0.80	0.248	1.20	70'	EL	34.423	
		TNAGT5A	45.000	--	1.128	50.745	1.4	0.248	1.45	70'	EL	34.423	0.655	1.39	70'	EL	6.885	0.80	0.248	1.13	70'	EL	34.423	
		TNAGT5B	45.000	3	1.113	50.088	1.4	0.248	1.43	70'	EL	34.423	0.655	1.33	70'	EL	6.885	0.80	0.248	1.11	70'	EL	34.423	

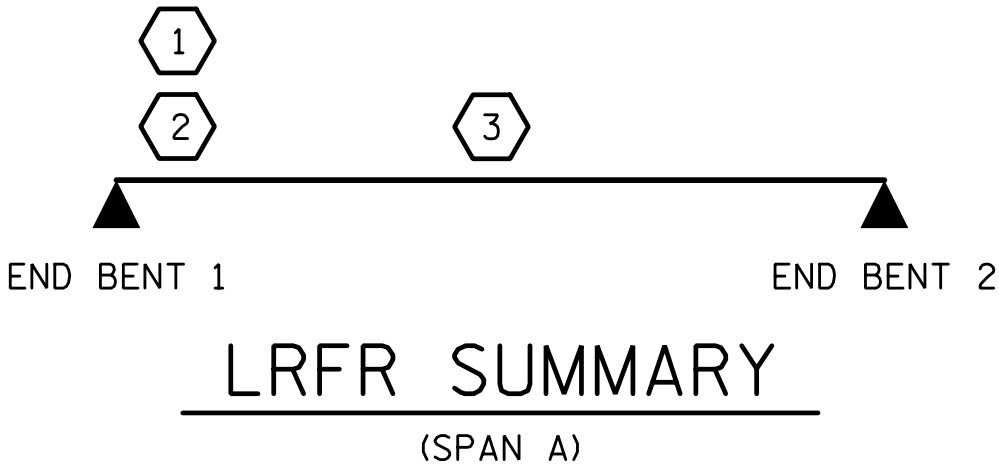

LOAD FACTORS:

DESIGN LOAD RATING FACTORS	LIMIT STATE	$\gamma_{DC}$	$\gamma_{DW}$
	STRENGTH I	1.25	1.50
	SERVICE III	1.00	1.00

NOTES:

MINIMUM RATING FACTORS ARE BASED ON THE STRENGTH I AND SERVICE III LIMIT STATES.

ALLOWABLE STRESSES FOR SERVICE III LIMIT STATE ARE AS REQUIRED FOR DESIGN.

DISTANCE FROM LEFT END OF SPAN IS MEASURED FROM  $\text{C}$  BEARING.

# CONTROLLING LOAD RATING

1 DESIGN LOAD RATING (HL-93)

2 DESIGN LOAD RATING (HS-20)

3 LEGAL LOAD RATING \*\*

\*\* SEE CHART FOR VEHICLE TYPE


GIRDER LOCATION

I - INTERIOR GIRDER  
EL - EXTERIOR LEFT GIRDER  
ER - EXTERIOR RIGHT GIRDER

PROJECT NO. 17BP.7.R.94  
ORANGE COUNTY  
STATION: 13+22.00 -L-

DRAWN BY: D.G. VESTER	DATE: 3-18
CHECKED BY: B.S. COX	DATE: 3-18
DESIGN ENGINEER OF RECORD: B.S. COX	DATE: 3-18

PLANS PREPARED BY:  
SE & A  
SIMPSON ENGINEERS & ASSOCIATES  
5640 Dillard Drive  
Suite 200  
Cary, NC 27518  
(919) 852-0468  
(919) 852-0598 (Fax)  
www.simpsonengr.com  
LICENSURE NO. C-2521

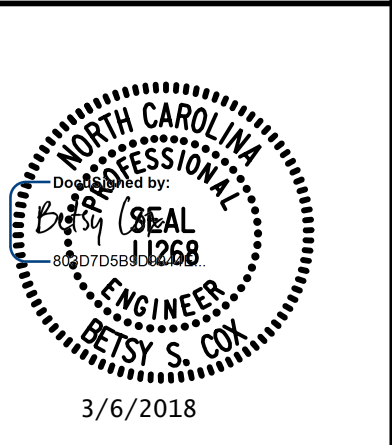


STATE OF NORTH CAROLINA DEPARTMENT OF TRANSPORTATION RALEIGH						SHEET NO. S-3		
LRFR SUMMARY FOR 70' CORED SLAB UNIT 120° SKEW (NON-INTERSTATE TRAFFIC)						TOTAL SHEETS 14		
REVISIONS								
NO.	BY:	DATE:	NO.	BY:	DATE:			
1			3					
2			4					

DOCUMENT NOT CONSIDERED FINAL  
UNLESS ALL SIGNATURES COMPLETED



3/6/2018 8:35:17 AM G:\Projects\2015\Division 7 (Hatch Mot)\17BP7R94 (Orange 51) (120 24CS VR)\Structures\Drawings\Final (revised)\401.17BP7R94\_SMJ\_SUPER.dgn

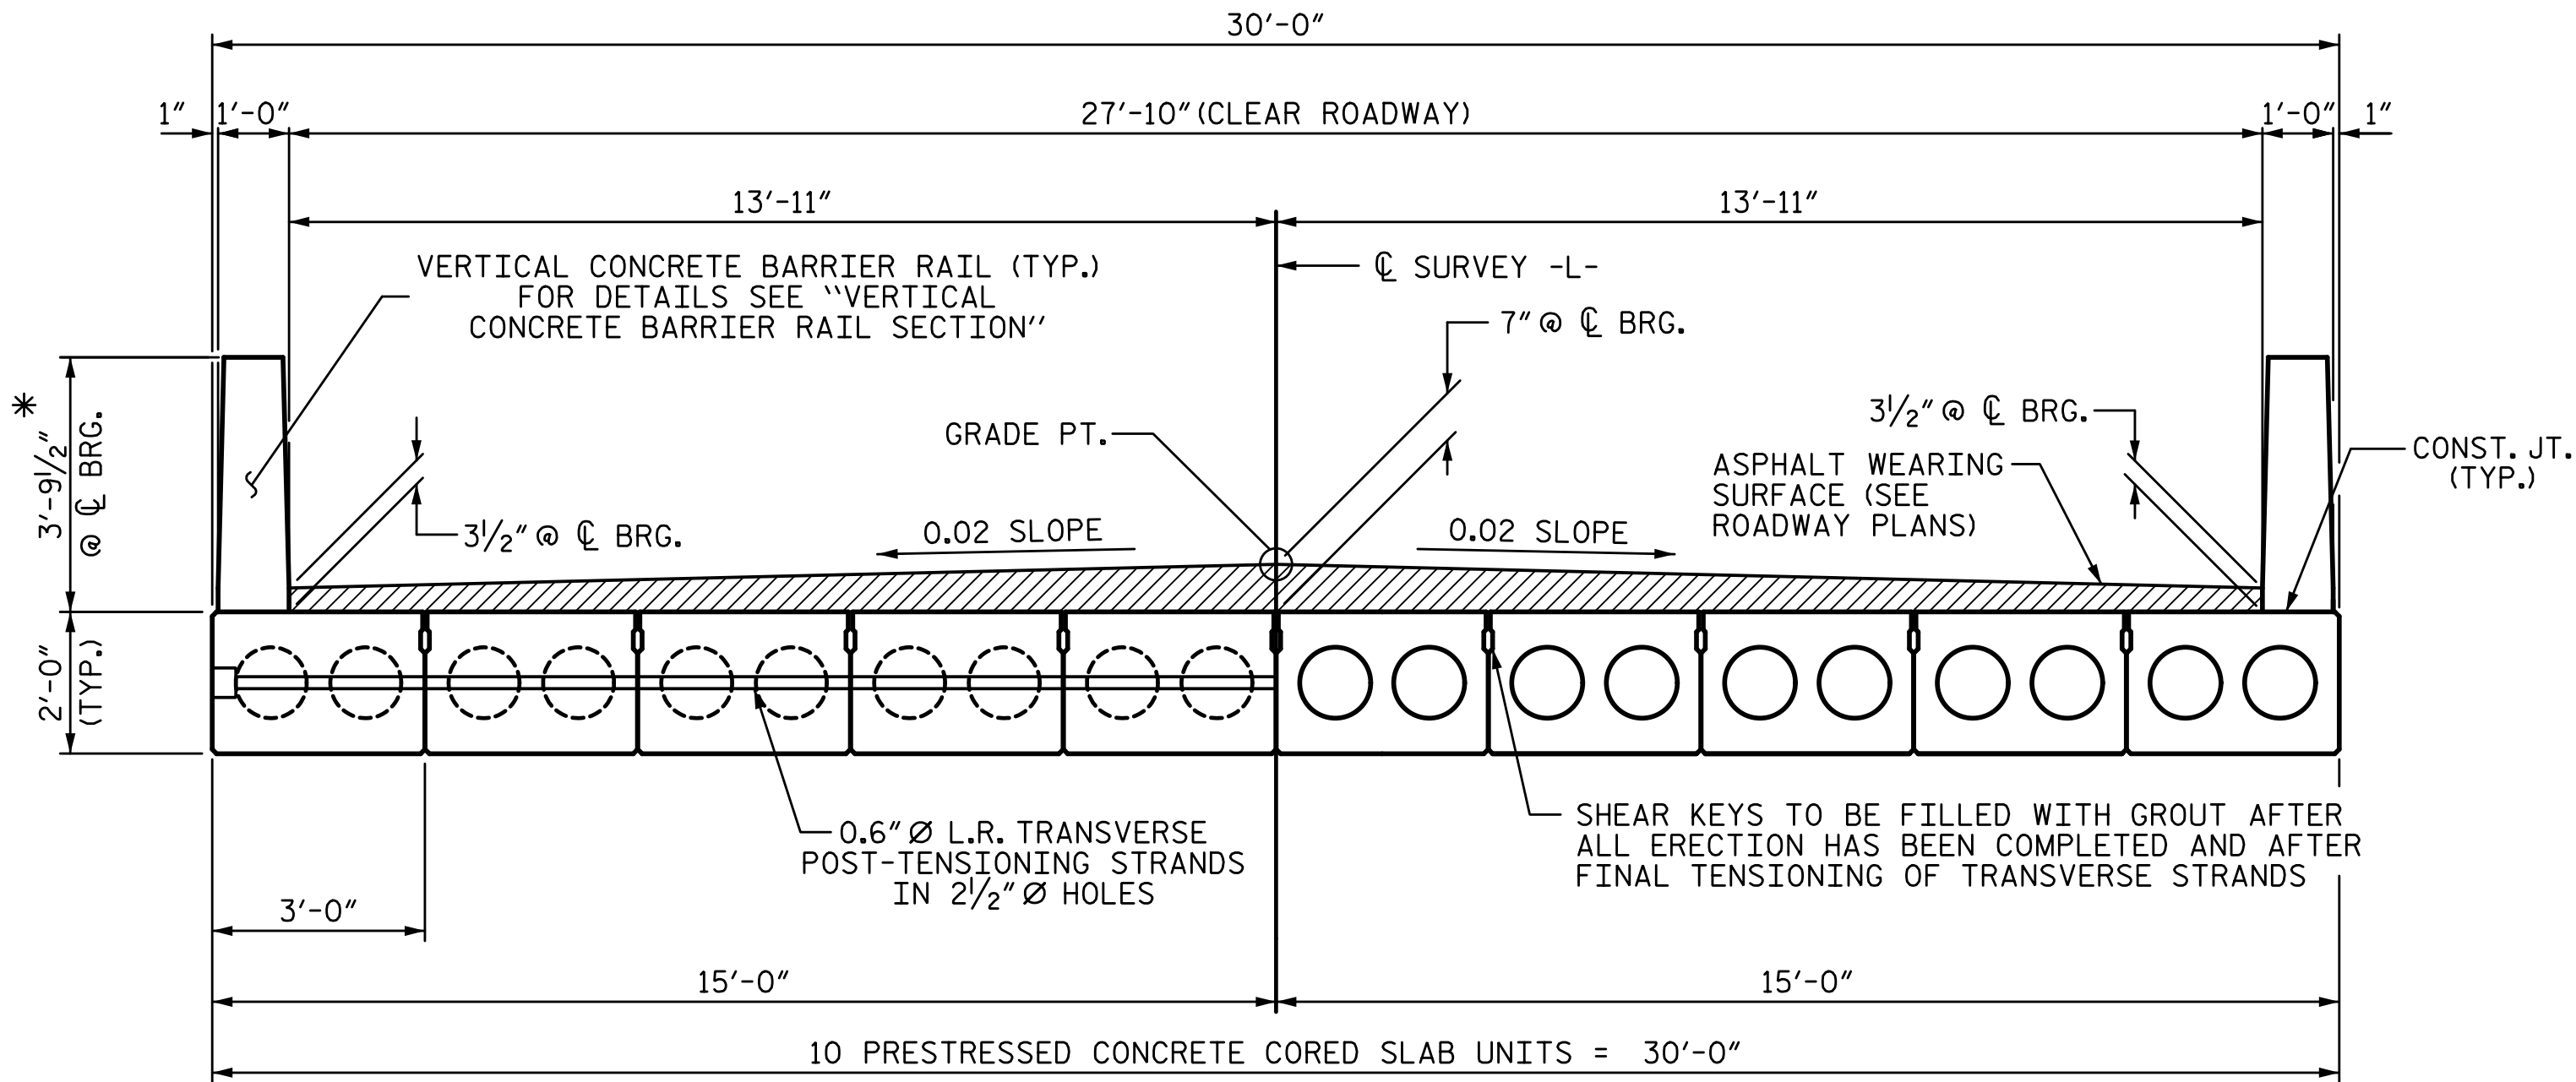


HALF SECTION  
(AT INTERMEDIATE DIAPHRAGMS)

HALF SECTION  
(THROUGH VOIDS)

### TYPICAL SECTION


\* - THE MAXIMUM BARRIER RAIL HEIGHTS AND ASPHALT THICKNESS ARE SHOWN. THE HEIGHT OF THE BARRIER RAIL AND ASPHALT THICKNESS VARIES WHILE THE TOP OF THE BARRIER RAIL FOLLOWS THE PROFILE OF THE GUTTERLINE. FOR RAIL HEIGHT DETAILS AND ASPHALT THICKNESS, SEE THE "VERTICAL CONCRETE BARRIER RAIL SECTION" DETAIL.

### FIXED END

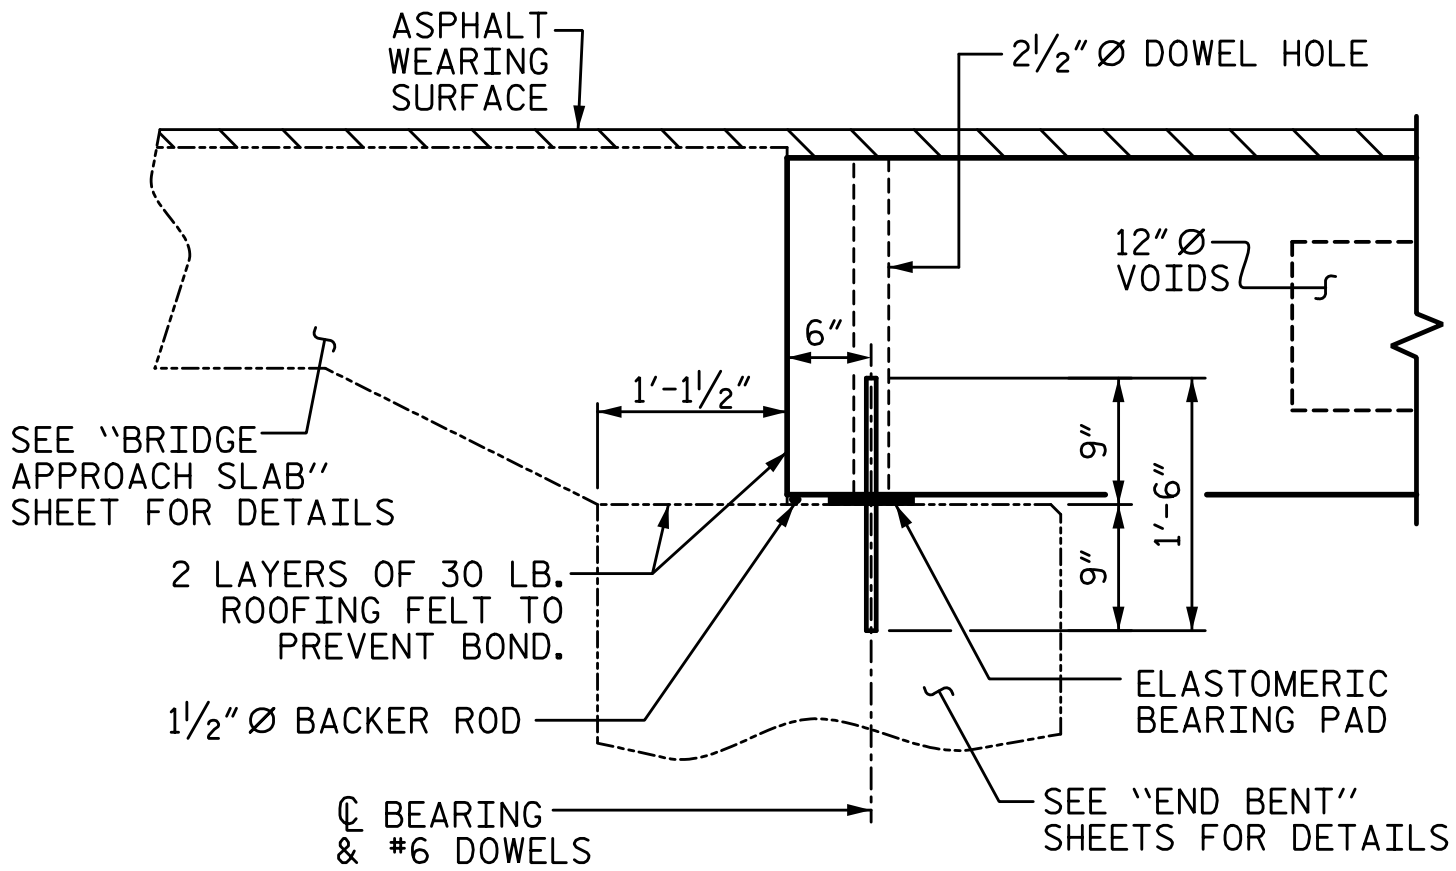


### SECTION AT END BENT

PERMITTED THREADED INSERT CAST IN OUTSIDE FACE OF EXTERIOR UNIT AND RECESSED 3/8" SIZE TO BE DETERMINED BY CONTRACTOR.

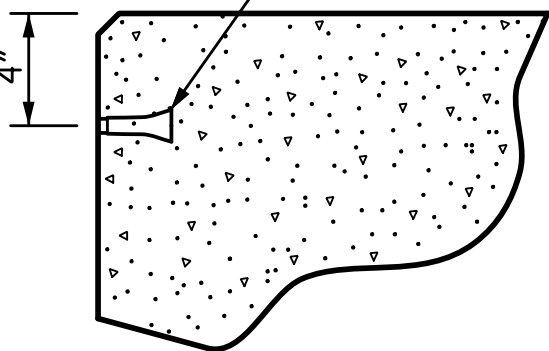


### THREADED INSERT DETAIL

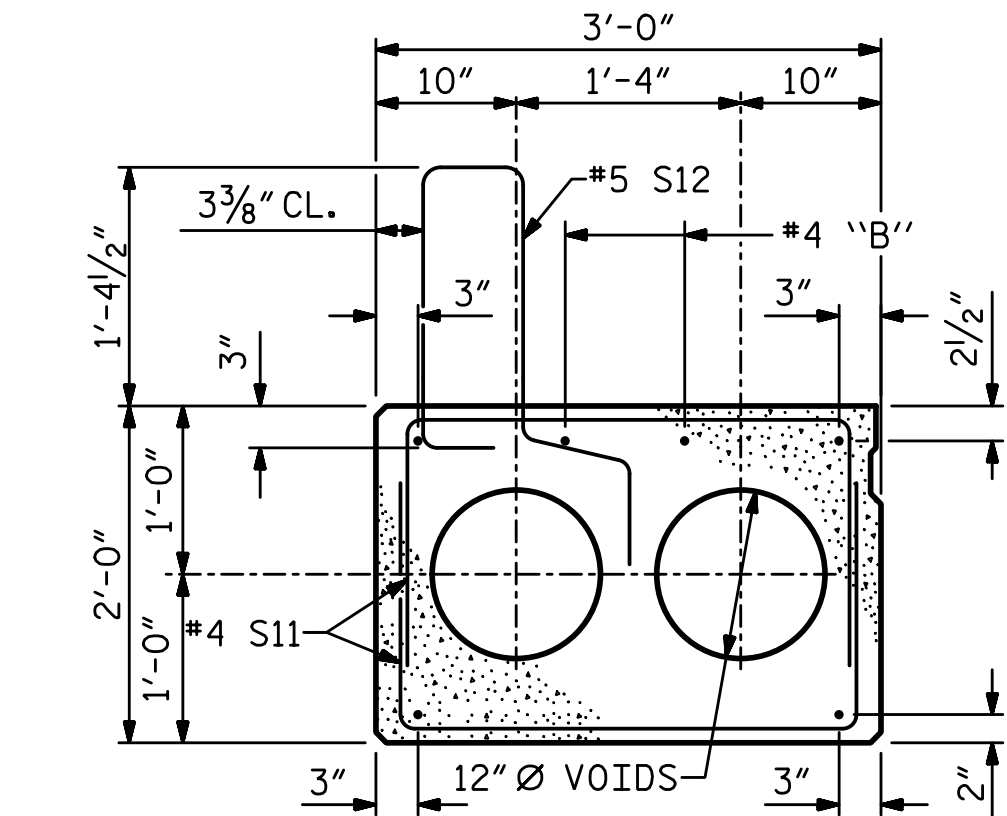

### EXTERIOR SLAB SECTION

(FOR PRESTRESSED STRAND LAYOUT, SEE INTERIOR SLAB SECTION.)

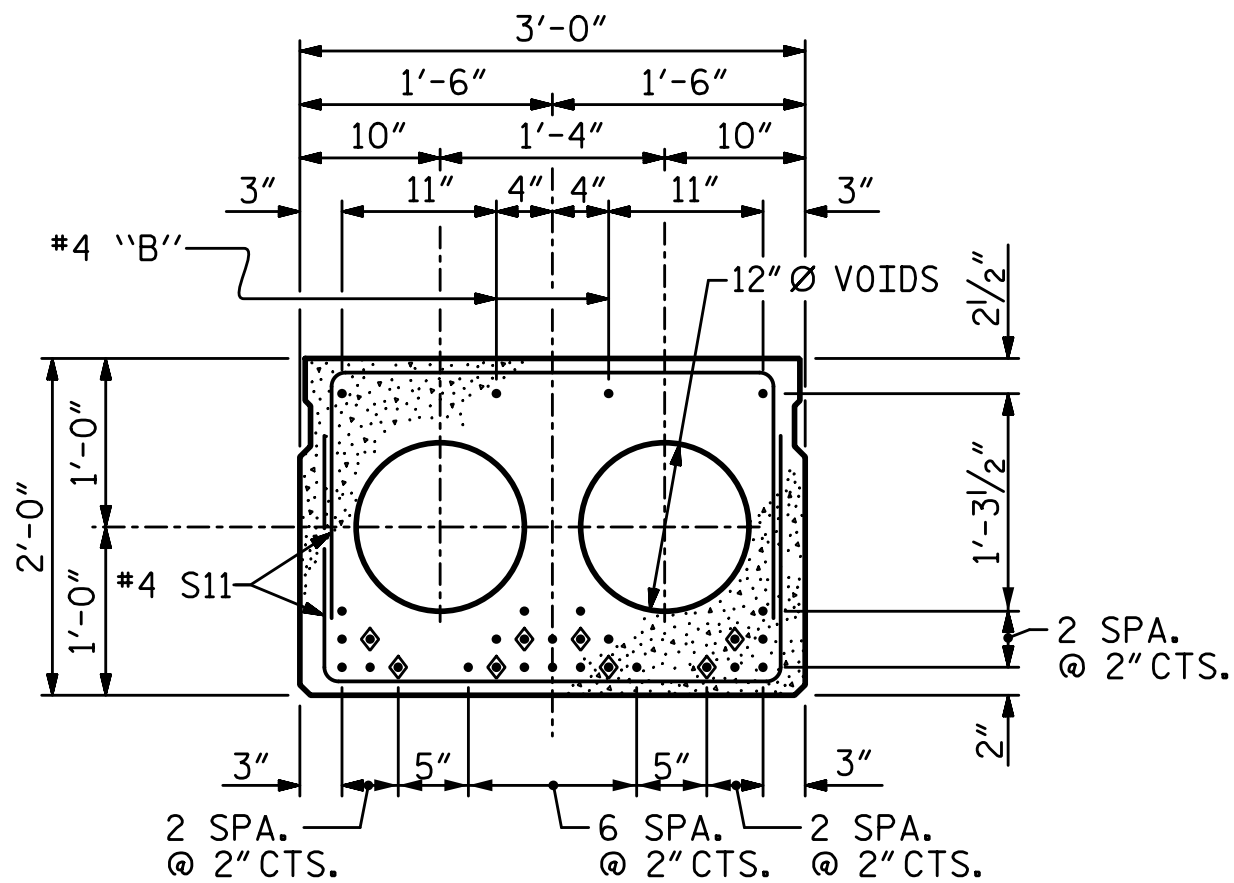


INTERIOR SLAB SECTION (70'-0" UNIT)  
(28 STRANDS REQUIRED)

### 0.6" Ø LOW RELAXATION STRAND LAYOUT


◆ BOND SHALL BE BROKEN ON THESE STRANDS FOR A DISTANCE OF 12'-0" FROM END OF CORED SLAB UNIT. SEE STANDARD SPECIFICATIONS, ARTICLE 1078-7.

### DEBONDING LEGEND

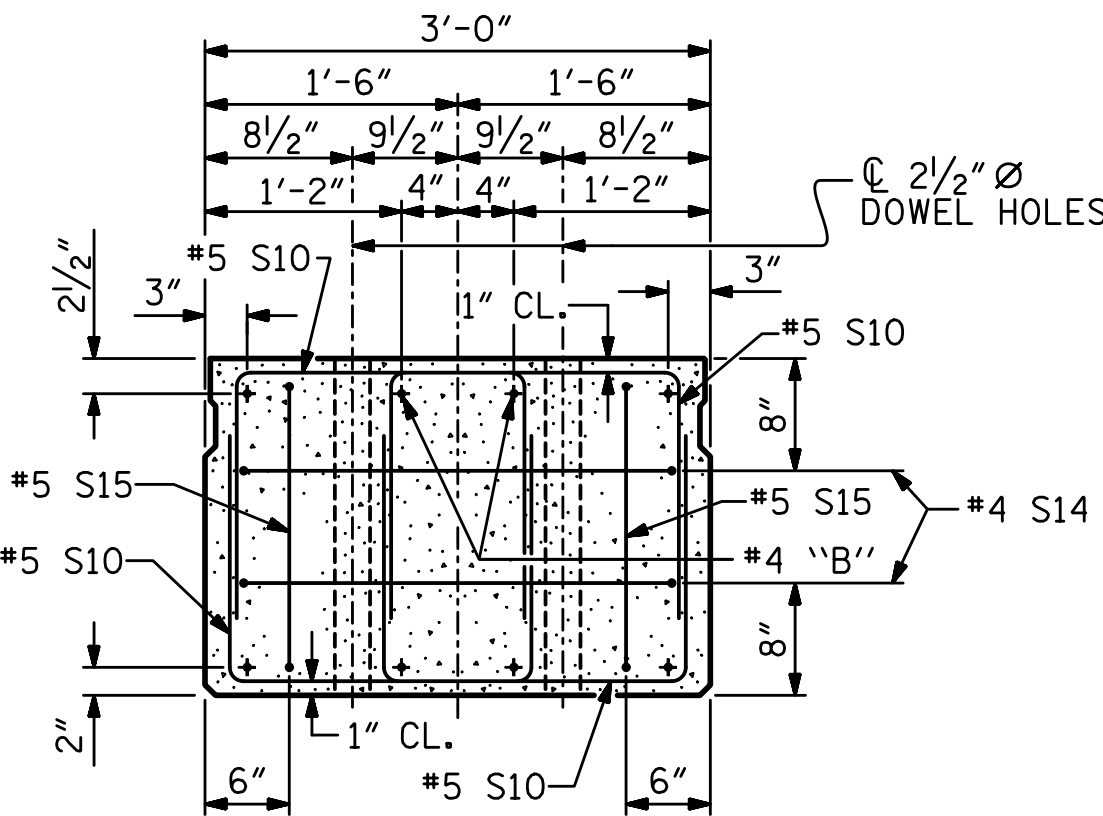

### END ELEVATION

SHOWING PLACEMENT OF DOUBLE STIRRUPS AND LOCATION OF DOWEL HOLES. (STRAND LAYOUT NOT SHOWN.) INTERIOR SLAB UNIT SHOWN-EXTERIOR SLAB UNIT SIMILAR EXCEPT SHEAR KEY LOCATION.

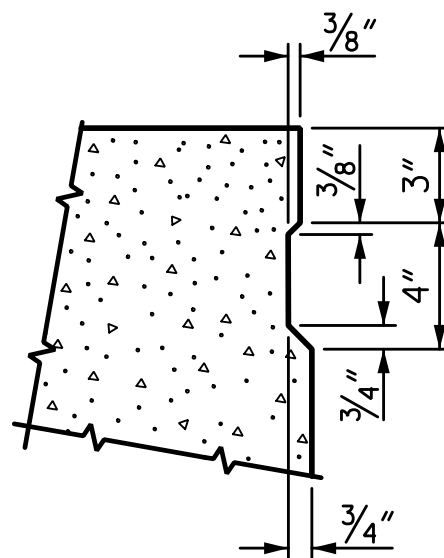


### SHEAR KEY DETAIL

NOTE: OMIT SHEET KEY ON OUTSIDE FACE OF EXTERIOR CORED SLABS.

PLANS PREPARED BY:

SEMPSON & ASSOCIATES  
5640 Dillard Drive  
Suite 200  
Cary, NC 27518  
(919) 852-0468  
(919) 852-0598 (Fax)  
www.simpsonengr.com  
LICENSURE NO. C-2521

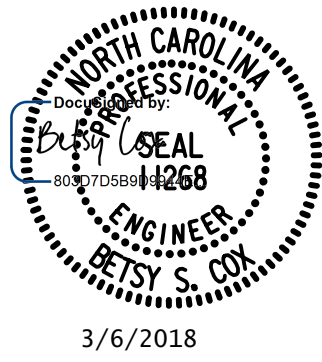

PROJECT NO. 17BP.7.R.94  
ORANGE COUNTY  
STATION: 13+22.00 -L-

SHEET 1 OF 3


STATE OF NORTH CAROLINA  
DEPARTMENT OF TRANSPORTATION  
RALEIGH  
SUPERSTRUCTURE  
3'-0" X 2'-0"  
PRESTRESSED CONCRETE  
CORED SLAB UNIT  
120° SKEW

REVISIONS						SHEET NO. S-4
NO.	BY:	DATE:	NO.	BY:	DATE:	
1			3			TOTAL SHEETS 14
2			4			


DOCUMENT NOT CONSIDERED FINAL  
UNLESS ALL SIGNATURES COMPLETED

DRAWN BY: T. BANKOVICH  
CHECKED BY: B.S. COX  
DESIGN ENGINEER OF RECORD: B.S. COX  
DATE: 3-18  
DATE: 3-18  
DATE: 3-18

3/6/2018 8:35:17 AM G:\Projects\2015\Division 7 (Hatch Mot+T)\17BP7R94 (Orange 51) (120 24CS VR)\Structures\Drawings\Final (revised)\401.17BP7R94\_SMJ\_SUPER.dgn

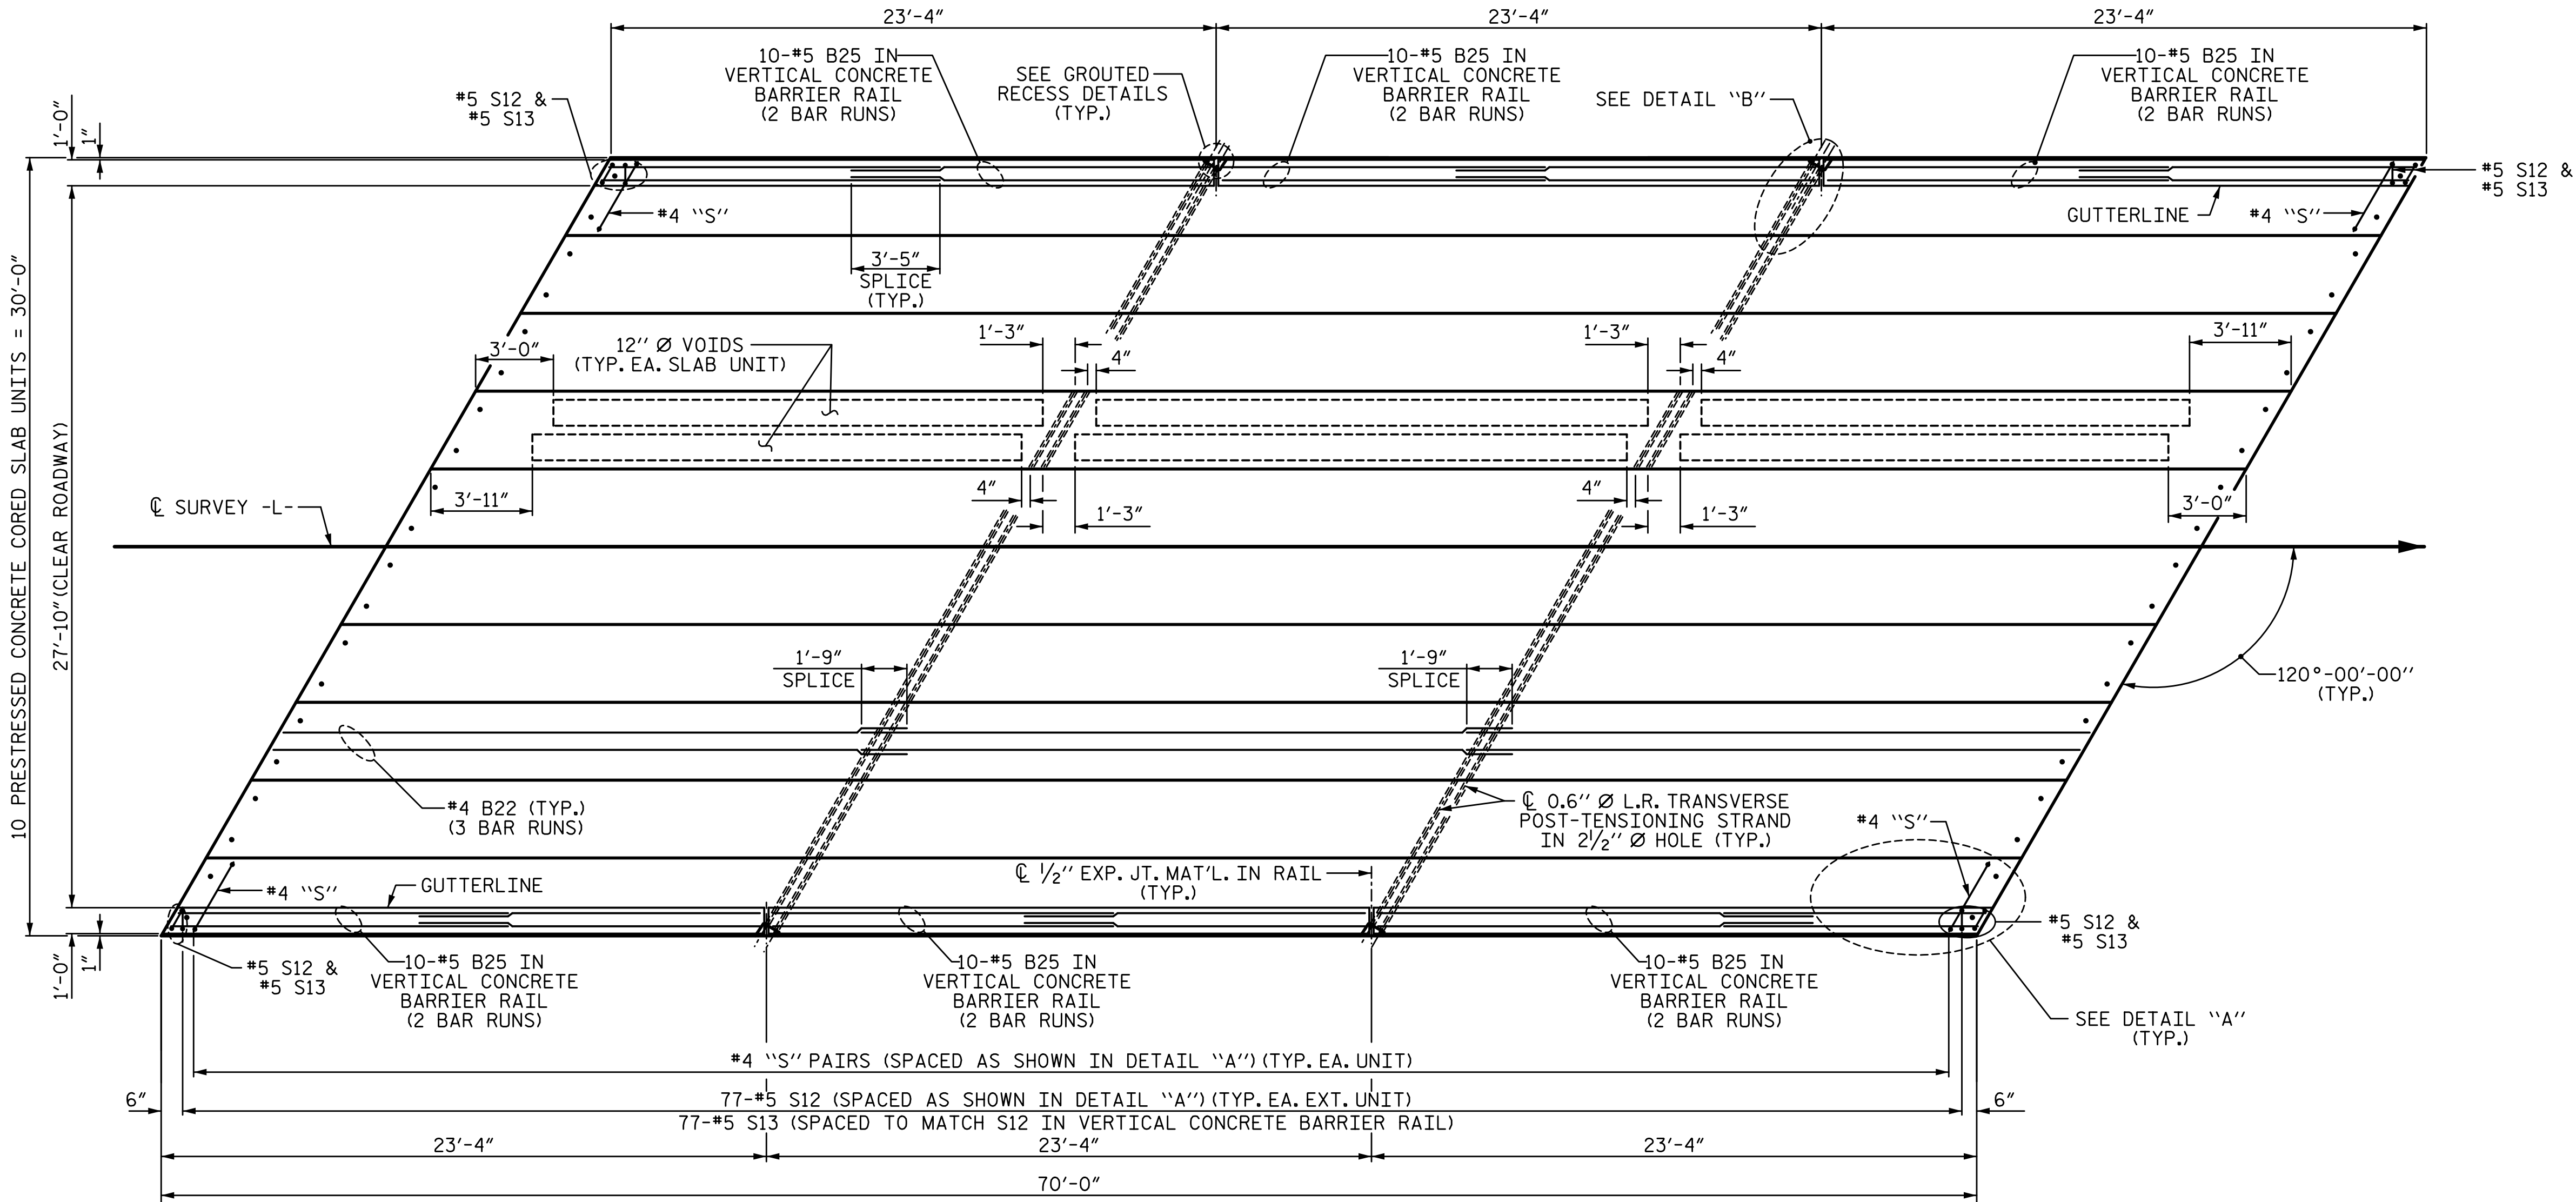


PLAN OF SPAN A

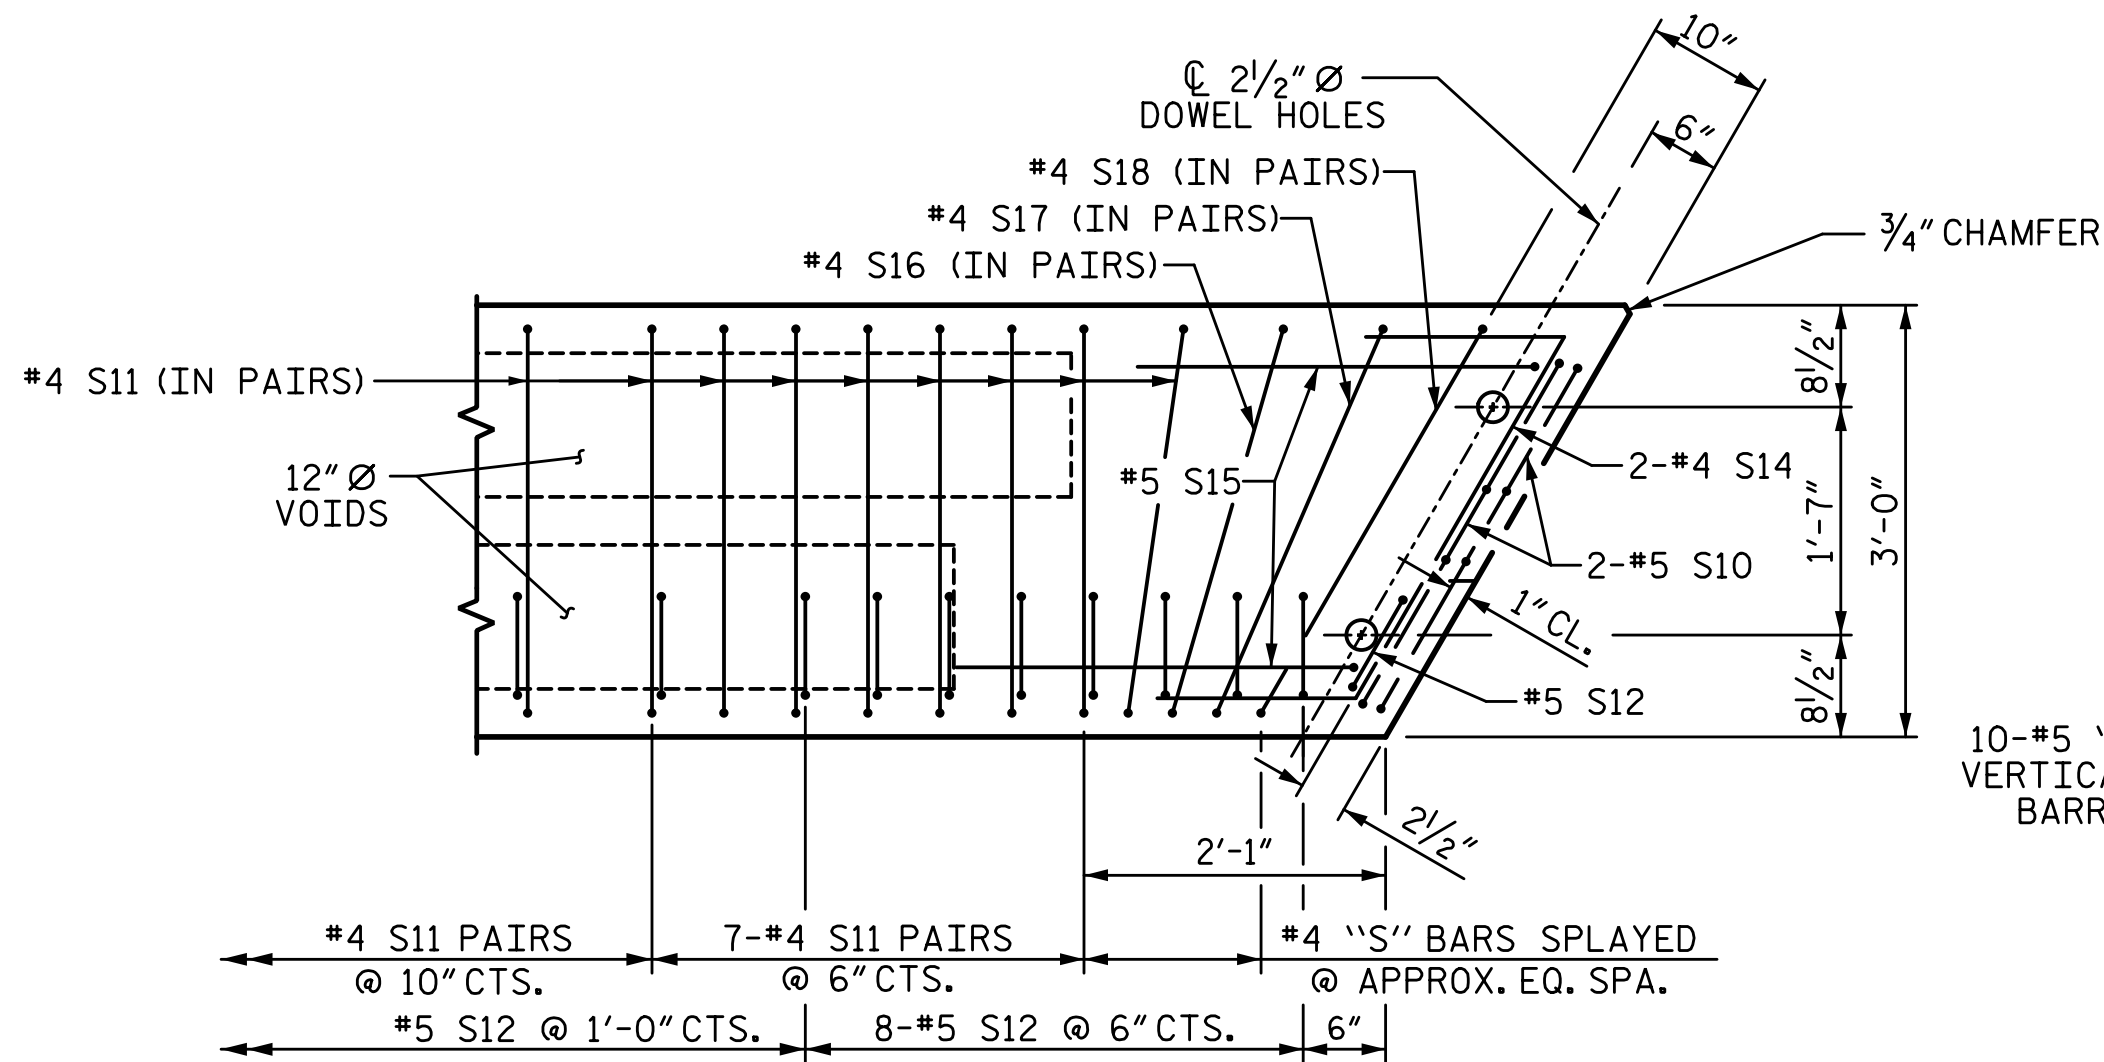

DETAIL "A"

(SIMILAR EACH END OF UNIT)  
NOTE: EXTERIOR UNIT SHOWN - INTERIOR  
UNIT SIMILAR EXCEPT OMIT #5 S12 BARS.

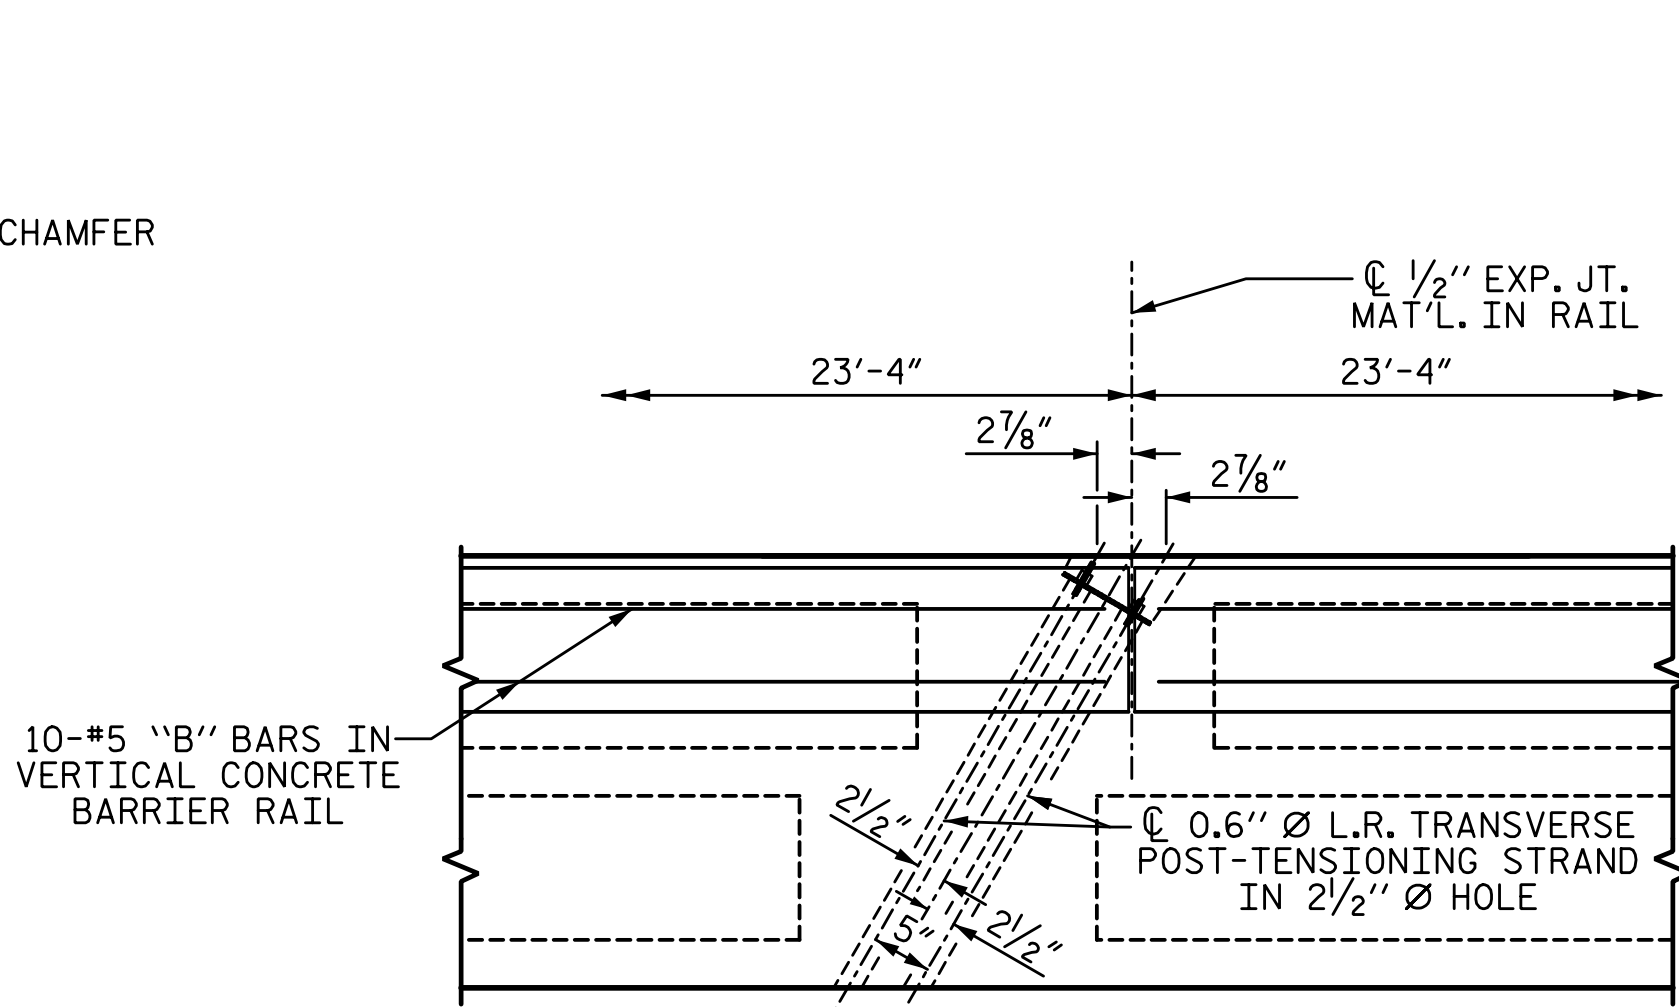

DETAIL "B"

#4 S11 BARS MAY BE SHIFTED AS NECESSARY  
TO MAINTAIN 1" CLEAR TO GROUDED RECESS AND  
2 1/2" Ø TRANSVERSE POST-TENSIONING STRAND HOLES

PLANS PREPARED BY:

**SEA & A**  
SIMPSON  
ENGINEERS  
& ASSOCIATES  
5640 Dillard Drive  
Suite 200  
Cary, NC 27518  
(919) 852-0468  
(919) 852-0598 (Fax)  
www.simpsonengr.com  
LICENSURE NO. C-2521



PROJECT NO. 17BP.7.R.94  
ORANGE COUNTY  
STATION: 13+22.00 -L-

SHEET 2 OF 3

STATE OF NORTH CAROLINA  
DEPARTMENT OF TRANSPORTATION  
RALEIGH  
SUPERSTRUCTURE  
PLAN OF SPAN A  
(70'-0" UNIT)  
27'-10" CLEAR ROADWAY  
120° SKEW


REVISIONS

NO.	BY:	DATE:	NO.	BY:	DATE:	SHEET NO.
1			3			S-5
2			4			TOTAL SHEETS 14

DOCUMENT NOT CONSIDERED FINAL  
UNLESS ALL SIGNATURES COMPLETED



3/6/2018 8:35:18 AM G:\Projects\2015\Division 7 (Hatch Mot+1)\17BP7R94 (Orange 51) (120 24CS VR)\Structures\Drawings\Final (revised)\401\_17BP7R94\_SMU\_SUPER.dgn

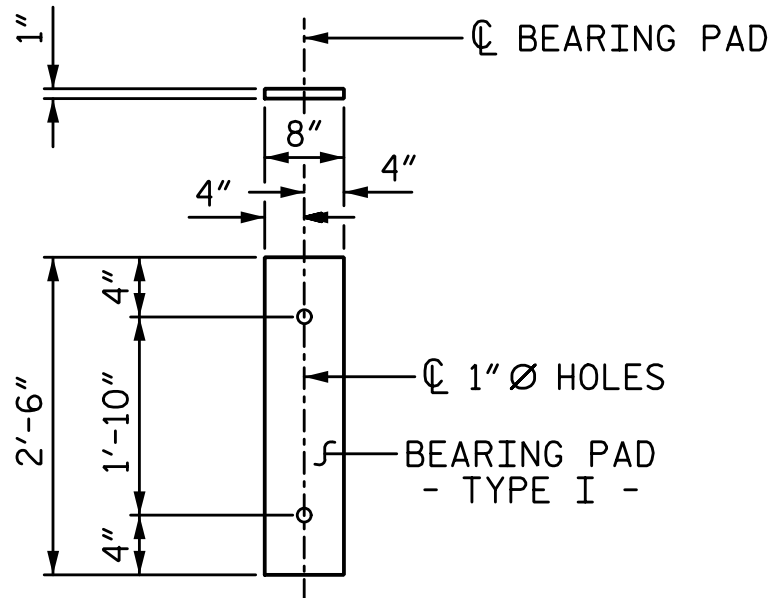

FIXED END  
(TYPE I - 20 REQ'D)

ELASTOMERIC  
BEARING DETAILS

ELASTOMER IN ALL BEARINGS SHALL  
BE 60 DUROMETER HARDNESS.

CONCRETE RELEASE STRENGTH	
UNIT	PSI
70' UNITS	5500

DEAD LOAD DEFLECTION AND CAMBER	
70' CORED SLAB UNIT	3'-0" x 2'-0"
CAMBER (SLAB ALONE IN PLACE)	0.6" Ø L.R. STRAND 2 1/4" ↑
DEFLECTION DUE TO SUPERIMPOSED DEAD LOAD**	3/4" ↓
FINAL CAMBER	1 1/2" ↑


\*\* INCLUDES FUTURE WEARING SURFACE

BILL OF MATERIAL FOR VERTICAL CONCRETE BARRIER RAIL						
BAR	BARS PER PAIR OF EXTERIOR UNITS	TOTAL NO.	SIZE	TYPE	LENGTH	WEIGHT
70' UNIT						
*B25	120	120	#5	STR	13'-8"	1711
*S13	158	158	#5	2	7'-2"	1181
* EPOXY COATED REINFORCING STEEL			LBS.		2892	
CLASS AA CONCRETE			CU.YDS.		18.1	
TOTAL VERTICAL CONCRETE BARRIER RAIL			LN. FT.		140.29	

GRADE 270 STRANDS	
AREA ( SQUARE INCHES )	0.6" Ø L.R.
ULTIMATE STRENGTH (LBS. PER STRAND )	58,600
APPLIED PRESTRESS (LBS. PER STRAND )	43,950

CORED SLABS REQUIRED			
	NUMBER	LENGTH	TOTAL LENGTH
70' UNIT			
EXTERIOR C.S.	2	70'-0"	140'-0"
INTERIOR C.S.	8	70'-0"	560'-0"
TOTAL	10	70'-0"	700'-0"

BAR TYPES

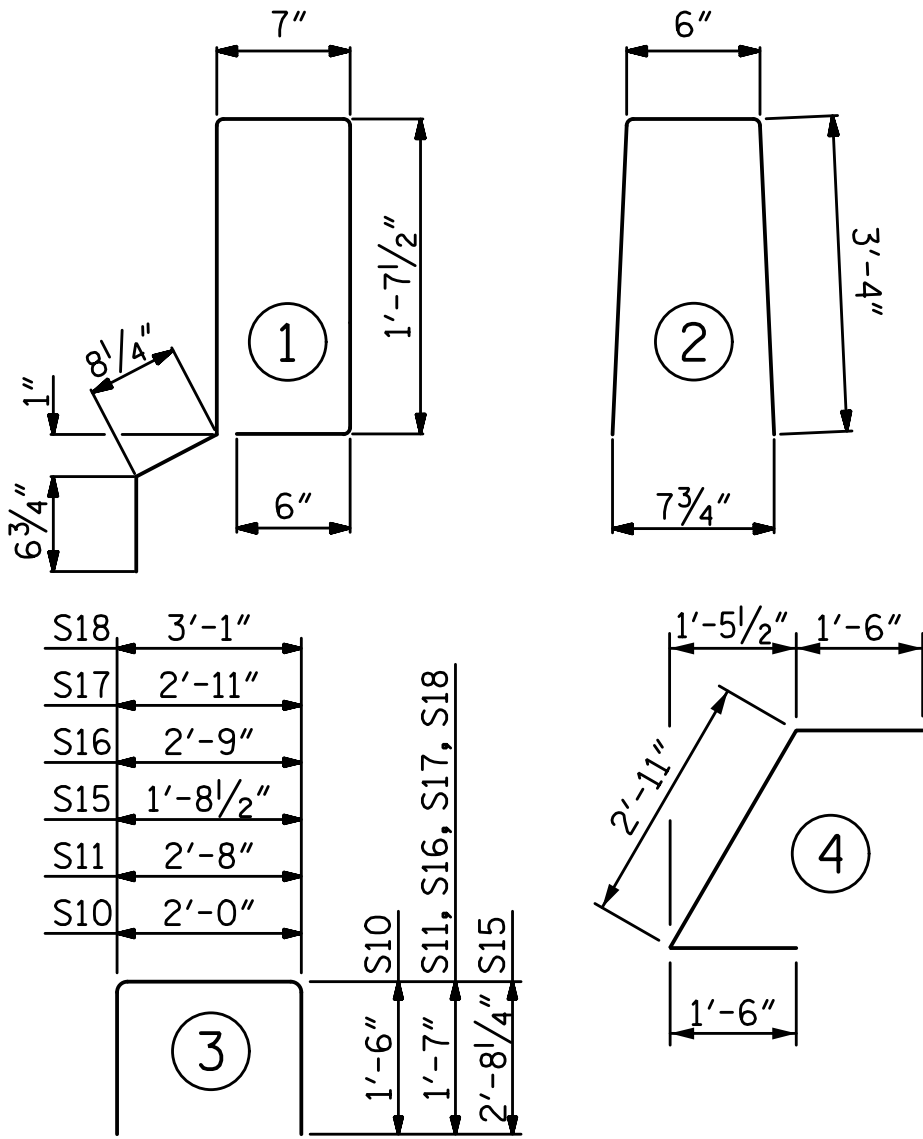


ALL BAR DIMENSIONS ARE OUT TO OUT

GUTTERLINE ASPHALT THICKNESS & RAIL HEIGHT


	ASPHALT OVERLAY THICKNESS @ MID-SPAN	RAIL HEIGHT @ MID-SPAN
70' UNITS	2"	3'-8"

BILL OF MATERIAL FOR ONE  
70' CORED SLAB UNIT


BAR	NUMBER	SIZE	TYPE	EXTERIOR UNIT		INTERIOR UNIT	
				LENGTH	WEIGHT	LENGTH	WEIGHT
B22	6	#4	STR	24'-6"	98	24'-6"	98
S10	8	#5	3	5'-0"	42	5'-0"	42
S11	170	#4	3	5'-10"	662	5'-10"	662
*S12	79	#5	1	5'-7"	460		
S14	4	#4	4	5'-11"	16	5'-11"	16
S15	4	#5	3	7'-1"	30	7'-1"	30
S16	4	#4	3	5'-11"	16	5'-11"	16
S17	4	#4	3	6'-1"	16	6'-1"	16
S18	4	#4	3	6'-3"	17	6'-3"	17
REINFORCING STEEL				LBS.		897	
* EPOXY COATED REINFORCING STEEL				LBS.		460	
7000 P.S.I. CONCRETE				CU. YDS.		12.0	
0.6" Ø L.R. STRANDS				No.		28	

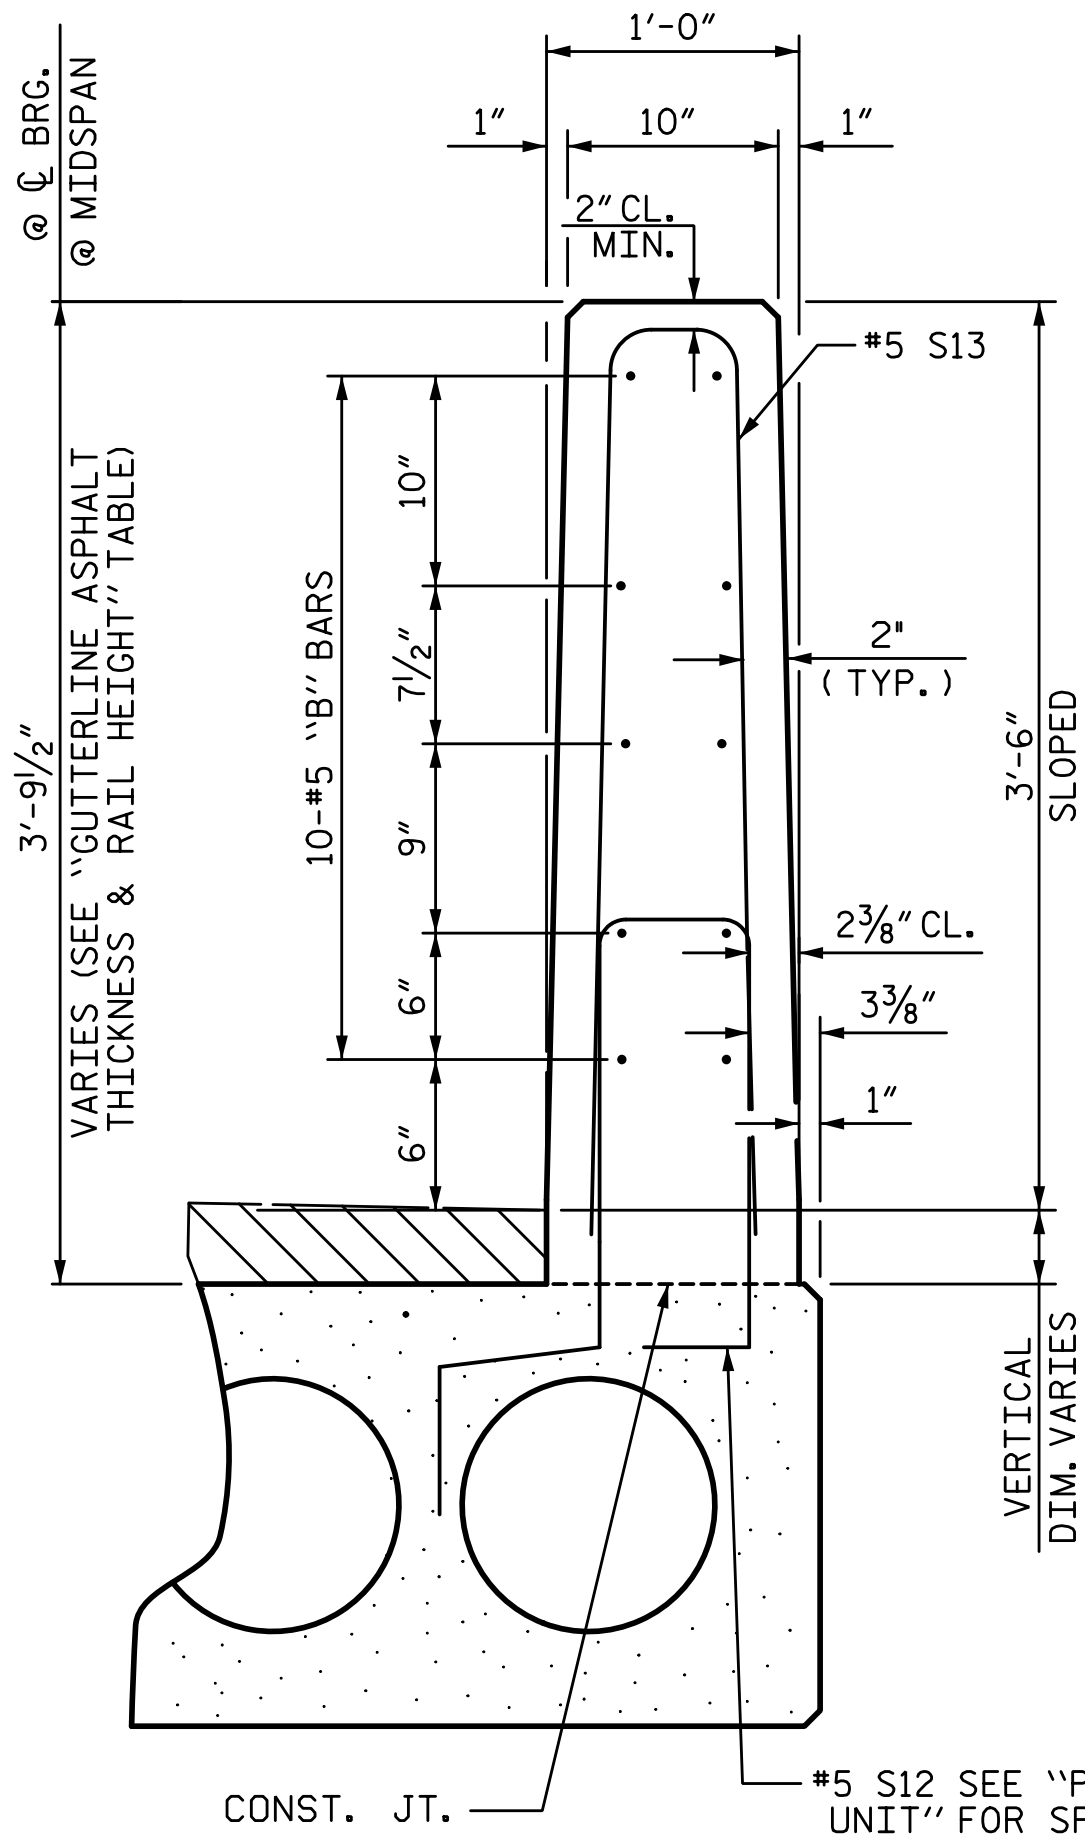

SECTION THRU RAIL

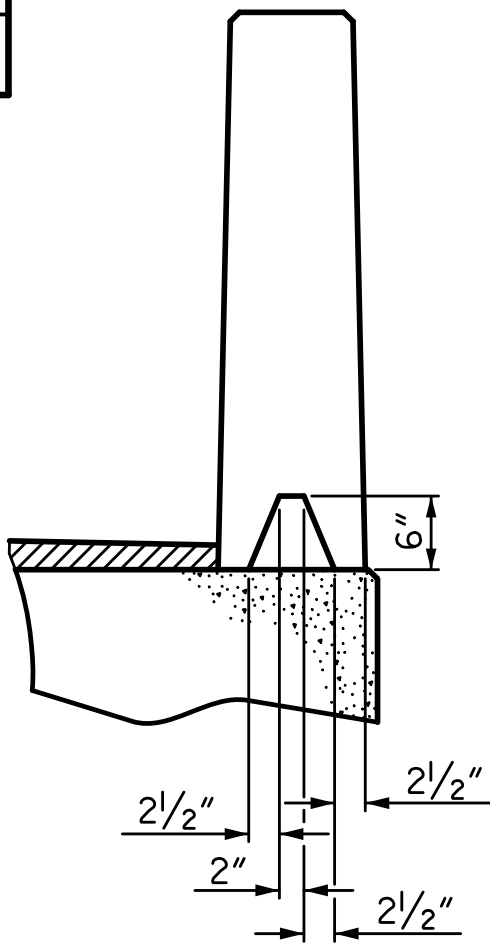


SECTION S-S  
AT DAM IN OPEN JOINT  
(THIS IS TO BE USED ONLY  
WHEN SLIP FORM IS USED)

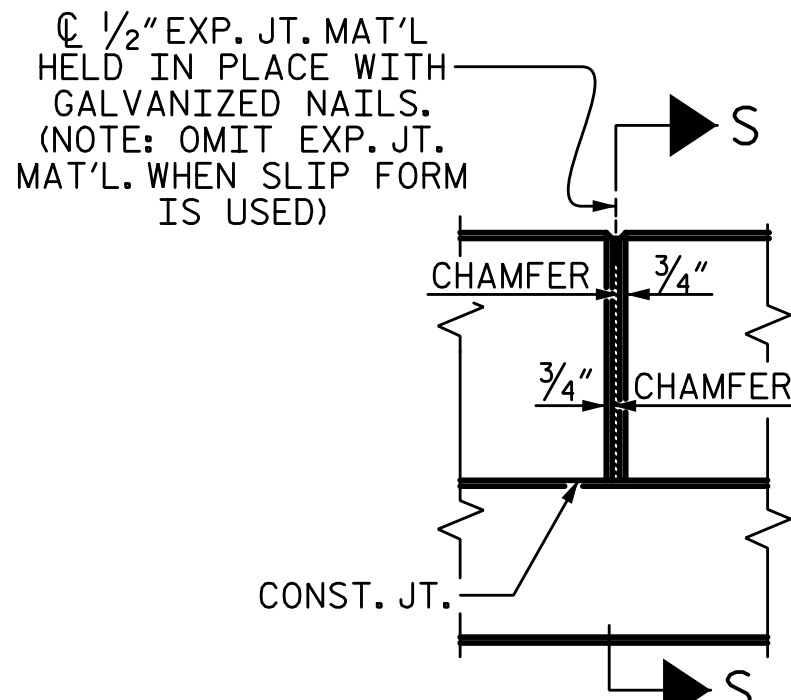

ELEVATION AT EXPANSION JOINTS

VERTICAL CONCRETE  
BARRIER RAIL DETAILS

DRAWN BY: T. BANKOVICH	DATE: 3-18
CHECKED BY: B.S. COX	DATE: 3-18
DESIGN ENGINEER OF RECORD: B.S. COX	DATE: 3-18

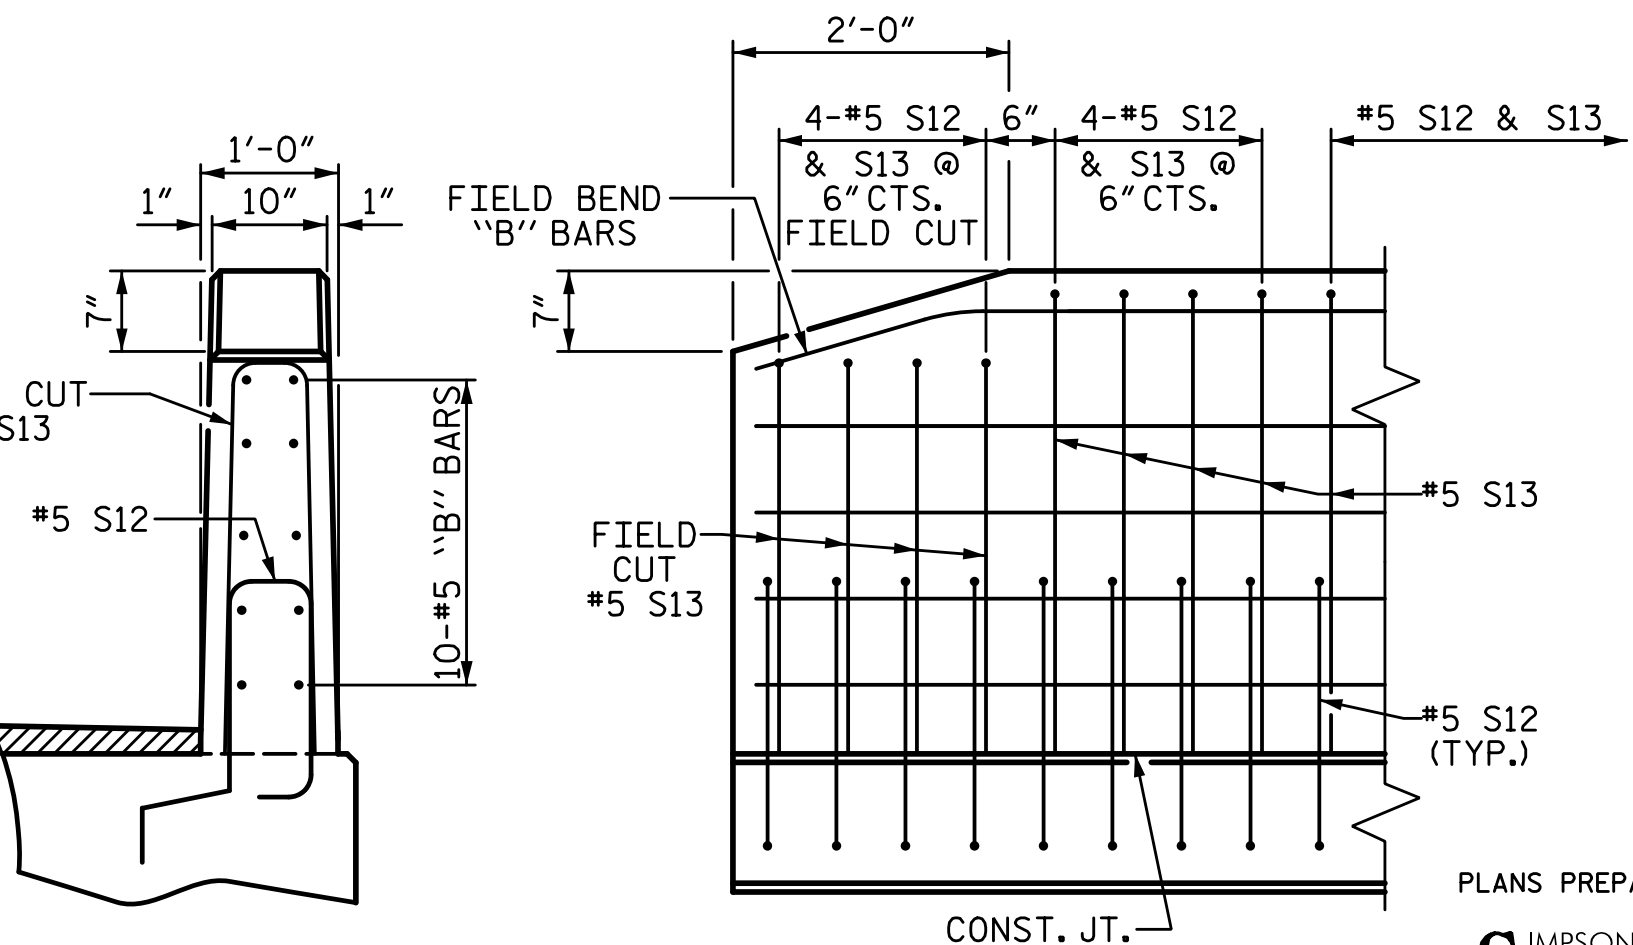

END VIEW

SIDE VIEW

END OF RAIL DETAILS

NOTES:

ALL PRESTRESSING STRANDS SHALL BE 7-WIRE LOW RELAXATION GRADE 270 STRANDS AND SHALL CONFORM TO AASHTO M203 EXCEPT FOR SAMPLING REQUIREMENTS WHICH SHALL BE IN ACCORDANCE WITH THE STANDARD SPECIFICATIONS.

ALL REINFORCING STEEL CAST WITH THE CORED SLAB SECTIONS SHALL BE GRADE 60 AND SHALL BE INCLUDED IN THE UNIT PRICE BID FOR PRESTRESSED CONCRETE CORED SLABS.

RECESSES FOR TRANSVERSE STRANDS SHALL BE GROUTED AFTER THE TENSIONING OF THE STRANDS.

THE 2 1/2" Ø DOWEL HOLES AT FIXED ENDS OF SLAB SECTIONS SHALL BE FILLED WITH NON-SHRINK GROUT.

THE BACKER RODS SHALL CONFORM TO THE REQUIREMENTS OF TYPE M BOND BREAKER. SEE SECTION 1028 OF THE STANDARD SPECIFICATIONS.

WHEN CORED SLABS ARE CAST, AN INTERNAL HOLD-DOWN SYSTEM SHALL BE EMPLOYED TO PREVENT VOIDS FROM RISING OR MOVING SIDEWAYS. AT LEAST SIX WEEKS PRIOR TO CASTING CORED SLABS, THE CONTRACTOR SHALL SUBMIT TO THE ENGINEER FOR REVIEW AND COMMENT, DETAILED DRAWINGS OF THE PROPOSED HOLD-DOWN SYSTEM. IN ADDITION TO STRUCTURAL DETAILS, LOCATION AND SPACING OF THE HOLD-DOWNS SHALL BE INDICATED.

THE TRANSFER OF LOAD FROM THE ANCHORAGES TO THE CORED SLAB UNIT SHALL BE DONE WHEN THE CONCRETE HAS REACHED A COMPRESSIVE STRENGTH OF NOT LESS THAN THE REQUIRED STRENGTH SHOWN IN THE "CONCRETE RELEASE STRENGTH" TABLE.

ALL REINFORCING STEEL IN VERTICAL CONCRETE BARRIER RAILS SHALL BE EPOXY COATED.

PRESTRESSING STRANDS SHALL BE CUT FLUSH WITH THE CORED SLAB UNIT ENDS.

APPLY EPOXY PROTECTIVE COATING TO CORED SLAB UNIT ENDS.

GROOVED CONTRACTION JOINTS, 1/2" IN DEPTH, SHALL BE TOOLED IN ALL EXPOSED FACES OF THE BARRIER RAIL AND IN ACCORDANCE WITH ARTICLE 825-10(B) OF THE STANDARD SPECIFICATIONS. A CONTRACTION JOINT SHALL BE LOCATED AT EACH THIRD POINT BETWEEN BARRIER RAIL EXPANSION JOINTS. ONLY ONE CONTRACTION JOINT IS REQUIRED AT MIDPOINT OF BARRIER RAIL SEGMENTS LESS THAN 20 FEET IN LENGTH AND NO CONTRACTION JOINTS ARE REQUIRED FOR THOSE SEGMENTS LESS THAN 10 FEET IN LENGTH.

FLAME CUTTING OF THE TRANSVERSE POST-TENSIONING STRAND IS NOT ALLOWED.

MAINTAIN A SYMMETRIC TENSION FORCE BETWEEN EACH PAIR OF TRANSVERSE POST TENSIONING STRANDS IN THE DIAPHRAGM.

THE #4 S11 STIRRUPS MAY BE SHIFTED AS NECESSARY TO MAINTAIN 1" CLEAR TO THE GROUTED RECESS.

FOR GROUT FOR STRUCTURES, SEE SPECIAL PROVISIONS.

THE PERMITTED THREADED INSERTS ARE DETAILED AS AN OPTION FOR THE CONTRACTOR TO ATTACH FALSEWORK AND FORMWORK DURING CONSTRUCTION.

THE PERMITTED THREADED INSERTS IN THE EXTERIOR UNITS SHALL BE SIZED BY THE CONTRACTOR, SPACED AT 4'-0" CENTERS AND GALVANIZED IN ACCORDANCE WITH SECTION 1076 OF THE STANDARD SPECIFICATIONS. STAINLESS STEEL THREADED INSERTS MAY BE USED AS AN ALTERNATE.

THE PERMITTED THREADED INSERTS SHALL BE GROUTED BY THE CONTRACTOR IMMEDIATELY FOLLOWING REMOVAL OF THE FALSEWORK.

THE COST OF THE PERMITTED THREADED INSERTS SHALL BE INCLUDED IN THE PRICE BID FOR THE PRECAST UNITS.

PROJECT NO. 17BP.7.R.94  
ORANGE COUNTY  
STATION: 13+22.00 -L-


SHEET 3 OF 3

STATE OF NORTH CAROLINA  
DEPARTMENT OF TRANSPORTATION  
RALEIGH  
SUPERSTRUCTURE  
3'-0" X 2'-0"  
PRESTRESSED CONCRETE  
CORED SLAB UNIT  
120° SKEW

REVISIONS						SHEET NO. S-6
NO.	BY:	DATE:	NO.	BY:	DATE:	
1			3			TOTAL SHEETS 14
2			4			

PLANS PREPARED BY:




SEMPSON  
& ASSOCIATES  
5640 Dillard Drive  
Suite 200  
Cary, NC 27518  
(919) 852-0468  
(919) 852-0598 (Fax)  
www.simpsonengr.com  
LICENSURE NO. C-2521

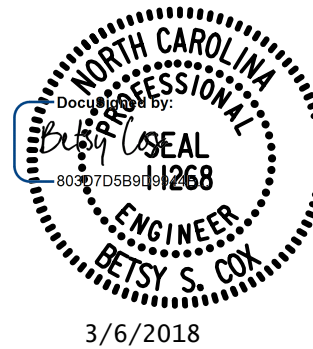


DOCUMENT NOT CONSIDERED FINAL  
UNLESS ALL SIGNATURES COMPLETED



3/6/2018 8:35:18 AM G:\Projects\2015\Division 7 (Hatch Mott)\17BP7R94 (Orange 51) (120 24CS VR)\Structures\Drawings\Final (revised)\401\_17BP7R94\_SMJ\_SUPER.dgn

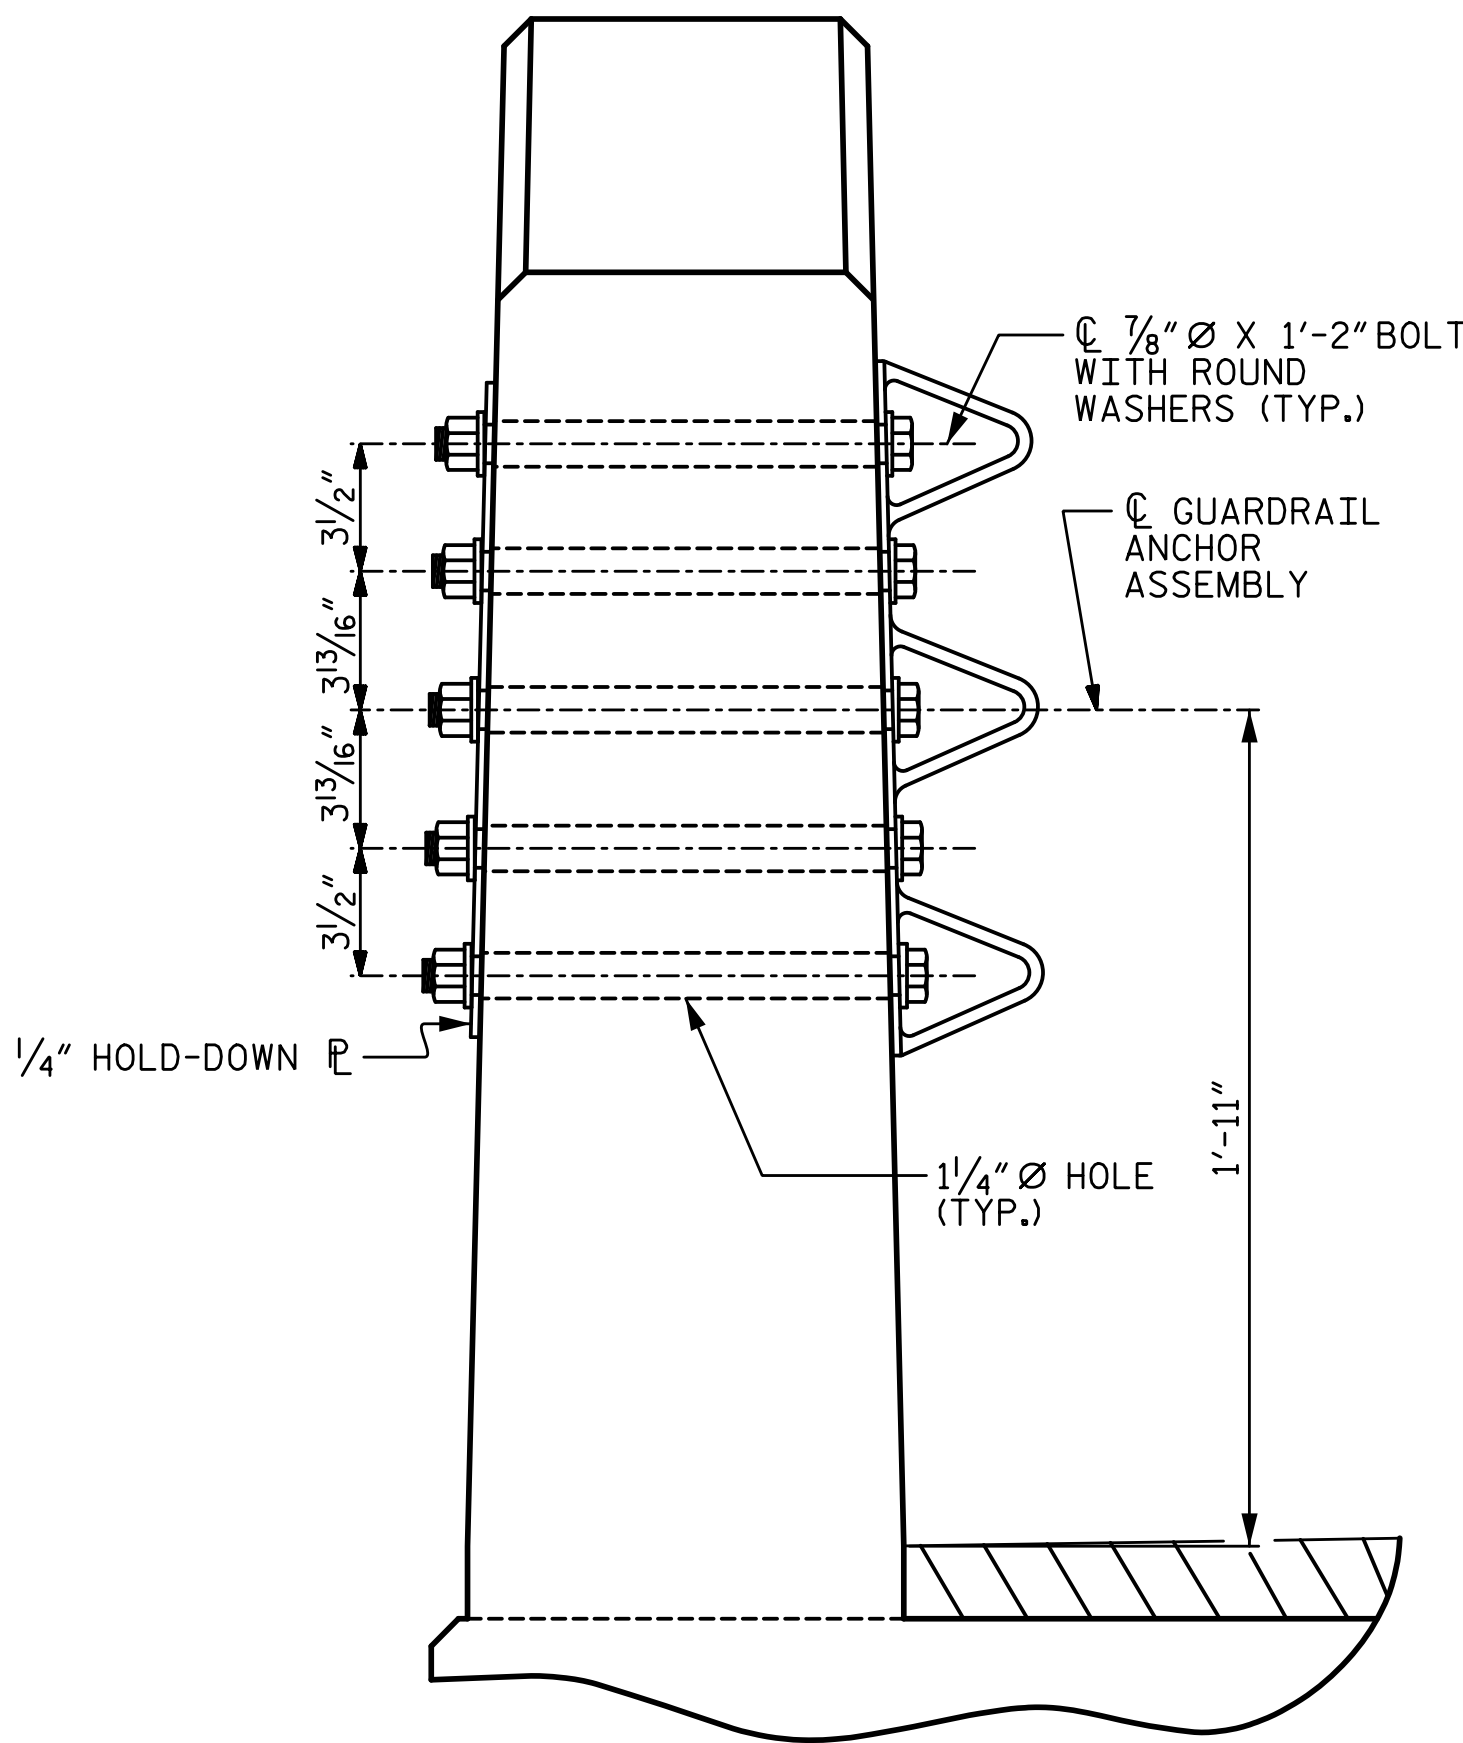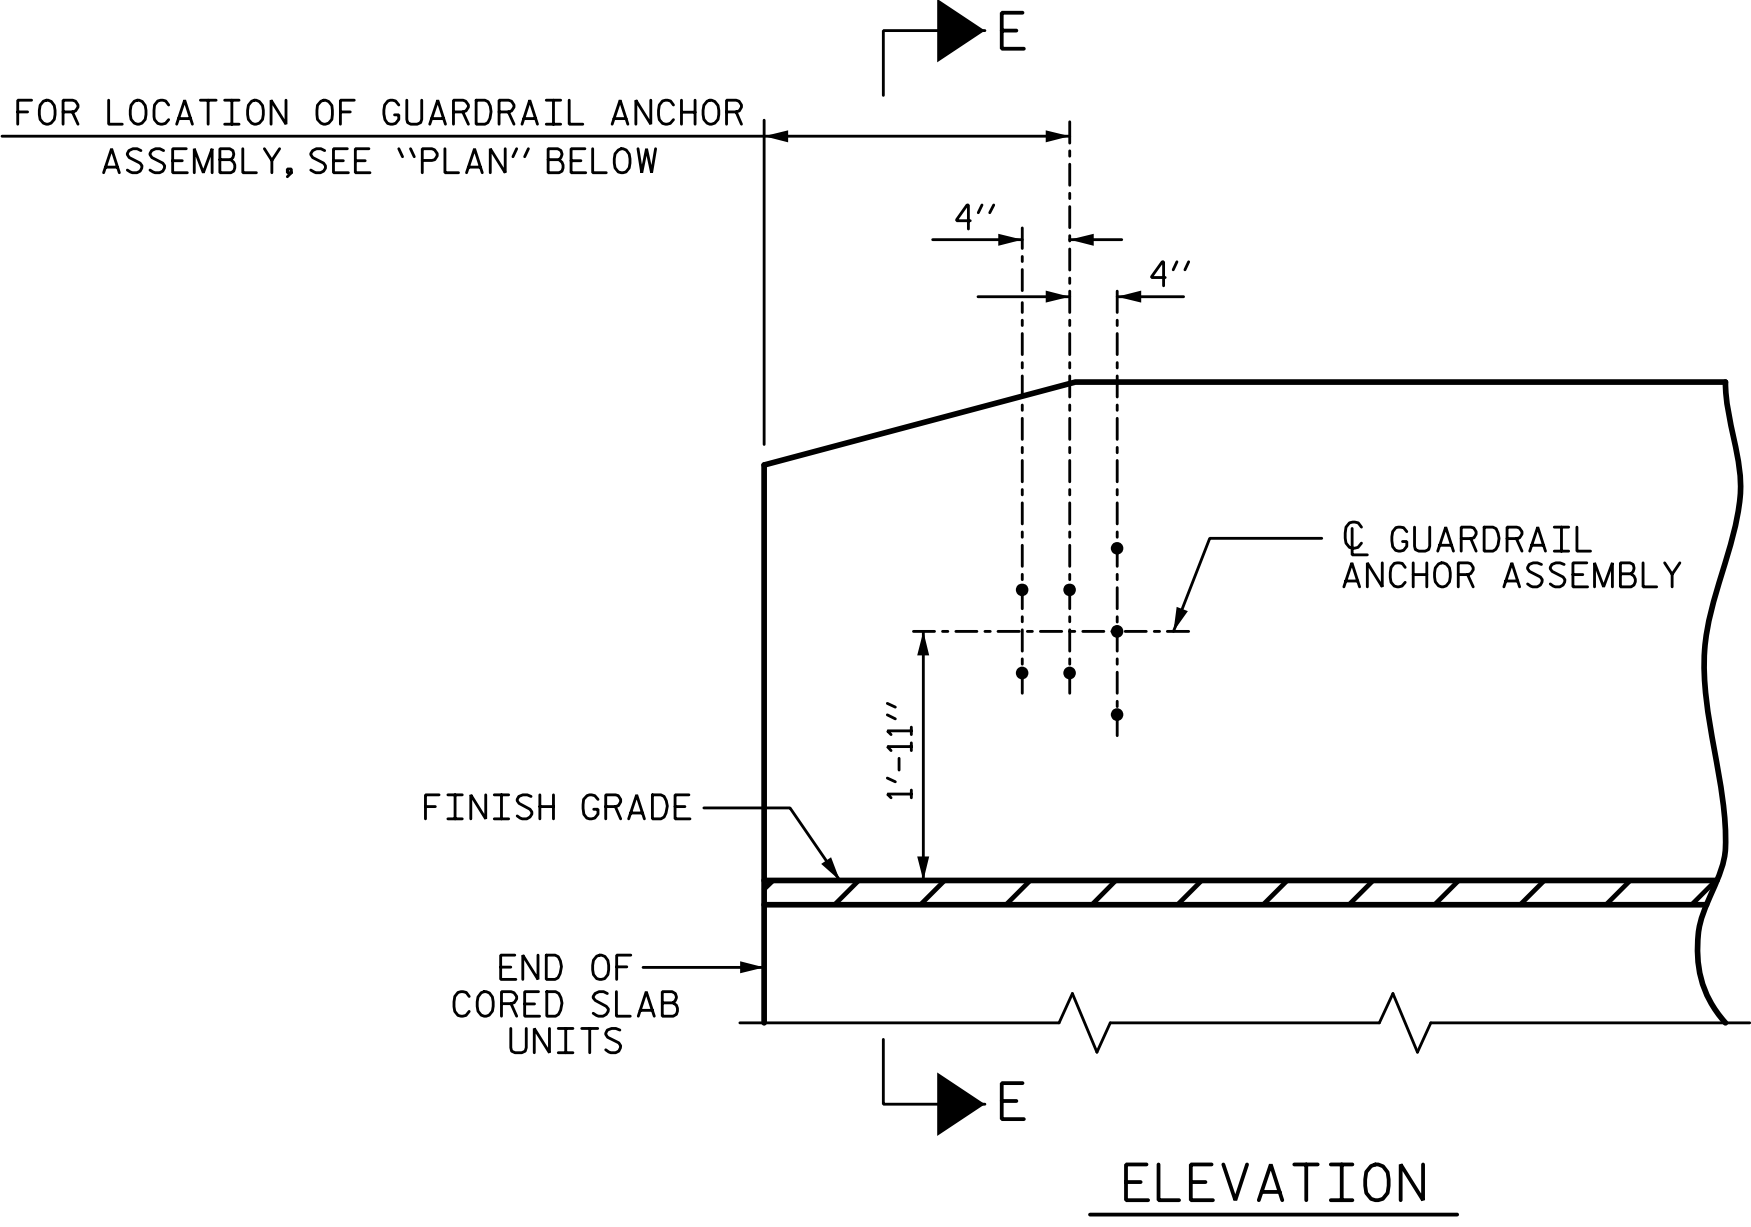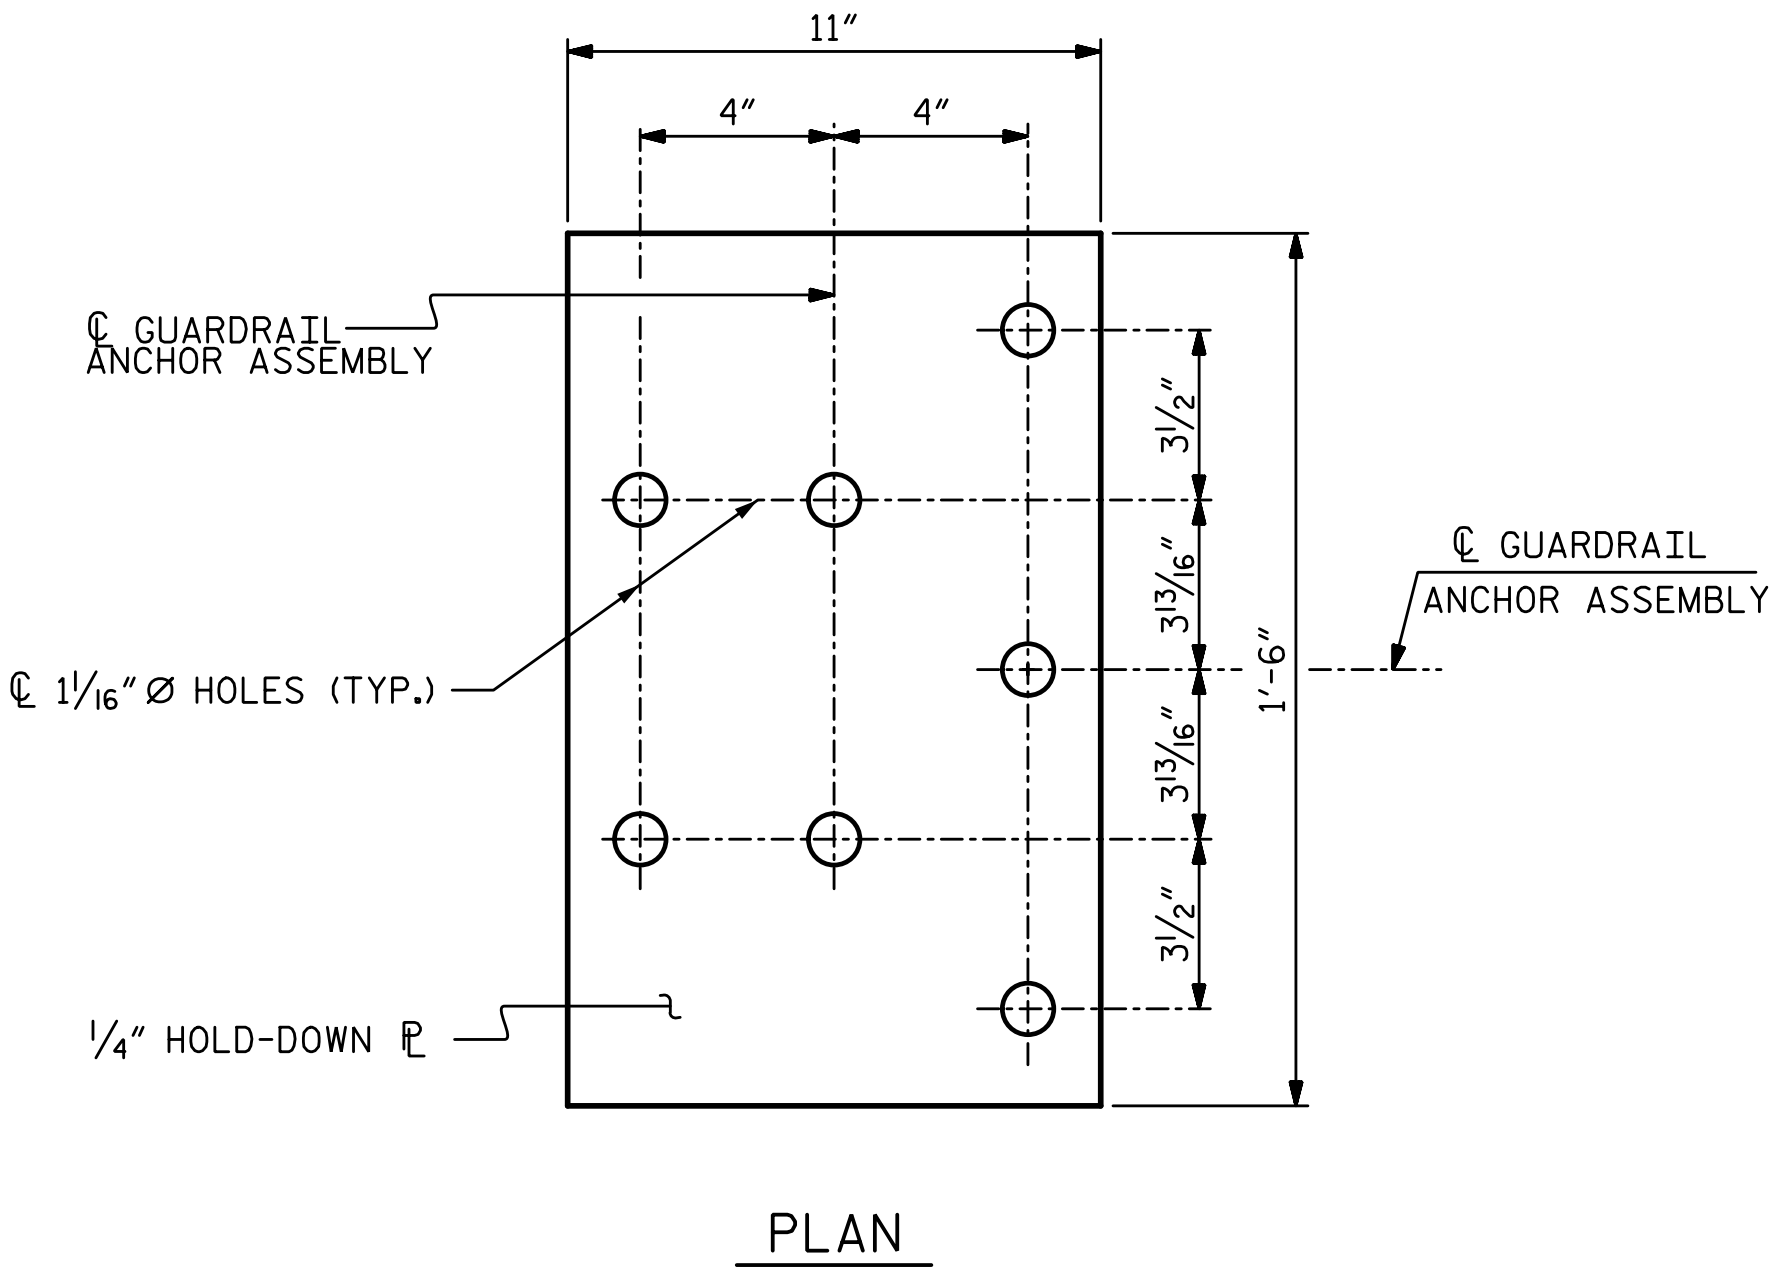

SECTION E-E  
GUARDRAIL ANCHOR ASSEMBLY DETAILS

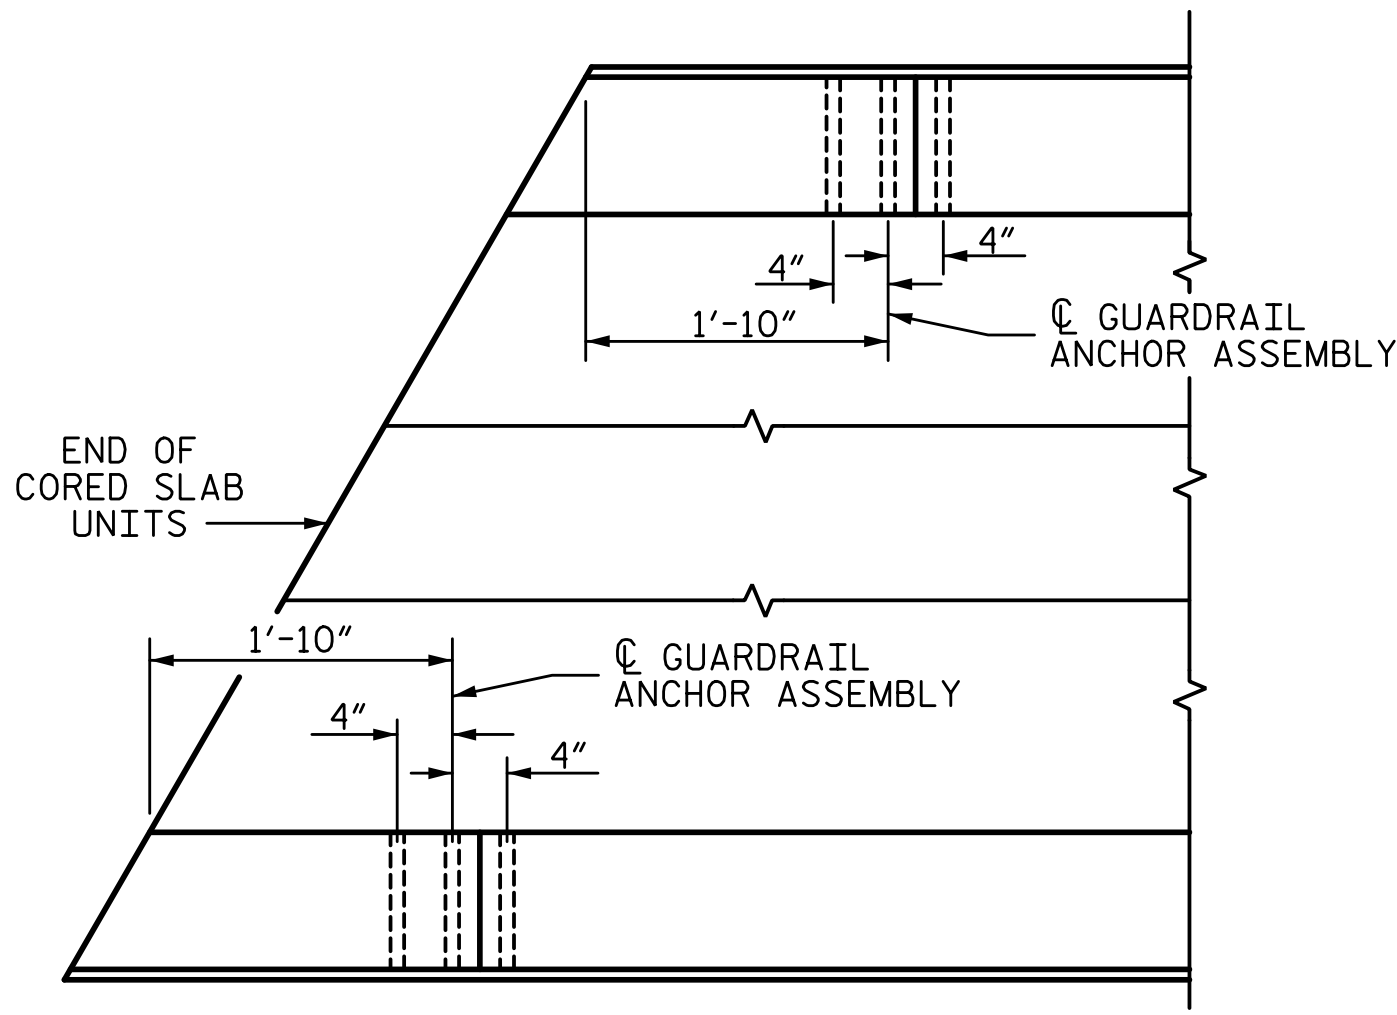

PLAN  
LOCATION OF  
ANCHORS FOR GUARDRAIL  
(END BENT 1 SHOWN, END BENT 2 SIMILAR.)

NOTES:

THE GUARDRAIL ANCHOR ASSEMBLY SHALL CONSIST OF A 1/4" HOLD DOWN PLATE AND 7 - 1/8" Ø BOLTS WITH NUTS AND WASHERS.

THE HOLD-DOWN PLATE SHALL CONFORM TO AASHTO M270 GRADE 36. AFTER FABRICATION, THE HOLD-DOWN PLATE SHALL BE HOT-DIP GALVANIZED IN ACCORDANCE WITH AASHTO M111.

BOLTS SHALL CONFORM TO THE REQUIREMENTS OF ASTM A307 AND NUTS SHALL CONFORM TO THE REQUIREMENTS OF AASHTO M291. BOLTS, NUTS AND WASHERS SHALL BE GALVANIZED. (AT THE CONTRACTOR'S OPTION, STAINLESS STEEL BOLTS, NUTS AND WASHERS MAY BE USED AS AN ALTERNATE FOR THE 1/8" Ø GALVANIZED BOLTS, NUTS AND WASHERS. THEY SHALL CONFORM TO OR EXCEED THE MECHANICAL REQUIREMENTS OF ASTM A307. THE USE OF THIS ALTERNATE SHALL BE APPROVED BY THE ENGINEER.)


THE GUARDRAIL ANCHOR ASSEMBLY IS REQUIRED AT ALL POINTS WHERE APPROACH GUARDRAIL IS TO BE ATTACHED TO THE END OF BARRIER RAIL. FOR POINTS OF ATTACHMENT, SEE SKETCH.

AFTER INSTALLATION, THE EXPOSED THREAD OF THE BOLT SHALL BE BURRED WITH A SHARP POINTED TOOL.

THE COST OF THE GUARDRAIL ANCHOR ASSEMBLY SHALL BE INCLUDED IN THE UNIT CONTRACT PRICE BID FOR VERTICAL CONCRETE BARRIER RAIL.

THE VERTICAL REINFORCING BARS MAY BE SHIFTED SLIGHTLY IN THE VERTICAL CONCRETE BARRIER RAIL TO CLEAR ASSEMBLY BOLTS.

THE 1 1/4" Ø HOLES SHALL BE FORMED OR DRILLED WITH A CORE BIT. IMPACT TOOLS WILL NOT BE PERMITTED. ANY CONCRETE DAMAGED BY THIS WORK SHALL BE REPAIRED TO THE SATISFACTION OF THE ENGINEER.

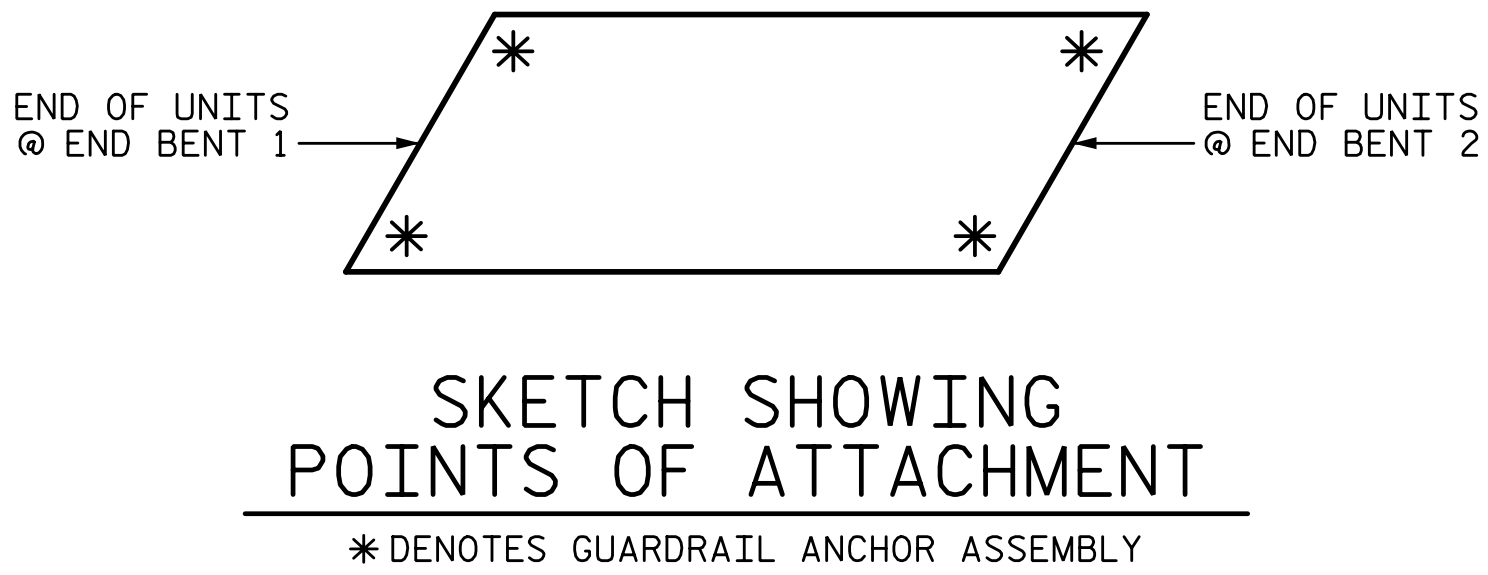

PROJECT NO. 17BP.7.R.94  
ORANGE COUNTY  
STATION: 13+22.00 -L-

DRAWN BY: T. BANKOVICH	DATE: 3-18
CHECKED BY: B.S. COX	DATE: 3-18
DESIGN ENGINEER OF RECORD: B.S. COX	DATE: 3-18


PLANS PREPARED BY:  
**SE & A**  
SIMPSON ENGINEERS & ASSOCIATES  
5640 Dillard Drive  
Suite 200  
Cary, NC 27518  
(919) 852-0468  
(919) 852-0598 (Fax)  
www.simpsonengr.com  
LICENSURE NO. C-2521




REVISIONS						SHEET NO. S-7
NO.	BY:	DATE:	NO.	BY:	DATE:	
1			3			TOTAL SHEETS 14
2			4			

DOCUMENT NOT CONSIDERED FINAL  
UNLESS ALL SIGNATURES COMPLETED



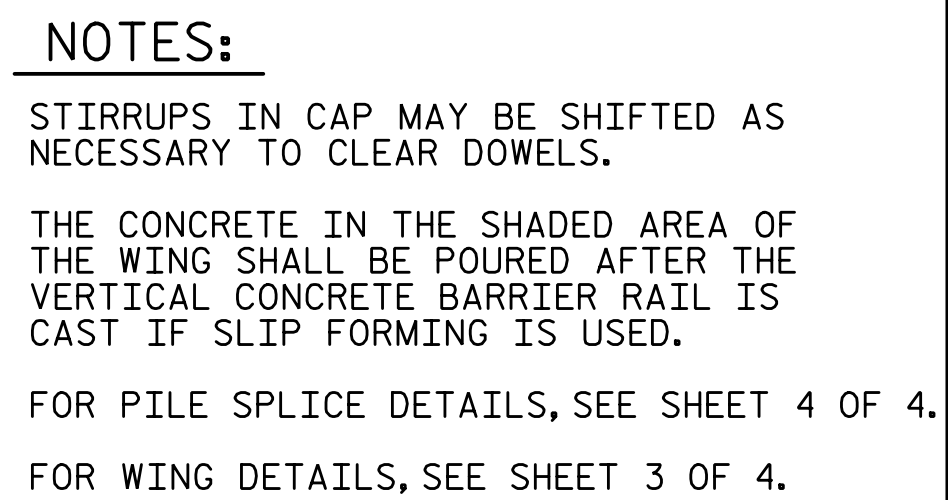

TOP OF PILE ELEVATIONS	
①	530.91
②	530.85
③	530.79
④	530.72
⑤	530.66

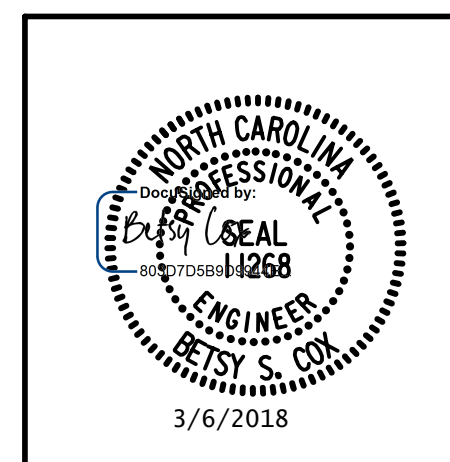

PROJECT NO. 17BP.7.R.94  
ORANGE COUNTY  
 STATION: 13+22.00 -L-

SHEET 1 OF 4

STATE OF NORTH CAROLINA  
DEPARTMENT OF TRANSPORTATION  
RALEIGH  
SUBSTRUCTURE

END BENT 1


REVISIONS						SHEET NO. S-8
NO.	BY:	DATE:	NO.	BY:	DATE:	
1			3			TOTAL SHEETS 14
2			4			

DRAWN BY: T. BANKOVICH DATE: 3-18  
 CHECKED BY: B.S. COX DATE: 3-18  
 DESIGN ENGINEER OF RECORD: B.S. COX DATE: 3-18


WINGS NOT SHOWN FOR CLARITY.  
FOR SECTION A-A, SEE SHEET 4 OF 4.  
CONCRETE COLLARS FOR STEEL PILES NOT SHOWN IN PLAN AND ELEVATION VIEWS FOR CLARITY.  
SEE "CORROSION PROTECTION FOR STEEL PILES DETAIL", SHEET 4 OF 4.

**DOCUMENT NOT CONSIDERED FINAL  
UNLESS ALL SIGNATURES COMPLETED**

3/6/2018 8:35:19 AM G:\Projects\2015\Division 7 (Hatch Mot)\17BP7R94 (Orange 51) (20 24CS VR)\Structures\Drawings\Final (revised)\401.17BP7R94\_SMJ\_EB.dgn

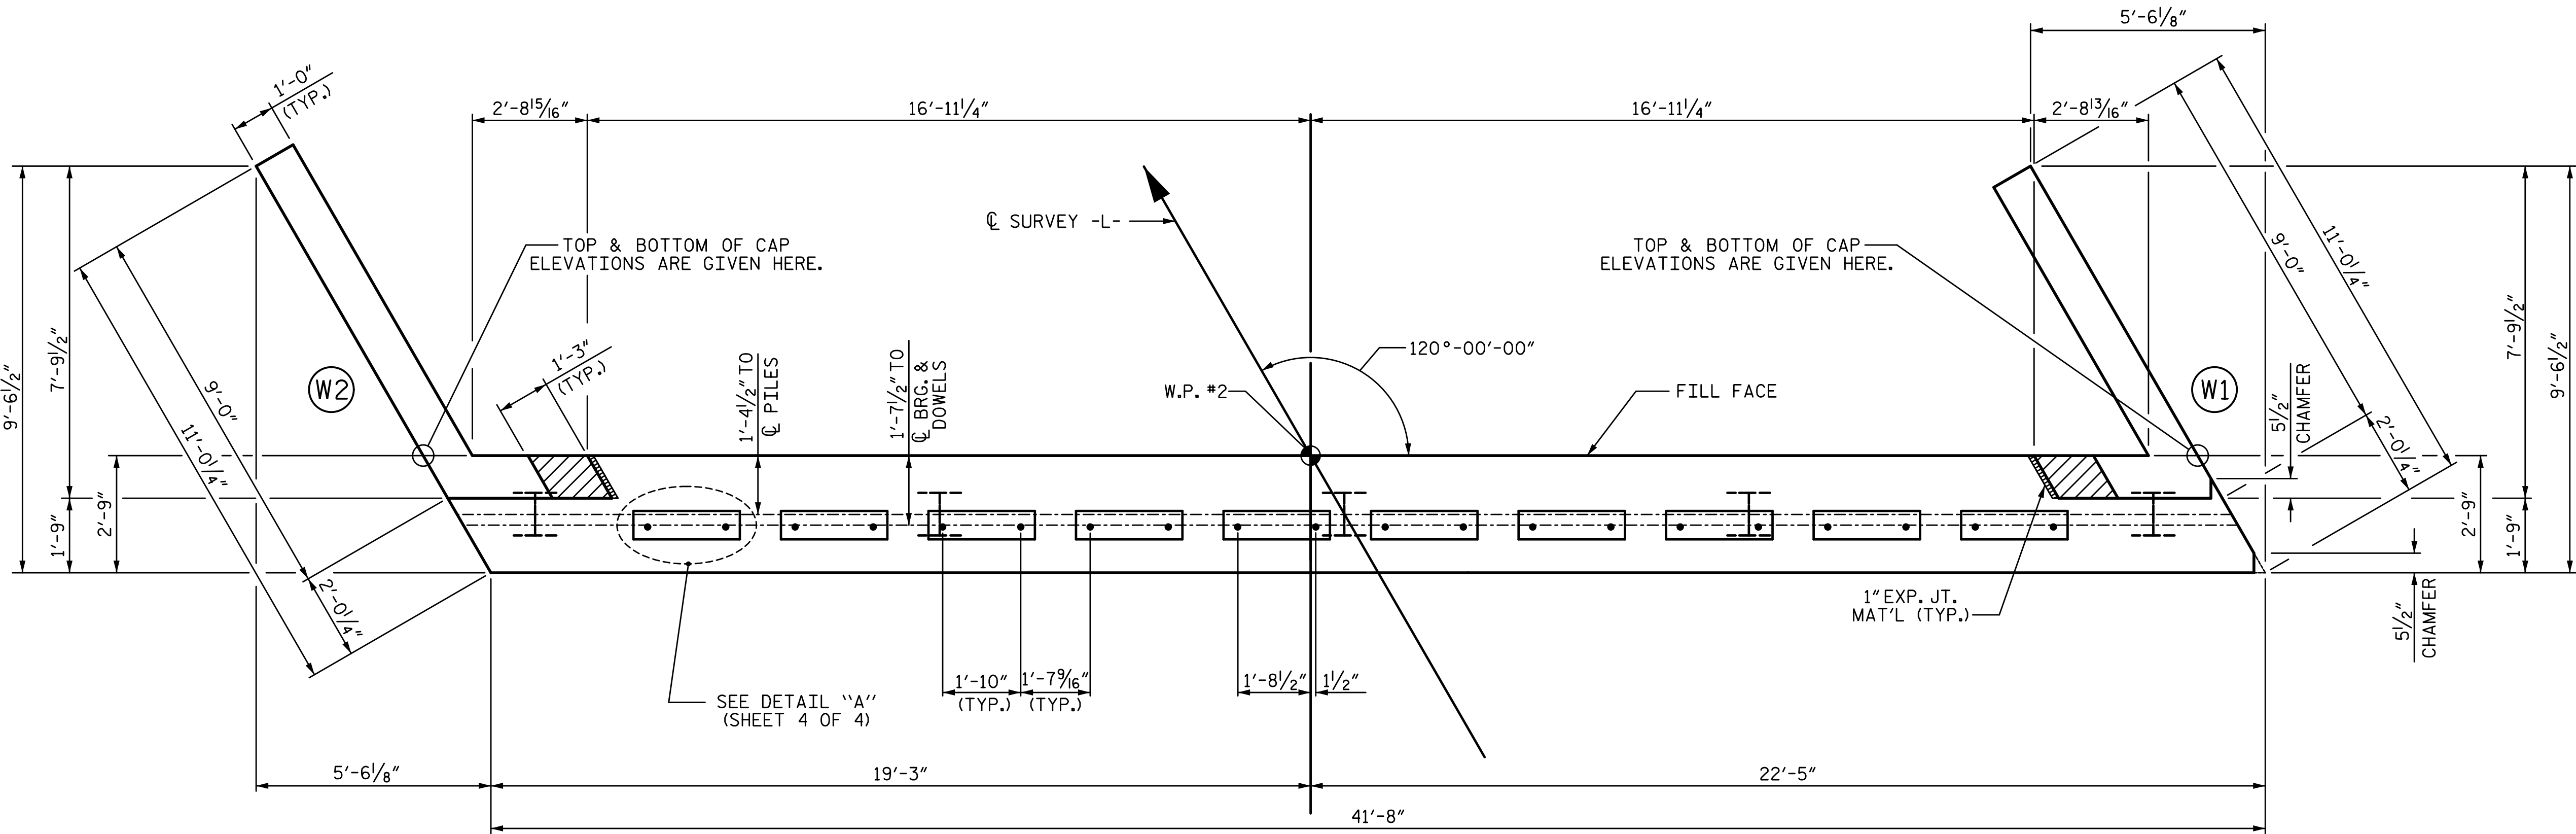

PLAN

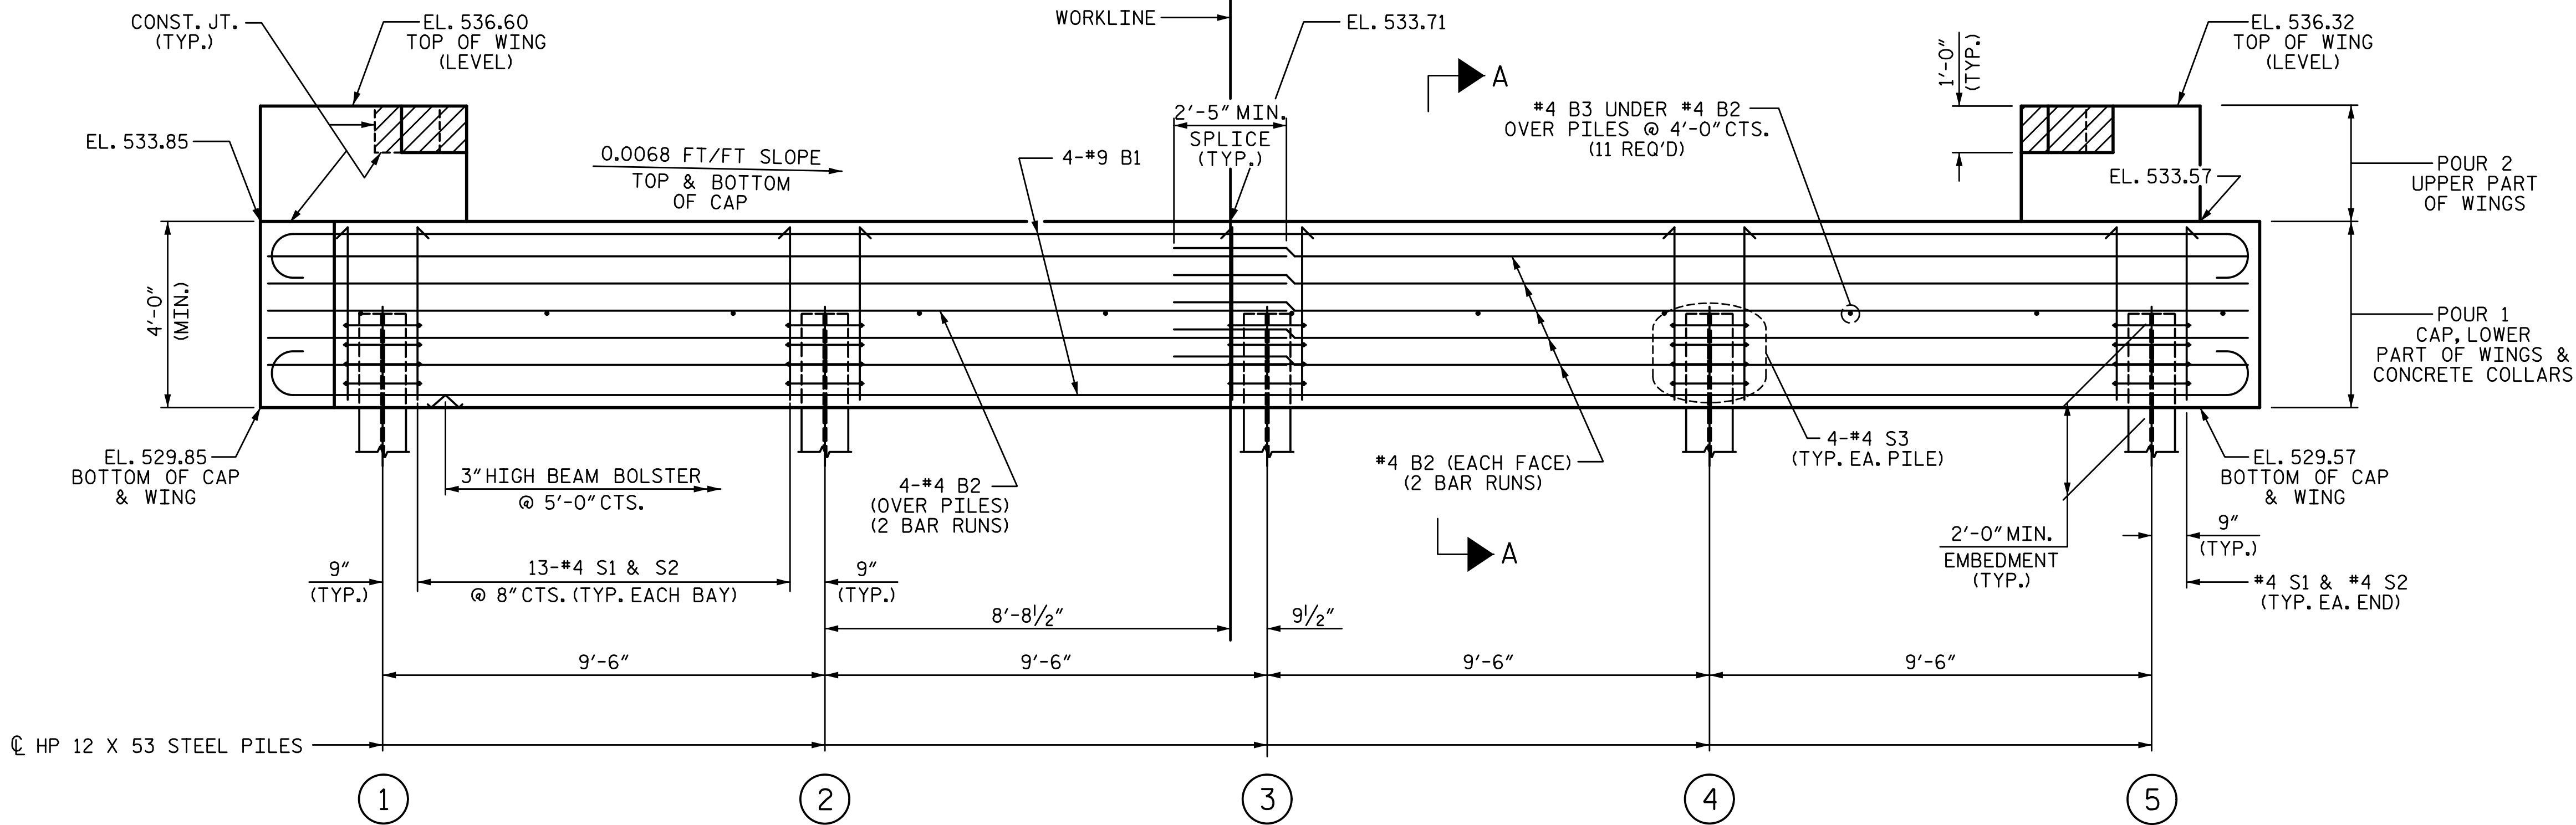

ELEVATION

WINGS NOT SHOWN FOR CLARITY.  
FOR SECTION A-A, SEE SHEET 4 OF 4.  
CONCRETE COLLARS FOR STEEL PILES NOT SHOWN IN PLAN AND ELEVATION VIEWS FOR CLARITY.  
SEE "CORROSION PROTECTION FOR STEEL PILES DETAIL", SHEET 4 OF 4.

NOTES:

STIRRUPS IN CAP MAY BE SHIFTED AS NECESSARY TO CLEAR DOWELS.

THE CONCRETE IN THE SHADED AREA OF THE WING SHALL BE POURED AFTER THE VERTICAL CONCRETE BARRIER RAIL IS CAST IF SLIP FORMING IS USED.

FOR PILE SPLICE DETAILS, SEE SHEET 4 OF 4.

FOR WING DETAILS, SEE SHEET 3 OF 4.

TOP OF PILE ELEVATIONS

①	531.84
②	531.77
③	531.71
④	531.65
⑤	531.58

PROJECT NO. 17BP.7.R.94  
ORANGE COUNTY  
STATION: 13+22.00 -L-

SHEET 2 OF 4

STATE OF NORTH CAROLINA  
DEPARTMENT OF TRANSPORTATION  
RALEIGH  
SUBSTRUCTURE

END BENT 2

REVISIONS

NO.	BY:	DATE:	NO.	BY:	DATE:
1			3		
2			4		

SHEET NO.

S-9

TOTAL

SHEETS

14

PLANS PREPARED BY:

SIMPSON  
ENGINEERS  
& ASSOCIATES  
5640 Dillard Drive  
Suite 200  
Cary, NC 27518  
(919) 852-0468  
(919) 852-0598 (Fax)  
www.simpsonengr.com

LICENSURE NO. C-2521

NORTH CAROLINA  
PROFESSIONAL  
ENGINEER  
BETSY S. COX  
3/6/2018


DOCUMENT NOT CONSIDERED FINAL  
UNLESS ALL SIGNATURES COMPLETED

DRAWN BY: T. BANKOVICH  
CHECKED BY: B.S. COX  
DESIGN ENGINEER OF RECORD: B.S. COX


DATE: 3-18  
DATE: 3-18  
DATE: 3-18




3/6/2018 8:35:19 AM G:\Projects\2015\Division 7 (Hatch Mott)\17BP7R94 (Orange 51)\20 24CS VR\Structures\Drawings\Final (revised)\401\_17BP7R94\_SMJ\_EB.dgn

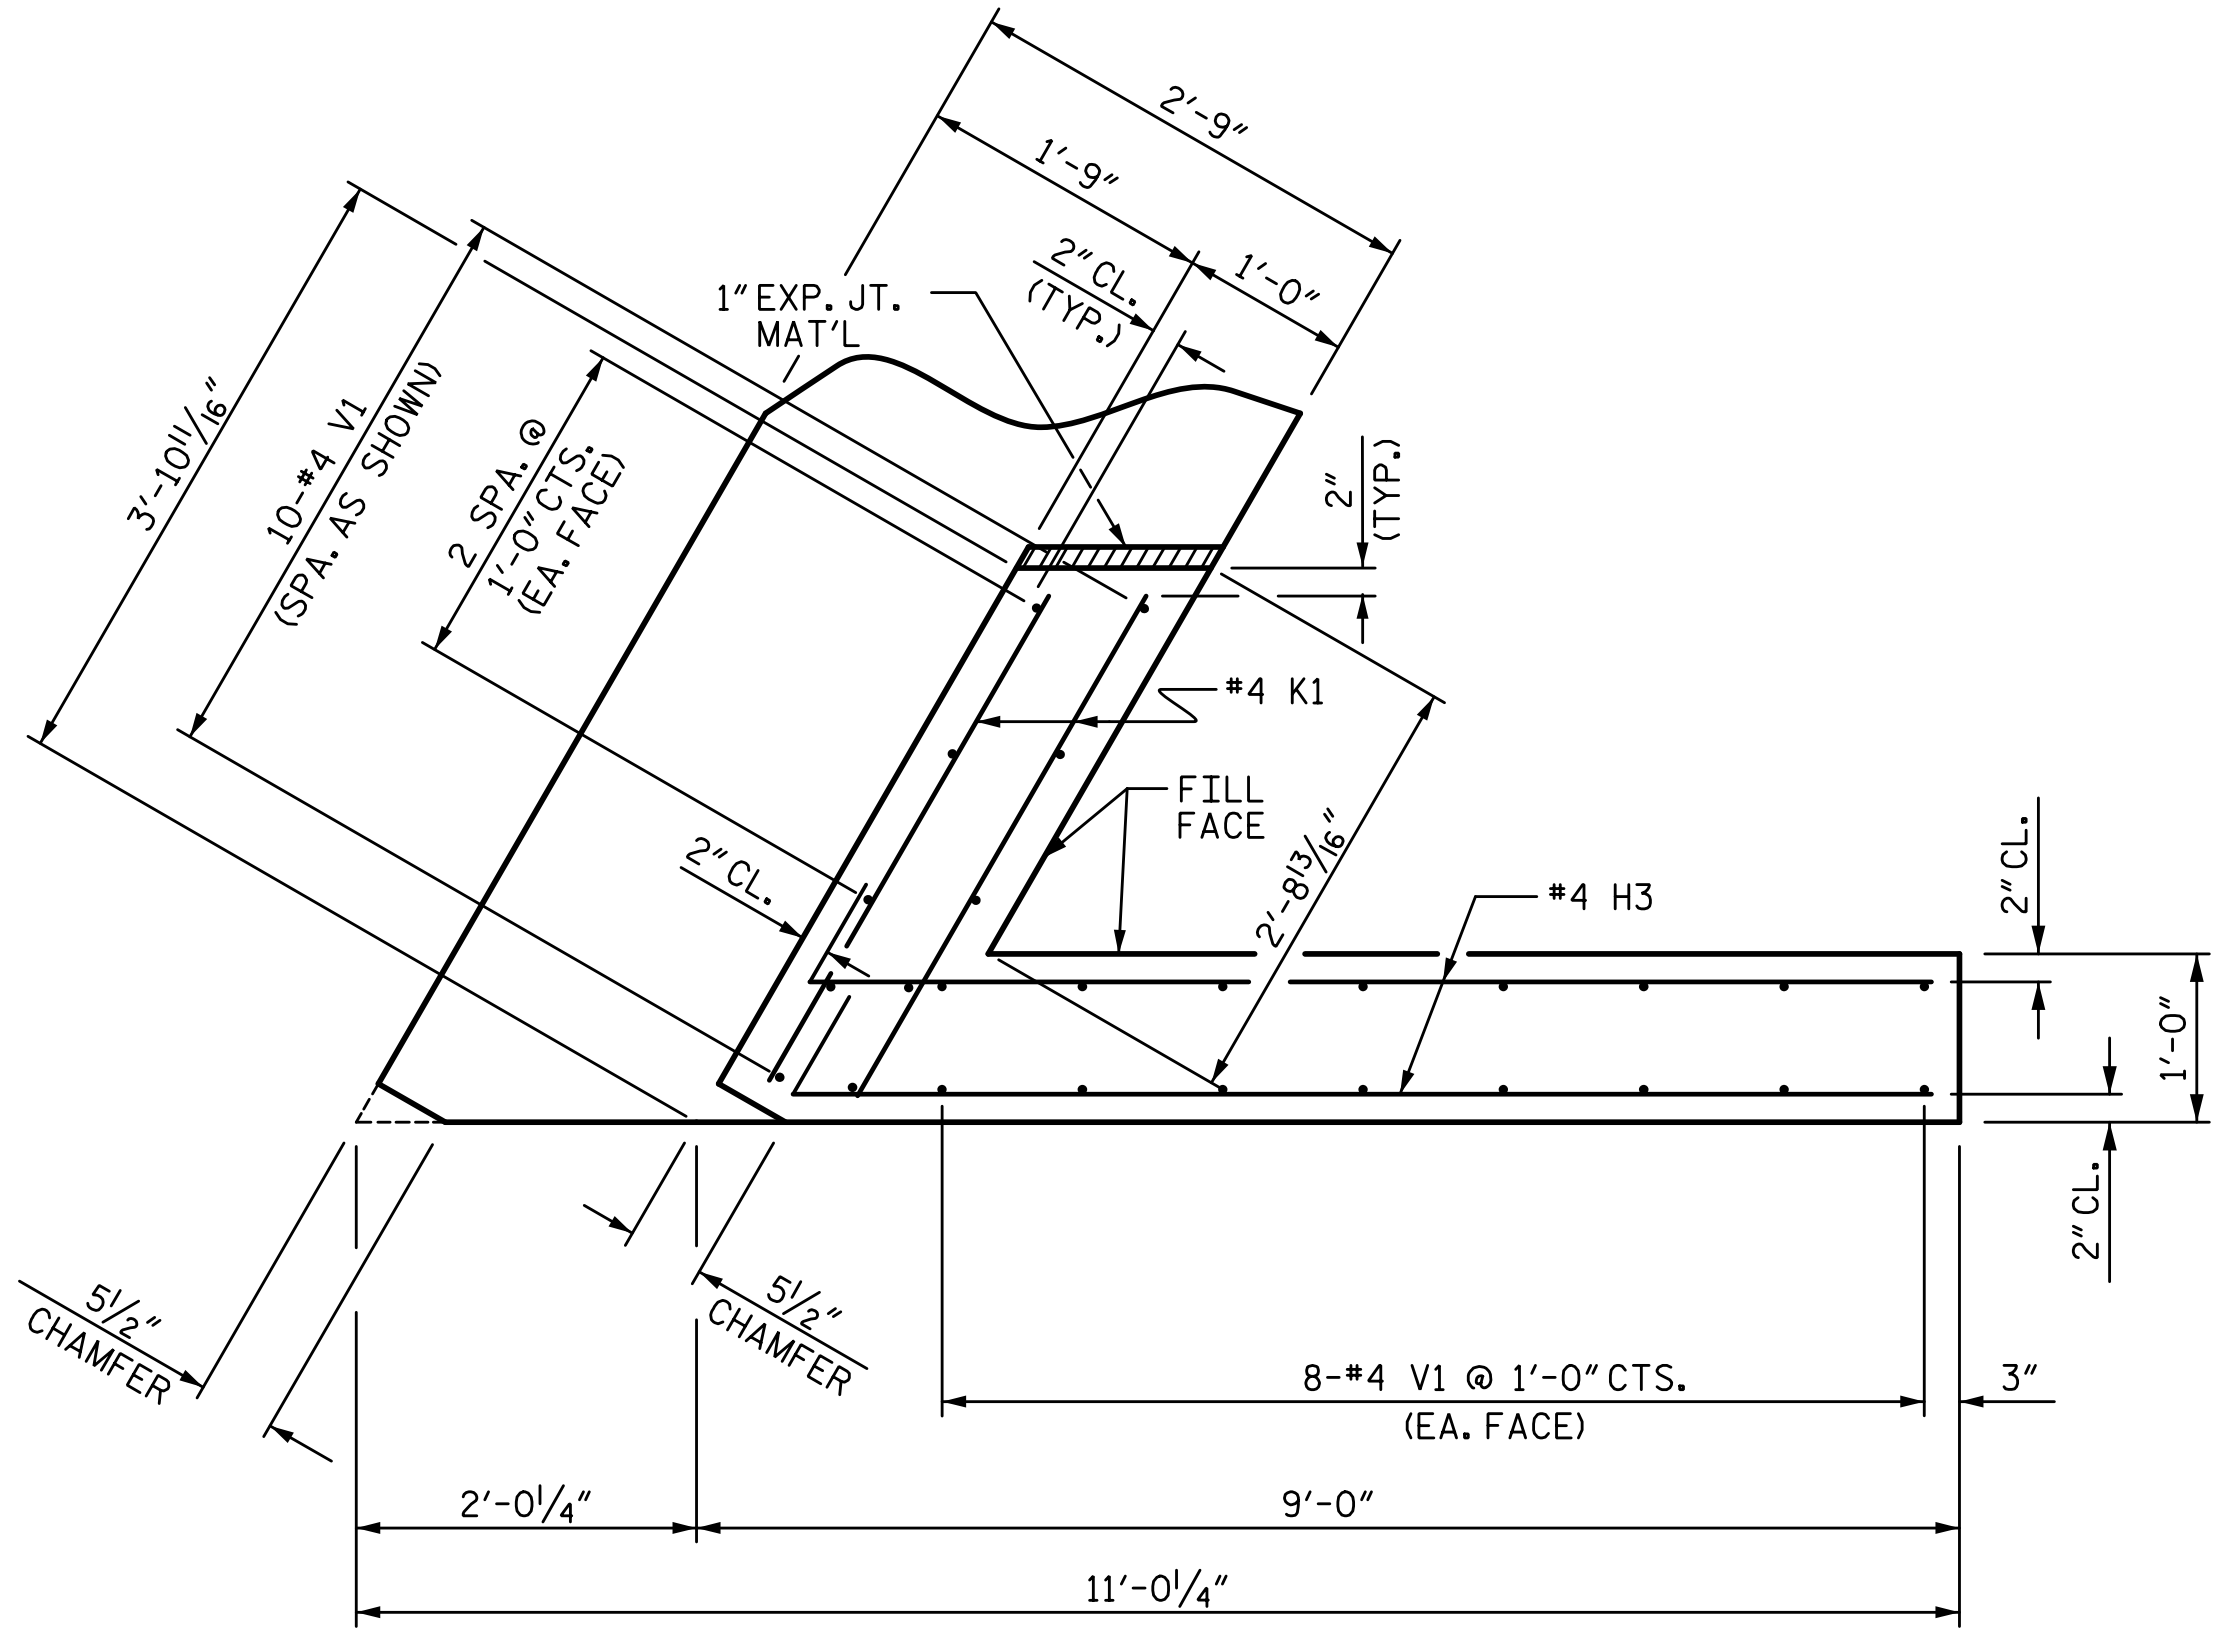


PLAN OF WING (W1)

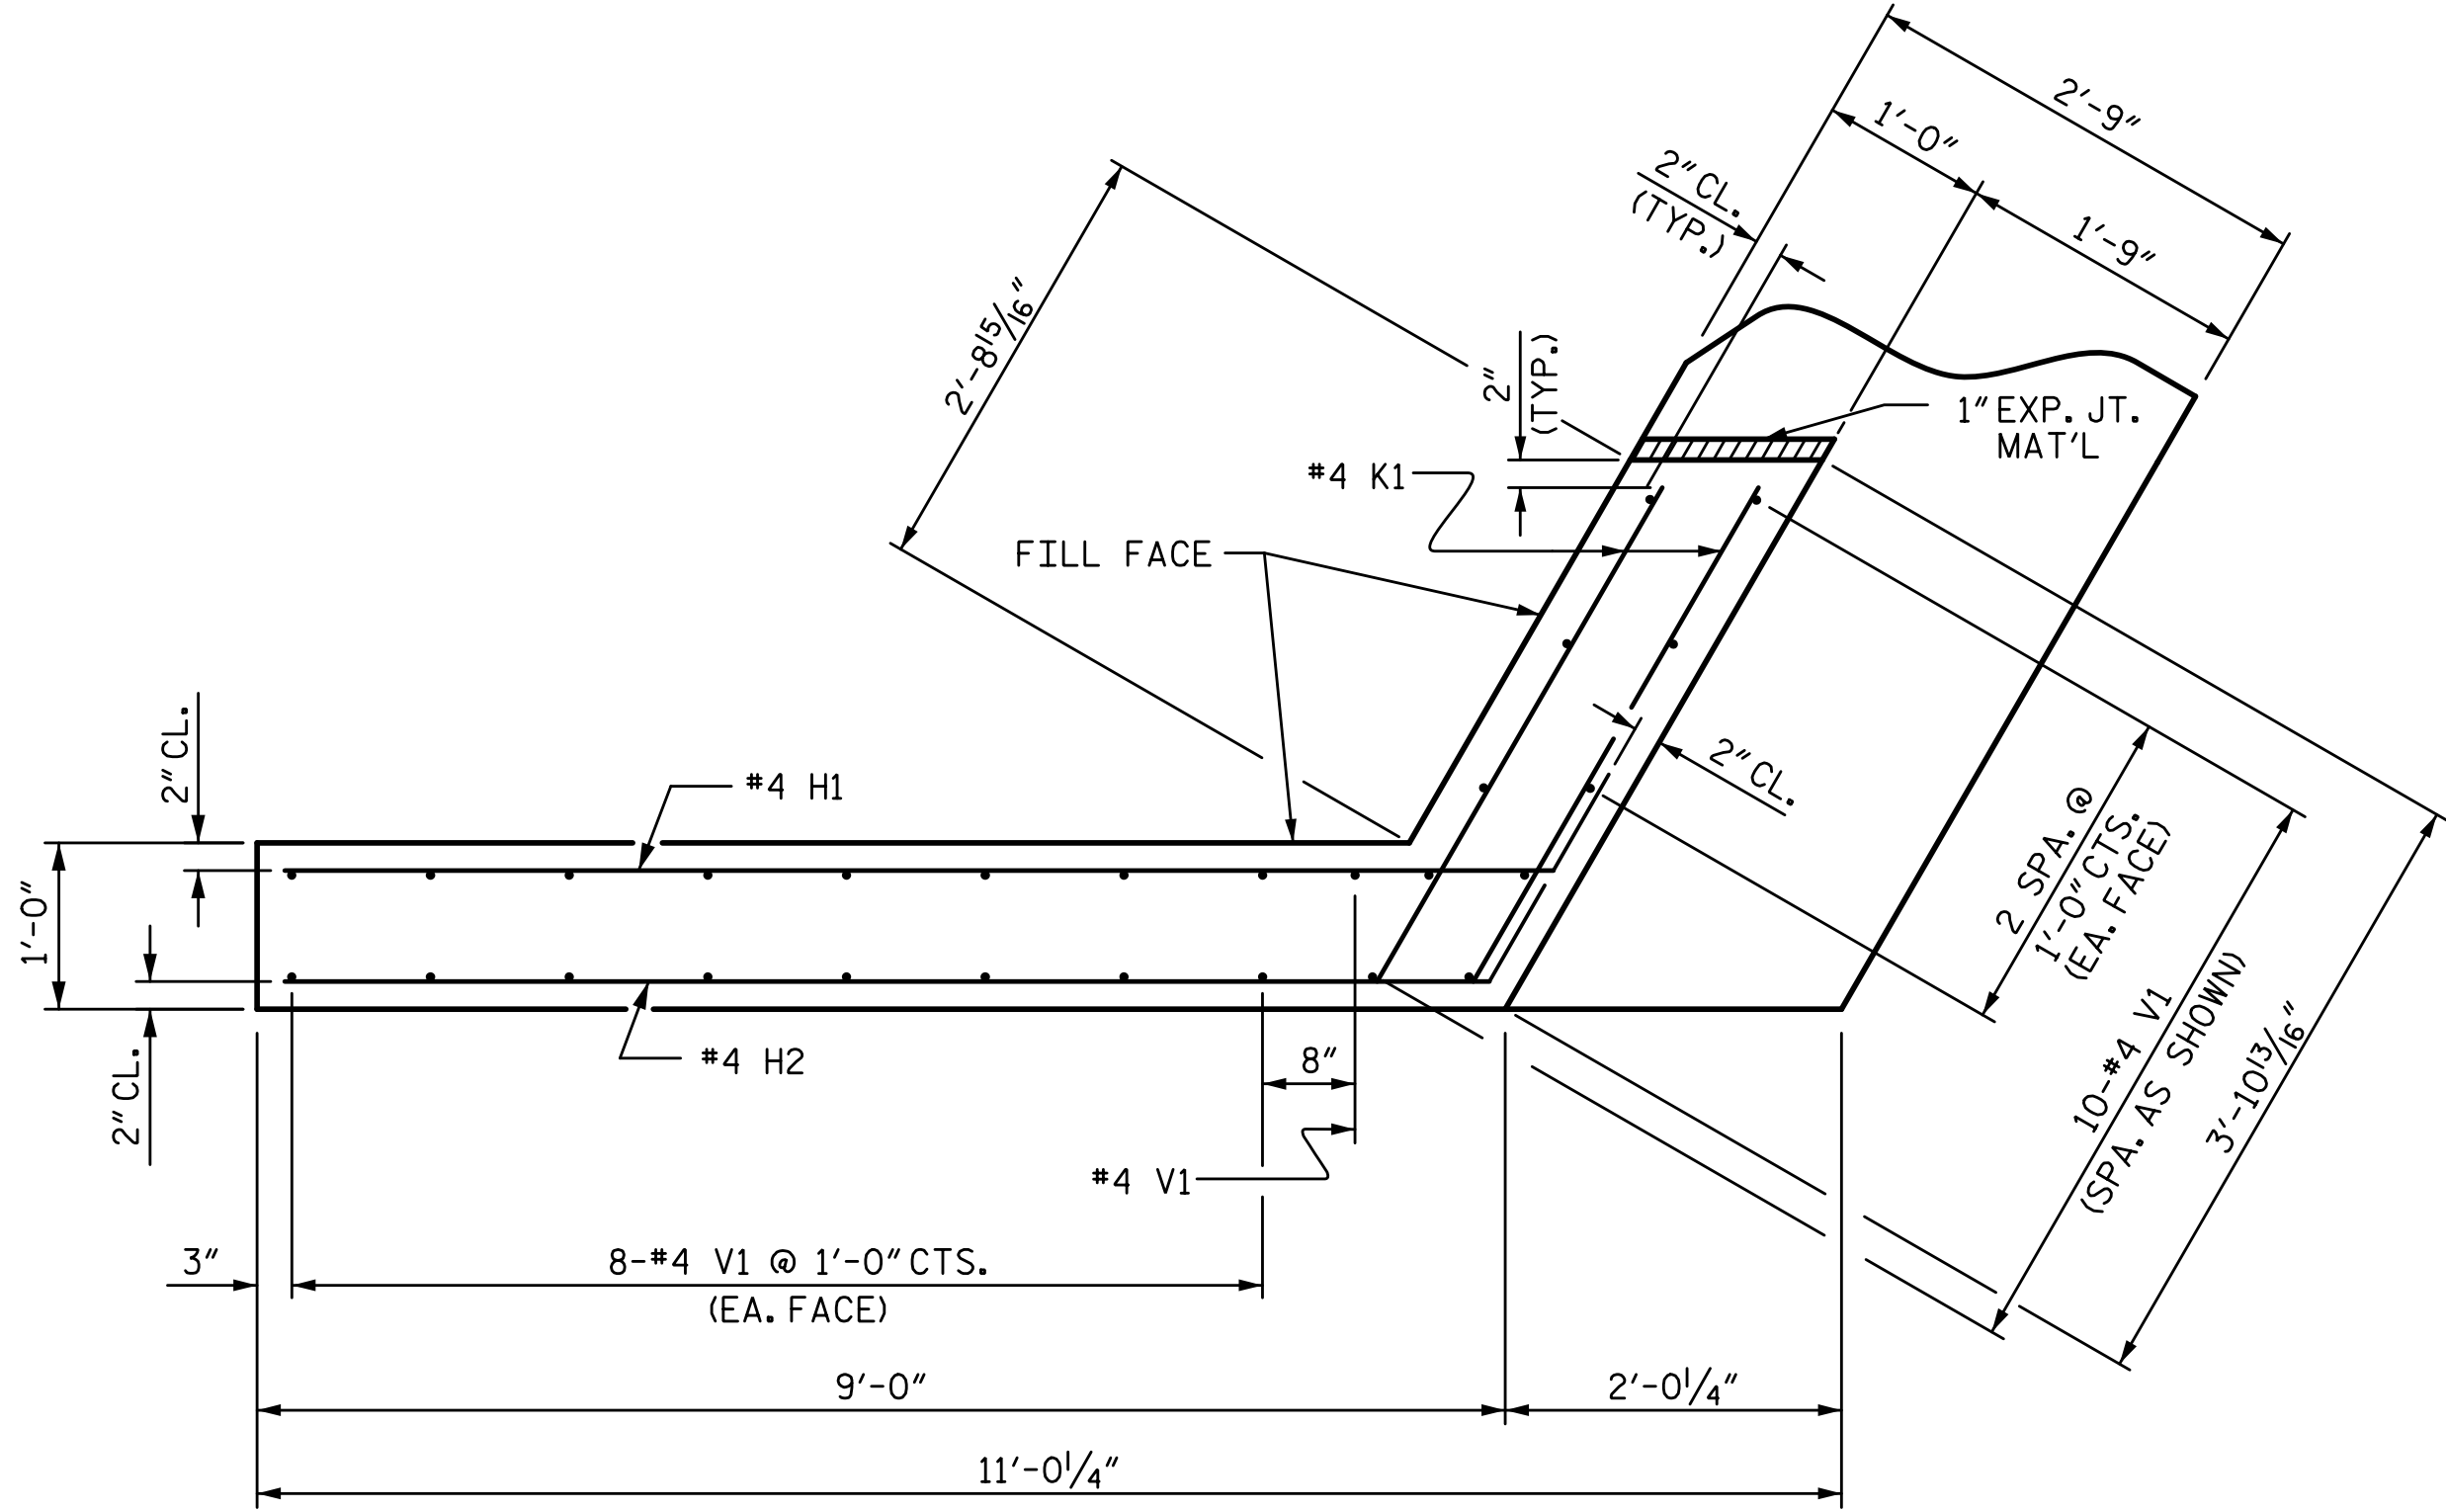


PLAN OF WING (W2)

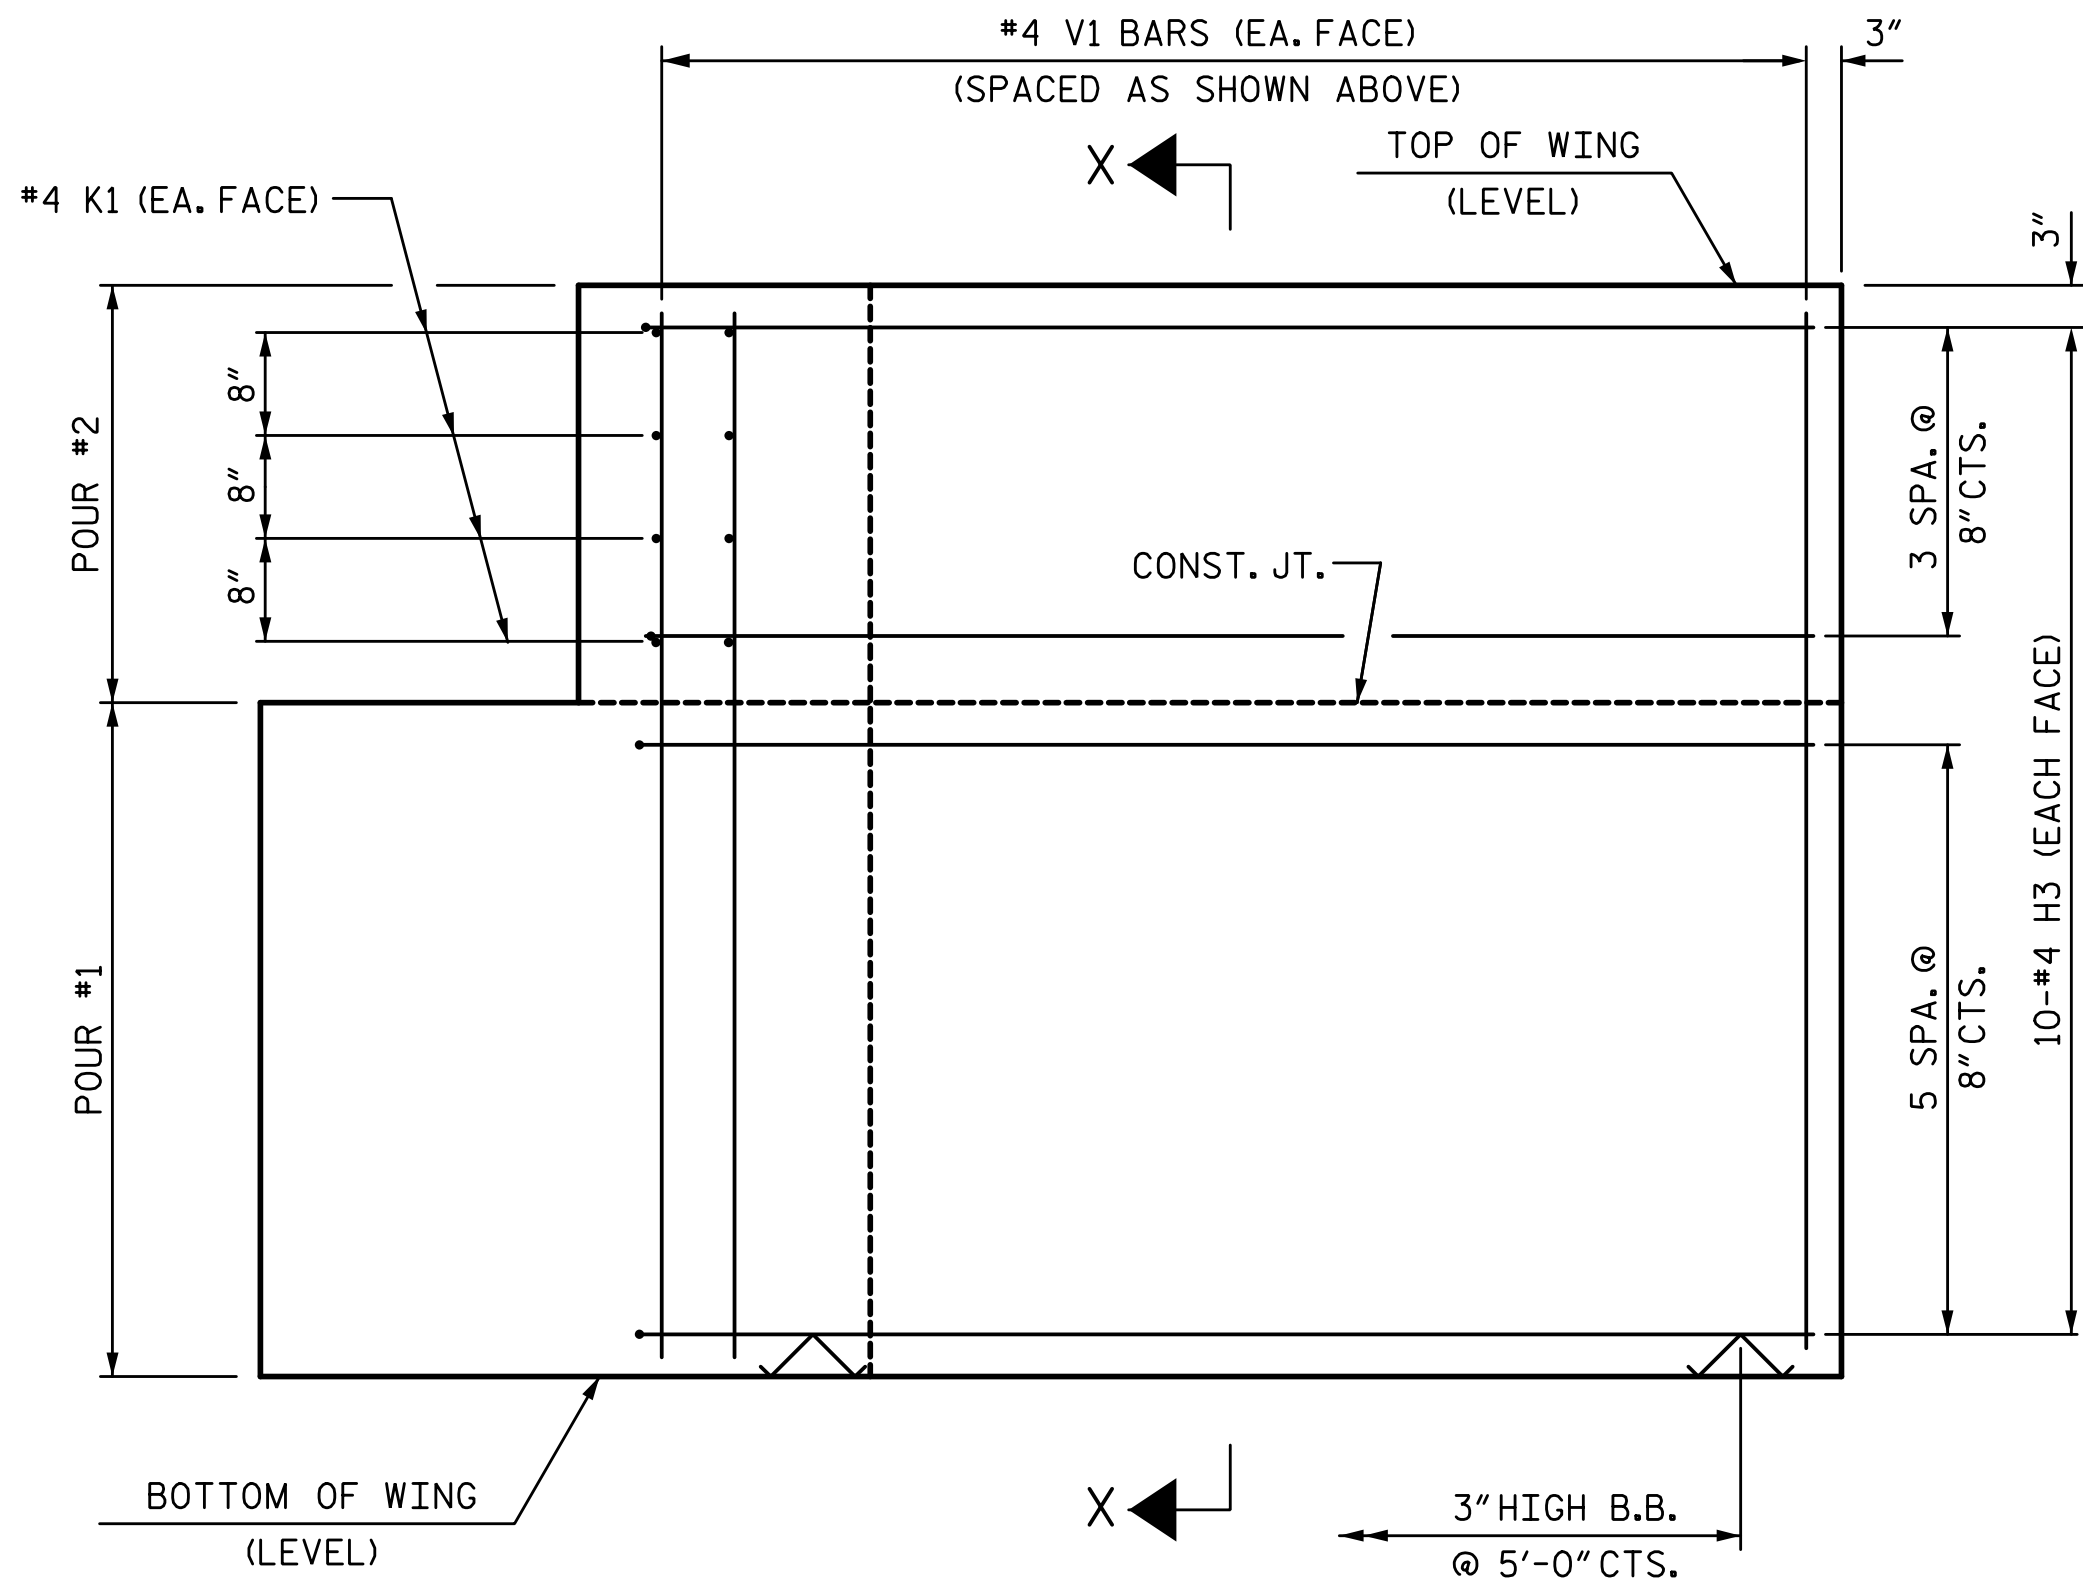


ELEVATION OF WING (W1)

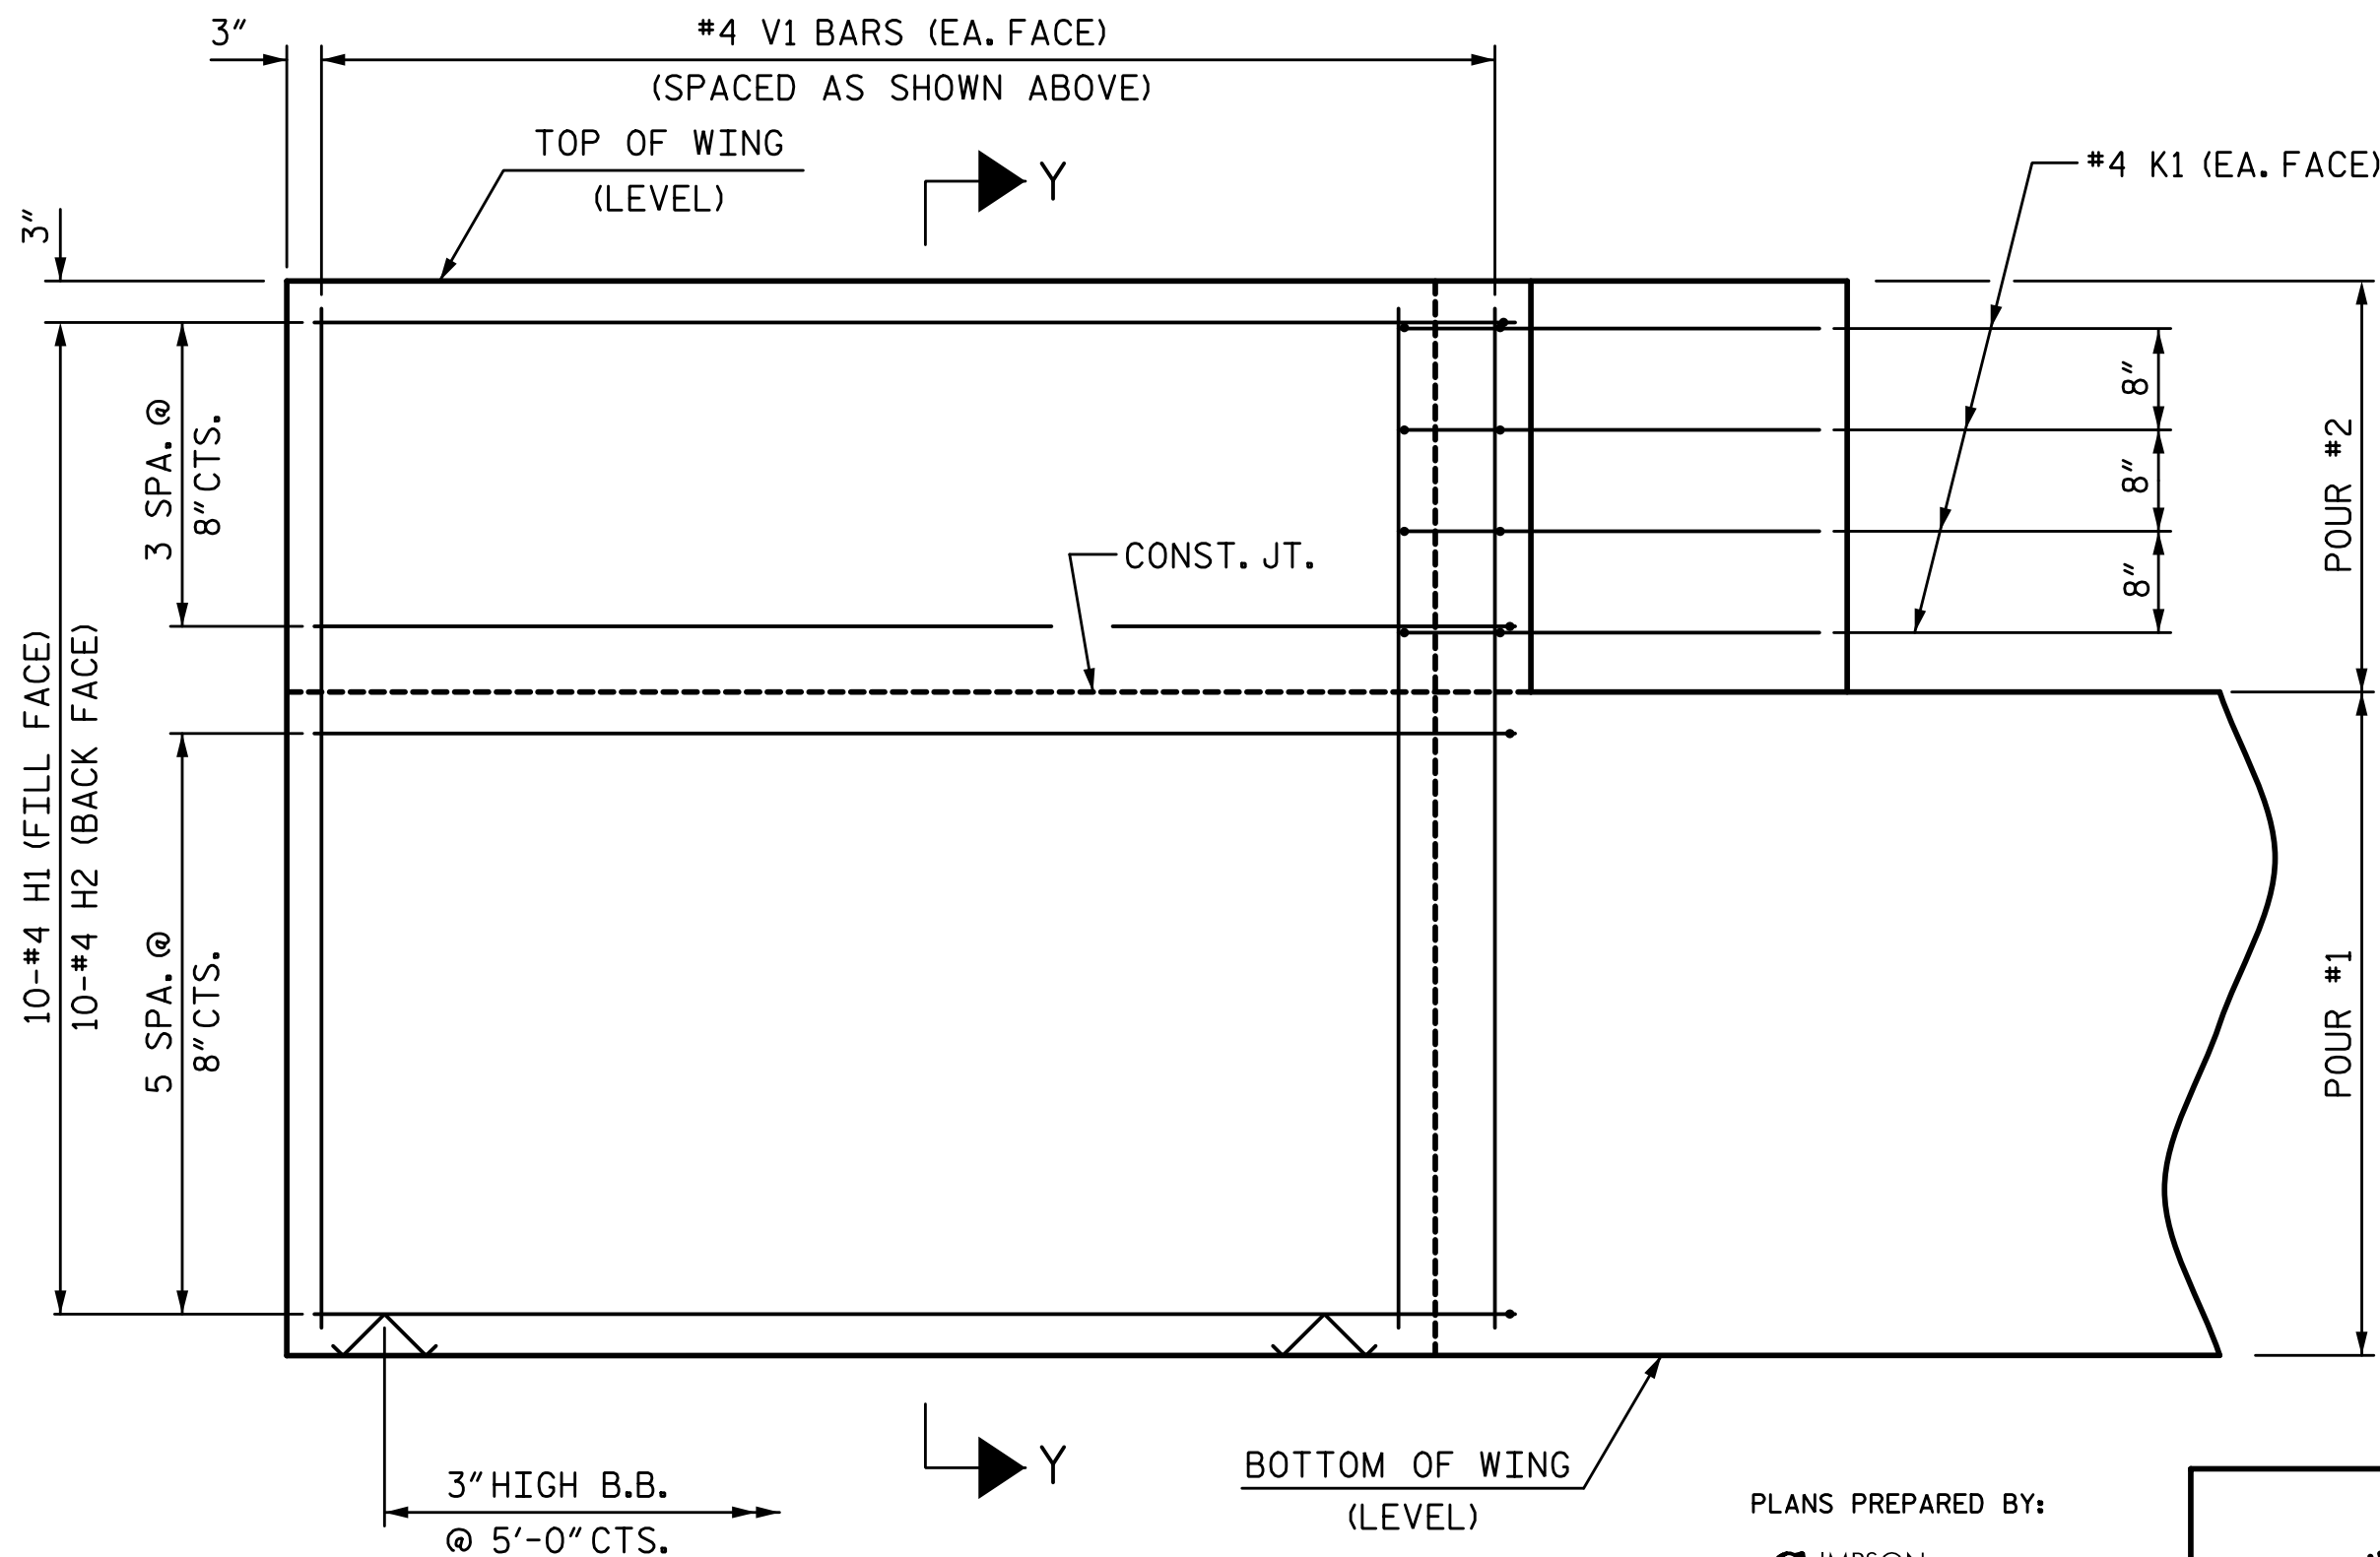

ELEVATION OF WING (W2)

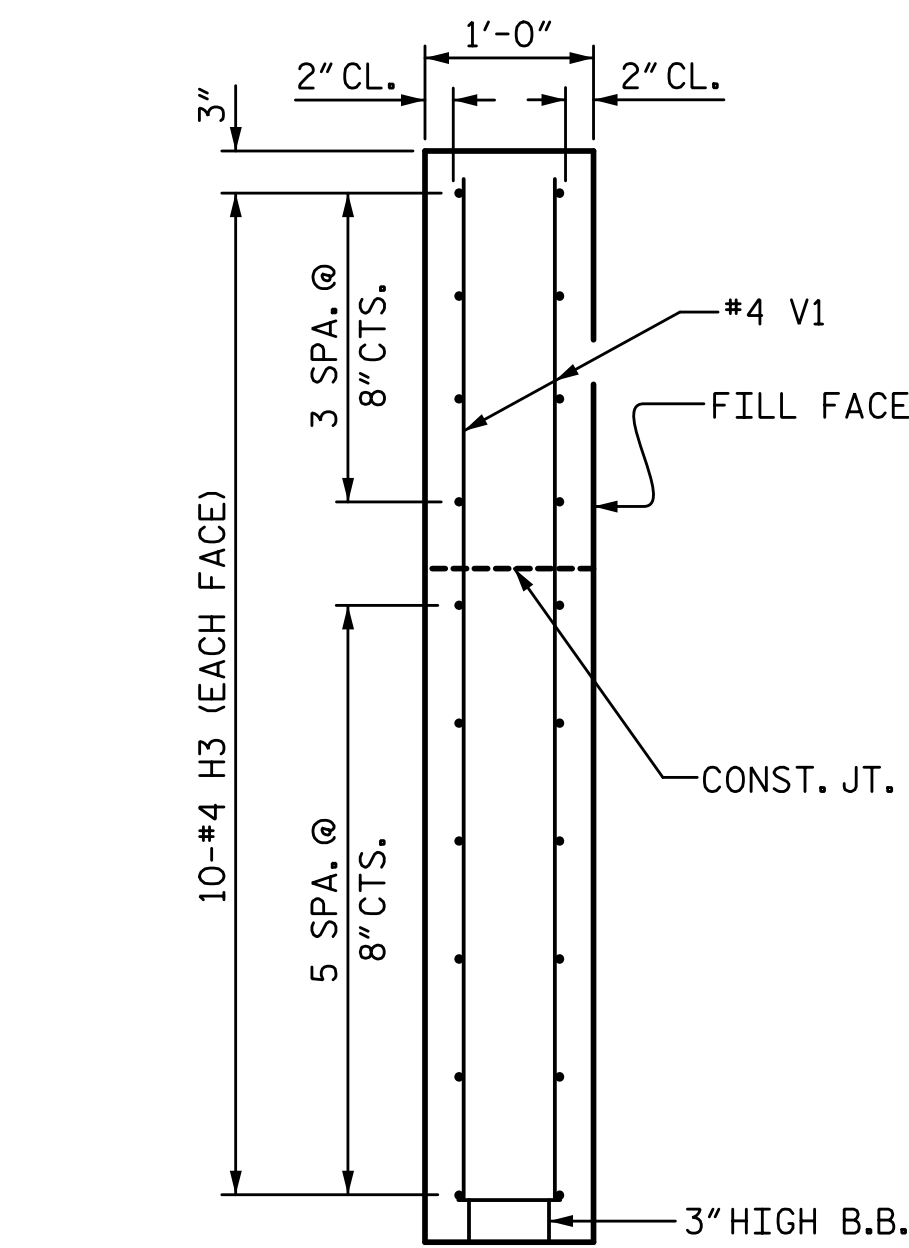

SECTION X-X

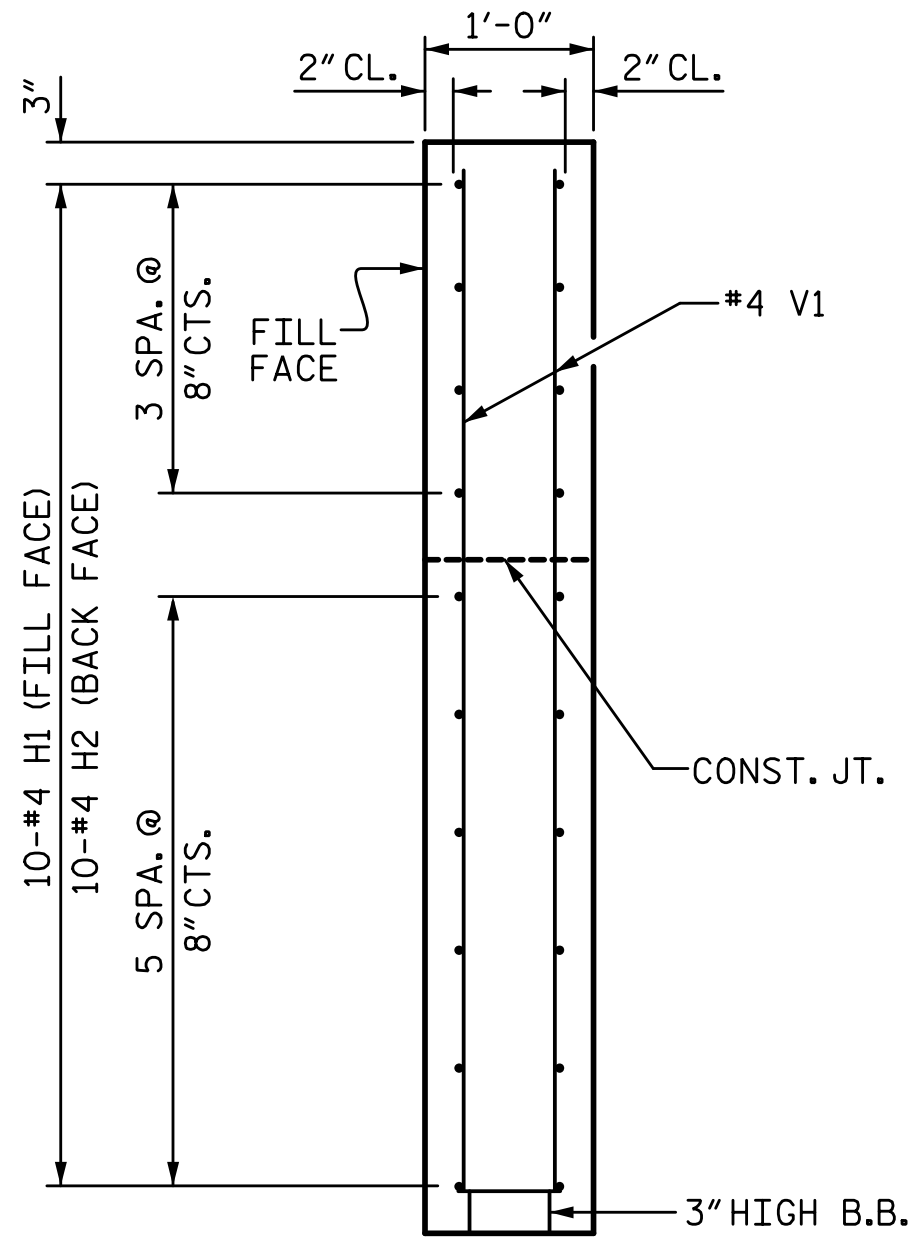

SECTION Y-Y


PROJECT NO. 17BP.7.R.94  
ORANGE COUNTY  
STATION: 13+22.00 -L-

SHEET 3 OF 4

DRAWN BY: T. BANKOVICH  
CHECKED BY: B.S. COX  
DESIGN ENGINEER OF RECORD: B.S. COX  
DATE: 3-18  
DATE: 3-18  
DATE: 3-18

WING DETAILS

PLANS PREPARED BY:  
SE & A  
SIMPSON ENGINEERS ASSOCIATES  
5640 Dillard Drive  
Suite 200  
Cary, NC 27518  
(919) 852-0468  
(919) 852-0598 (Fax)  
www.simpsonengr.com  
LICENSURE NO. C-2521

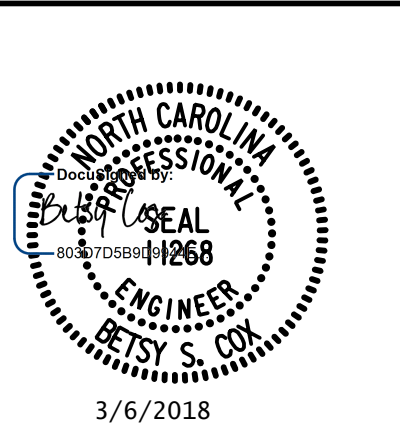


DOCUMENT NOT CONSIDERED FINAL  
UNLESS ALL SIGNATURES COMPLETED

REVISIONS						SHEET NO.
NO.	BY:	DATE:	NO.	BY:	DATE:	
1			3			S-10
2			4			
TOTAL SHEETS						14



3/6/2018 8:35:19 AM G:\Projects\2015\Division 7 (Hatch Mot+)\17BP7R94 (Orange 51) (20 24CS VR)\Structures\Drawings\Final (revised)\401\_17BP7R94\_SMJ\_EB.dgn

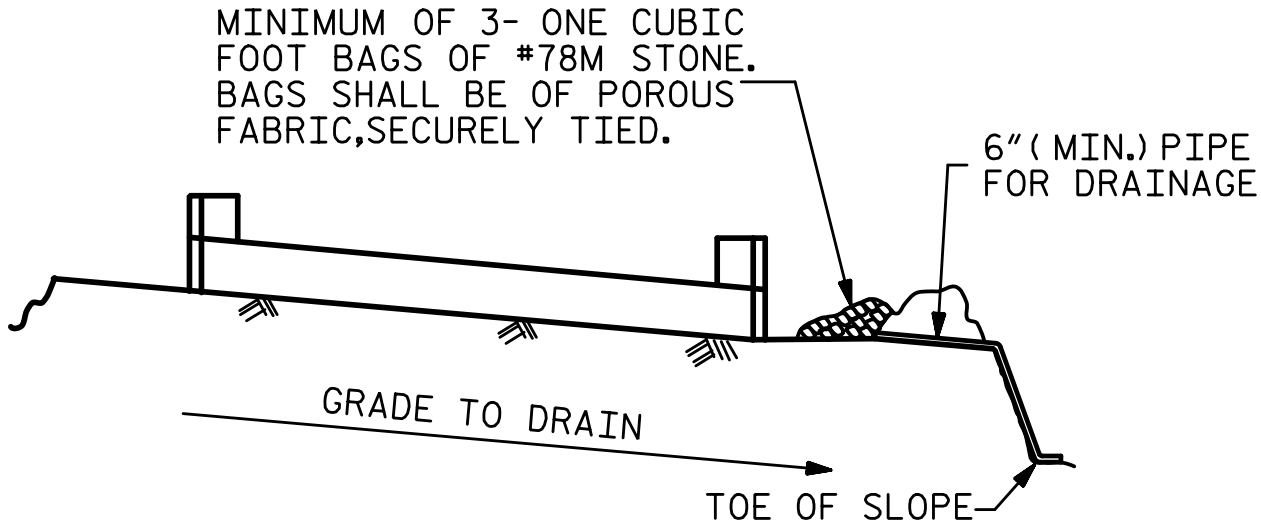


BAGGED STONE AND PIPE SHALL BE PLACED IMMEDIATELY AFTER COMPLETION OF END BENT EXCAVATION. PIPE MAY BE EITHER CONCRETE, CORRUGATED STEEL, CORRUGATED ALUMINUM ALLOY, OR CORRUGATED PLASTIC. PERFORATED PIPE WILL NOT BE ALLOWED.

BAGGED STONE SHALL REMAIN IN PLACE UNTIL THE ENGINEER DIRECTS THAT IT BE REMOVED. THE CONTRACTOR SHALL REMOVE AND DISPOSE OF SILT ACCUMULATIONS AT BAGGED STONE WHEN SO DIRECTED BY THE ENGINEER. BAGS SHALL BE REMOVED AND REPLACED WHENEVER THE ENGINEER DETERMINES THAT THEY HAVE DETERIORATED AND LOST THEIR EFFECTIVENESS.


NO SEPARATE PAYMENT WILL BE MADE FOR THIS WORK AND THE ENTIRE COST OF THIS WORK SHALL BE INCLUDED IN THE UNIT CONTRACT PRICE BID FOR THE SEVERAL PAY ITEMS.

### TEMPORARY DRAINAGE AT END BENT

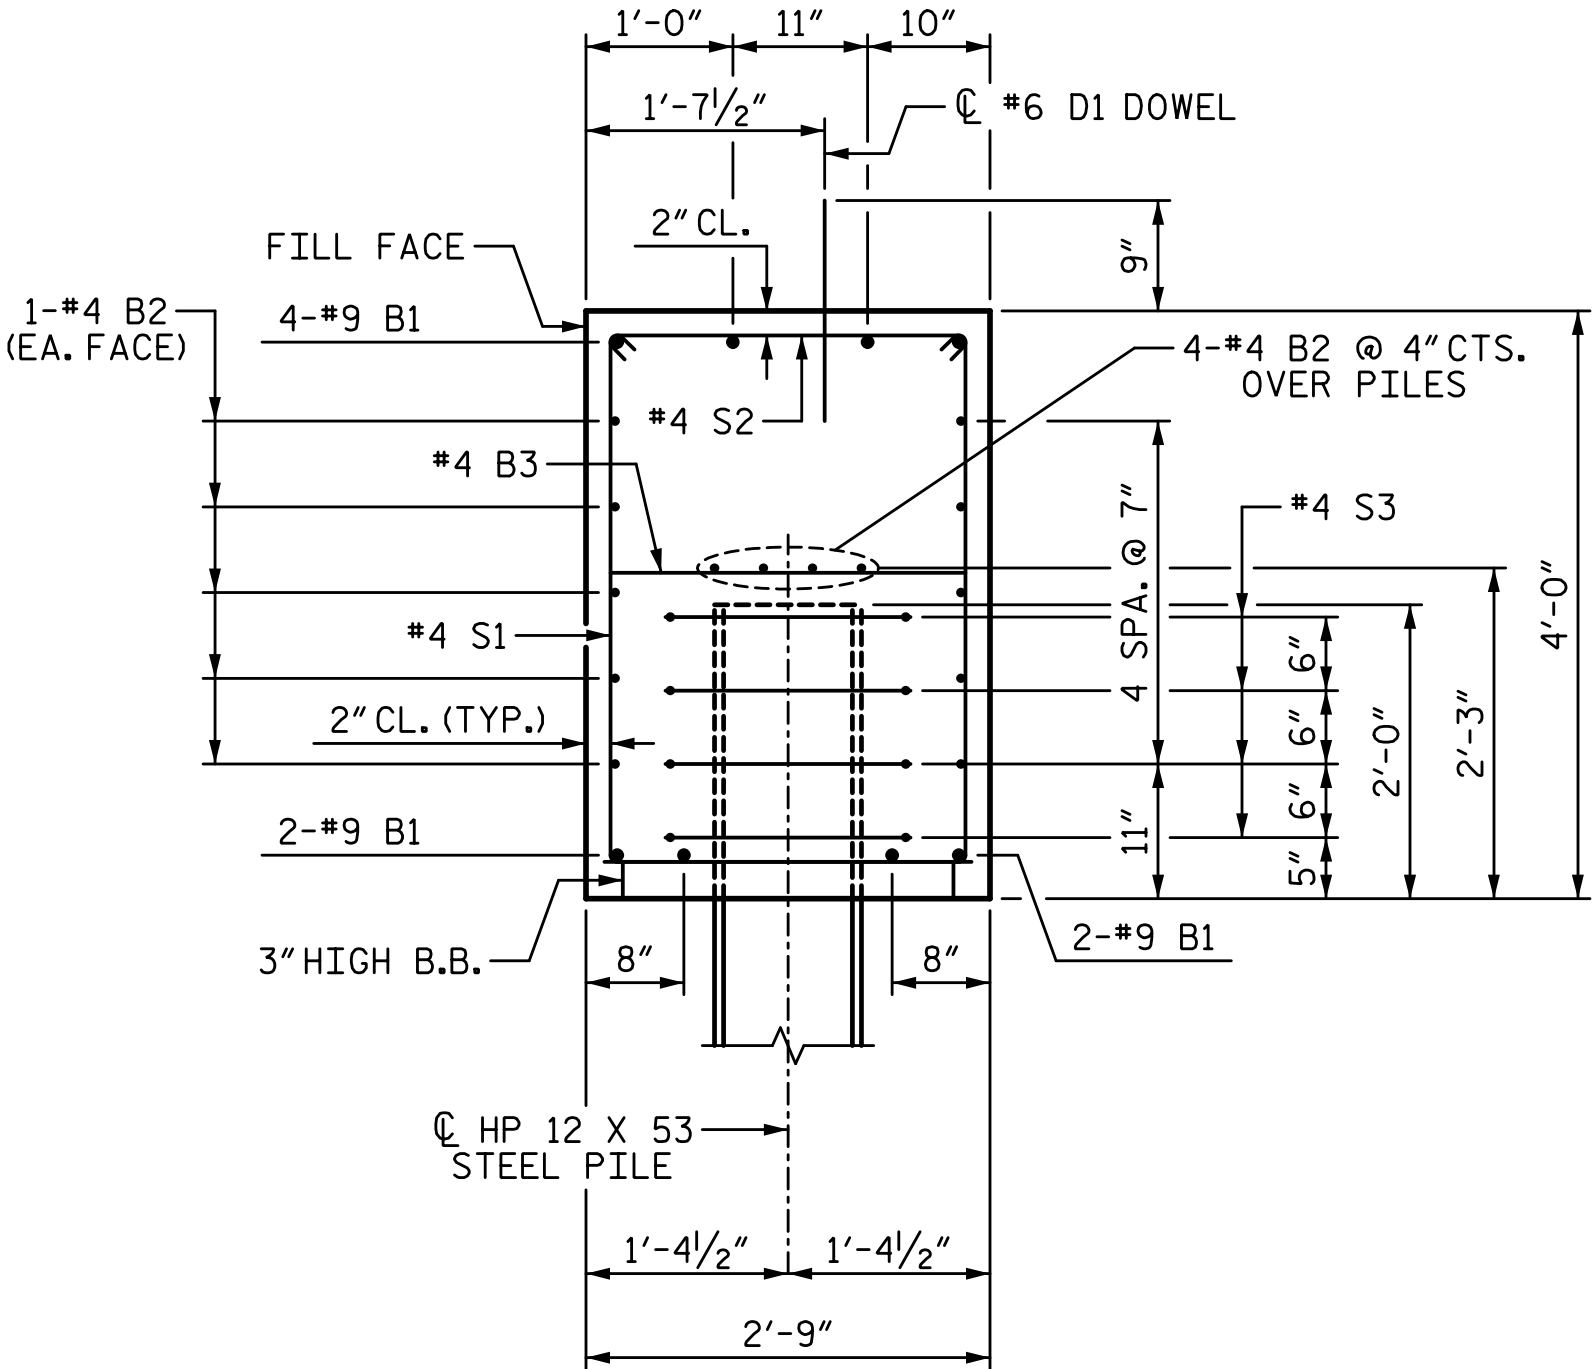


### SECTION A-A

(CONCRETE COLLAR NOT SHOWN FOR CLARITY. SEE "CORROSION PROTECTION FOR STEEL PILES DETAIL.")

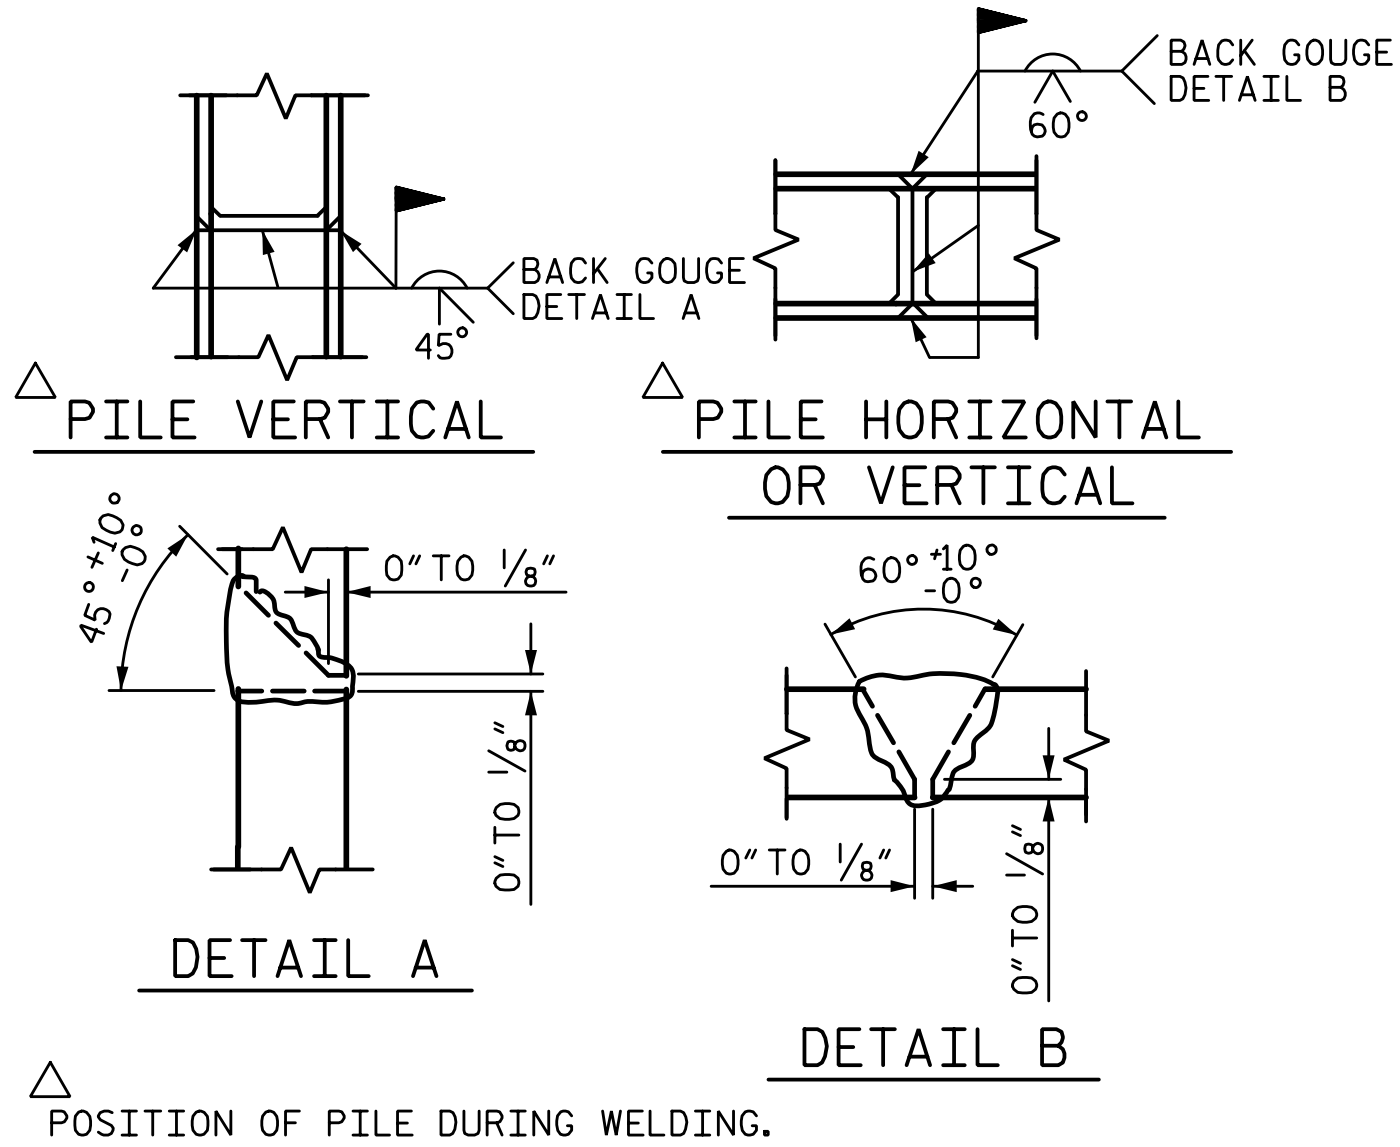


### PILE SPLICE DETAILS

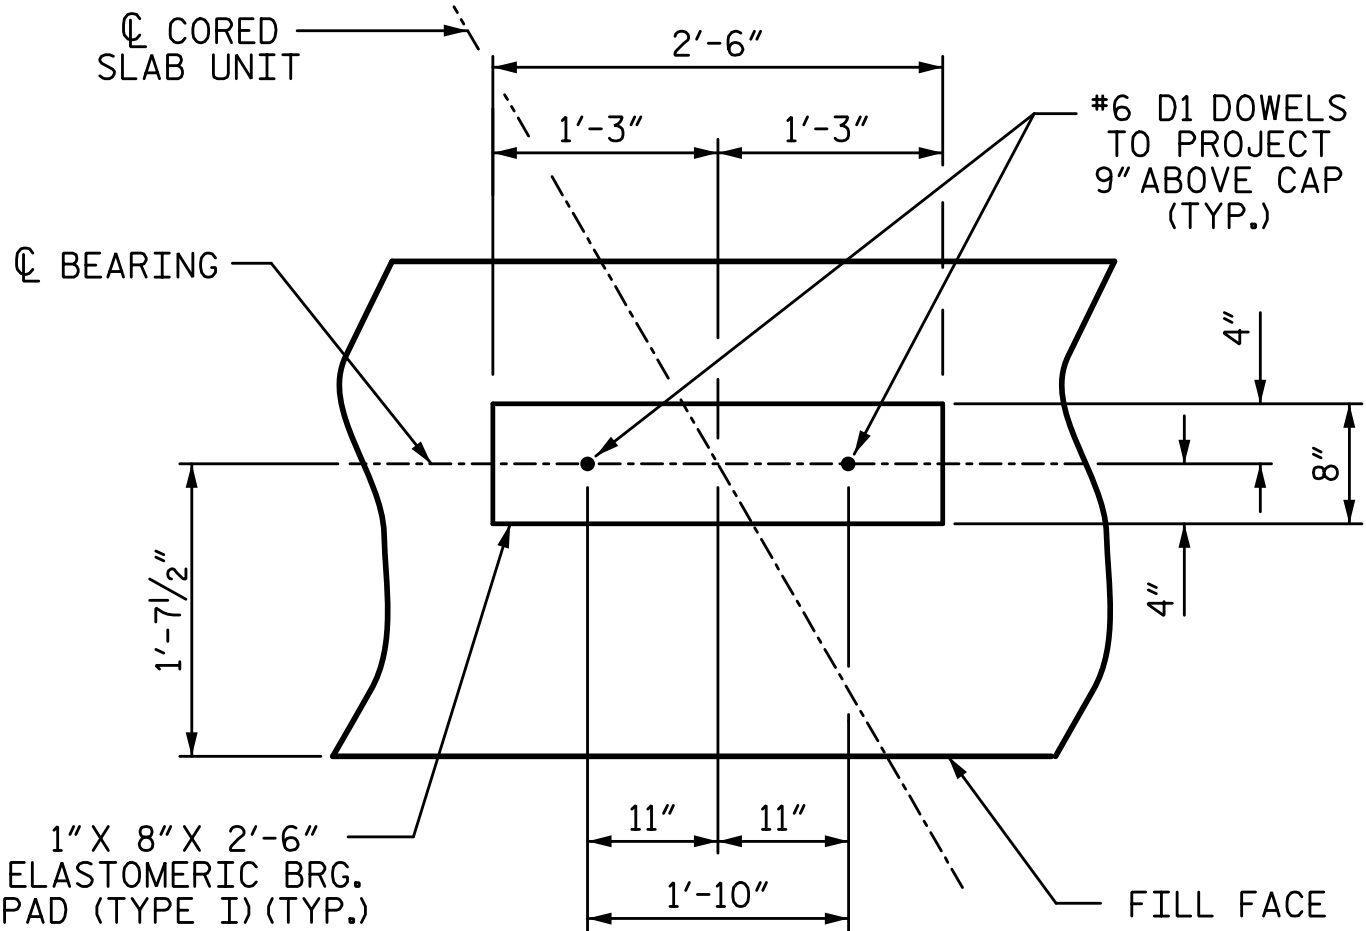


### DETAIL "A"

(END BENT 1 SHOWN, END BENT 2 SIMILAR BY ROTATION)

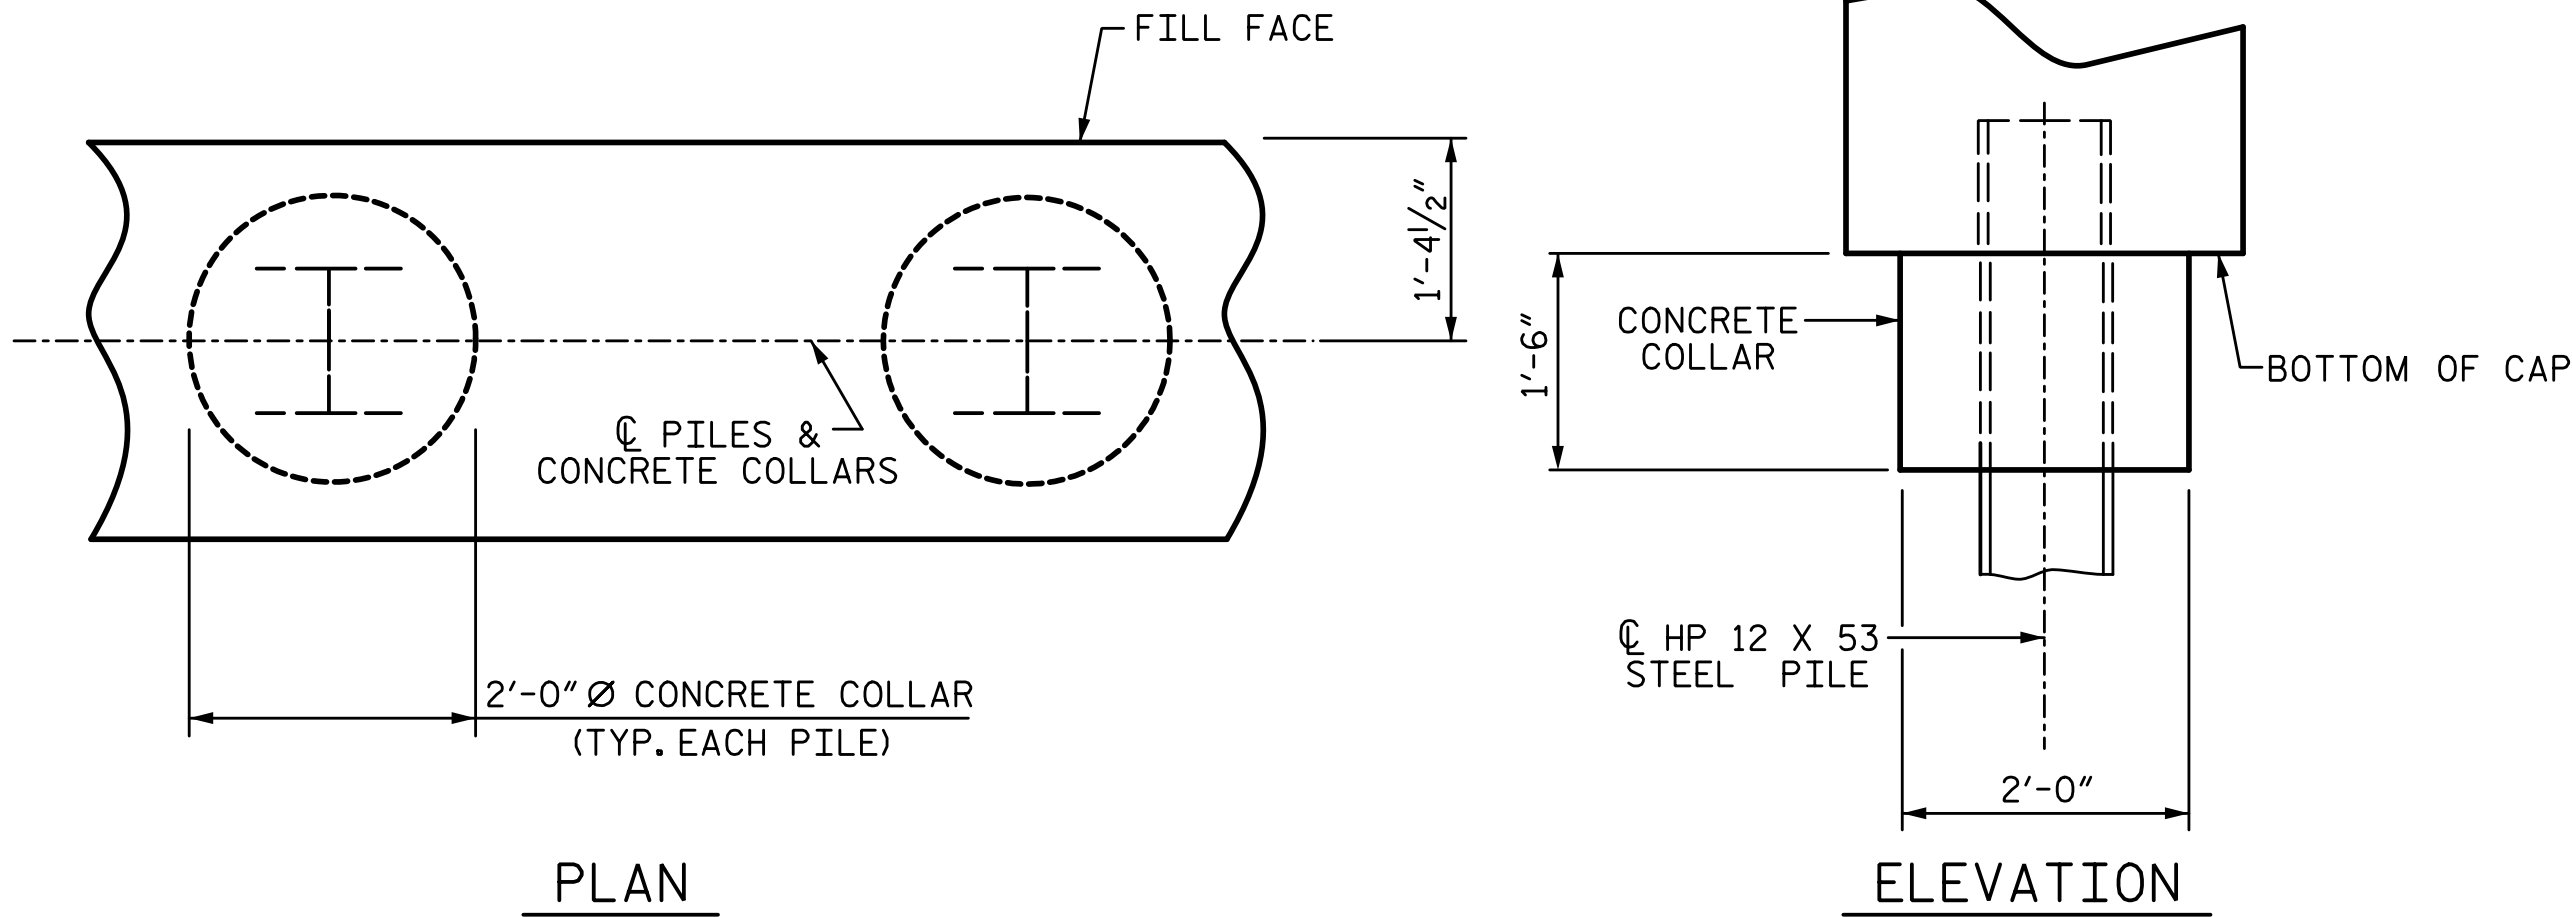

### CORROSION PROTECTION FOR STEEL PILES DETAIL

(END BENT 2 SHOWN, END BENT 1 SIMILAR BY ROTATION)

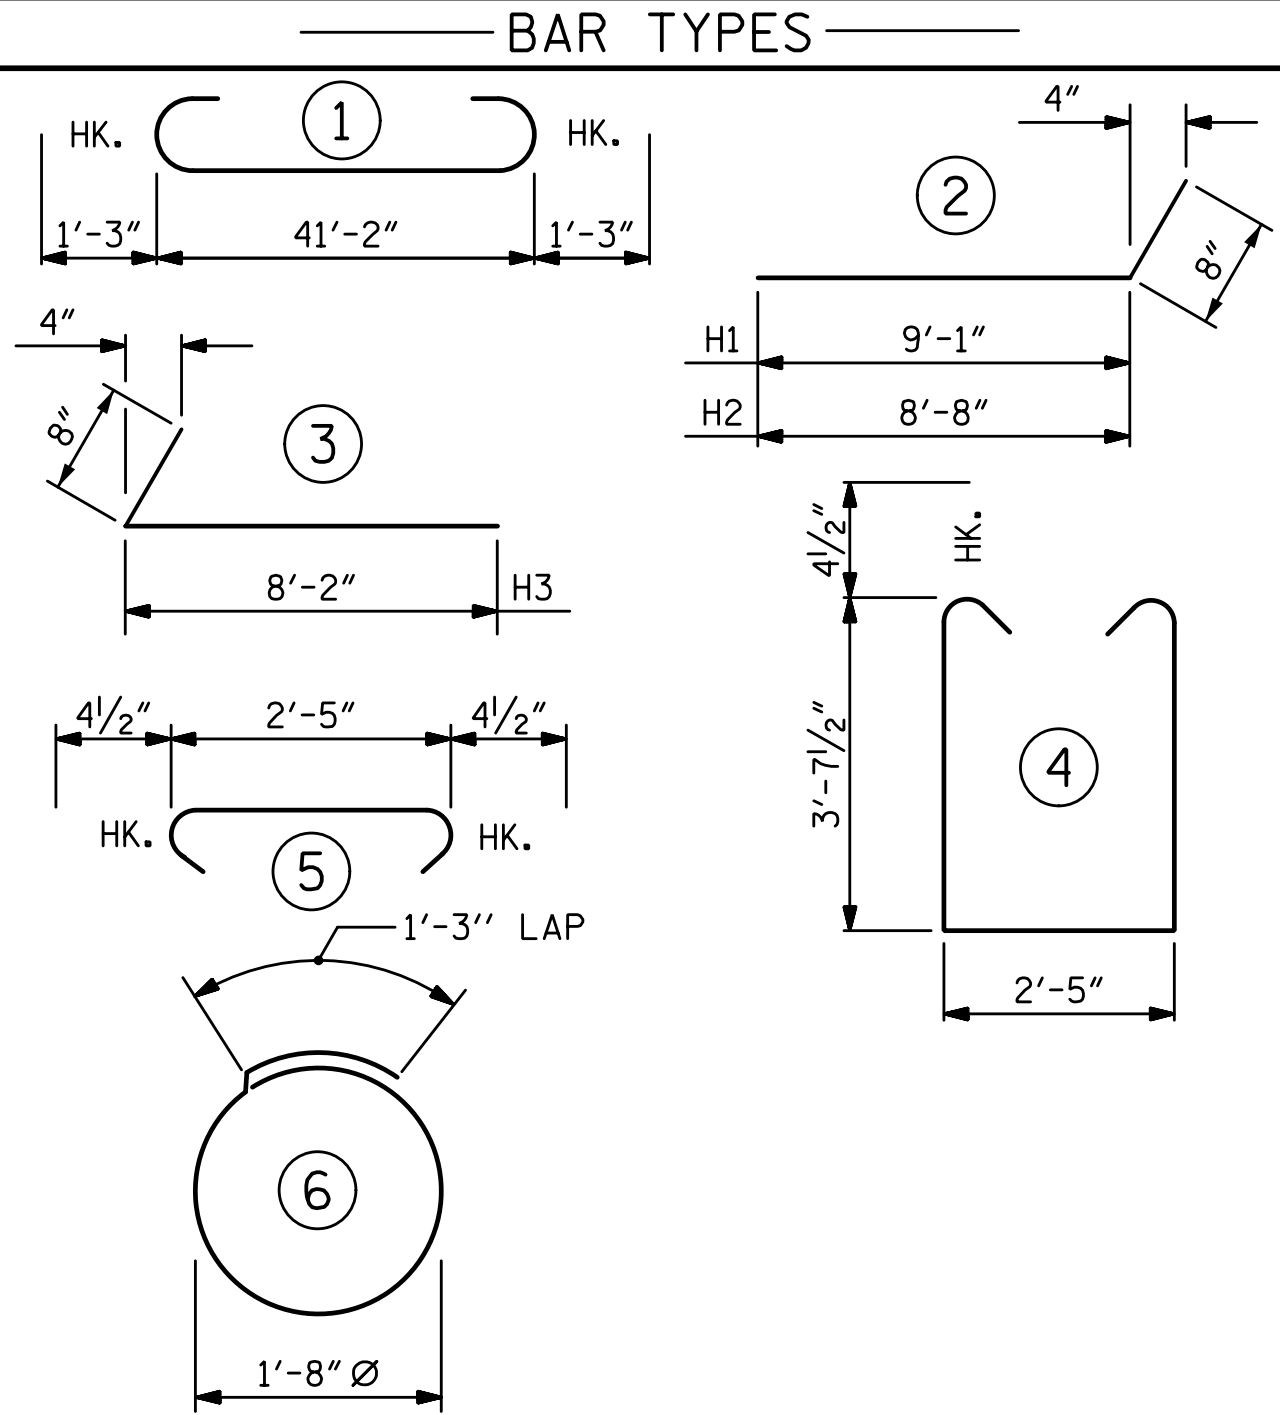

ALL BAR DIMENSIONS ARE OUT TO OUT.

END BENT 1				END BENT 2			
HP 12 X 53 STEEL PILES				HP 12 X 53 STEEL PILES			
NO: 5		LF = 60		NO: 5		LF = 60	
PILE EXCAVATION IN SOIL		LF = 35		PILE EXCAVATION IN SOIL		LF = 25	
PILE EXCAVATION NOT IN SOIL		LF = 25		PILE EXCAVATION NOT IN SOIL		LF = 25	
PILE DRIVING EQUIPMENT SETUP FOR HP 12 X 53 STEEL PILES				PILE DRIVING EQUIPMENT SETUP FOR HP 12 X 53 STEEL PILES			
NO: 5				NO: 5			

### BILL OF MATERIAL

#### FOR ONE END BENT

BAR	NO.	SIZE	TYPE	LENGTH	WEIGHT
B1	8	#9	1	43'-8"	1188
B2	28	#4	STR	21'-11"	410
B3	11	#4	STR	2'-5"	18
D1	20	#6	STR	1'-6"	45
H1	10	#4	2	9'-9"	65
H2	10	#4	2	9'-4"	62
H3	20	#4	3	8'-10"	118
K1	16	#4	STR	3'-3"	35
S1	54	#4	4	10'-5"	376
S2	54	#4	5	3'-2"	114
S3	20	#4	6	6'-6"	87
V1	53	#4	STR	6'-2"	218

REINFORCING STEEL (FOR ONE END BENT) 2736 LBS.

#### CLASS A CONCRETE BREAKDOWN (FOR ONE END BENT)

POUR 1	CAP, LOWER PART OF WINGS & COLLARS	20.2 C.Y.
POUR 2	UPPER PART OF WINGS	2.4 C.Y.

TOTAL CLASS A CONCRETE 22.6 C.Y.

PROJECT NO. 17BP.7.R.94  
ORANGE COUNTY  
STATION: 13+22.00 -L-


SHEET 4 OF 4

STATE OF NORTH CAROLINA  
DEPARTMENT OF TRANSPORTATION  
RALEIGH  
SUBSTRUCTURE

END BENT 1 & 2  
DETAILS

#### REVISIONS

NO.	BY:	DATE:	NO.	BY:	DATE:	SHEET NO.
1			3			S-11
2			4			TOTAL SHEETS 14

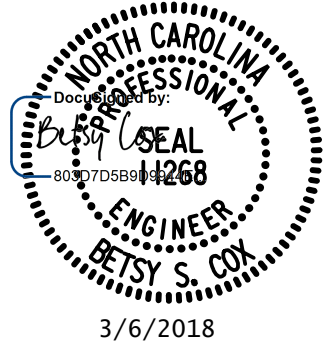

PLANS PREPARED BY:

SEMPSON  
& ASSOCIATES  
ENGINEERS

5640 Dillard Drive  
Suite 200  
Cary, NC 27518  
(919) 852-0468  
(919) 852-0598 (Fax)  
www.simpsonengr.com

LICENSURE NO. C-2521


DOCUMENT NOT CONSIDERED FINAL  
UNLESS ALL SIGNATURES COMPLETED



# PLAN OF RIP RAP



LICENSURE NO. C-2521

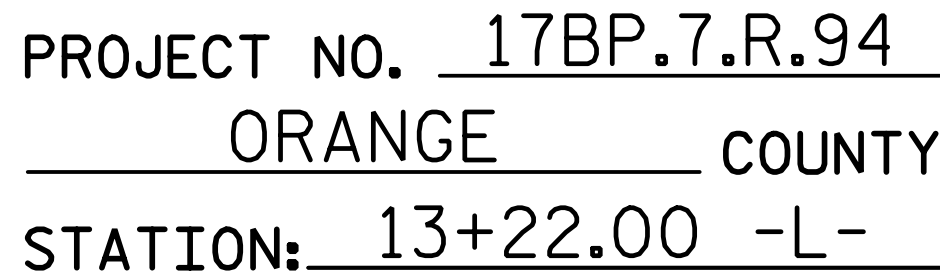

DRAWN BY: D.G. VESTER DATE: 3-18  
 CHECKED BY: B.S. COX DATE: 3-18  
 DESIGN ENGINEER OF RECORD: B.S. COX DATE: 3-18

**DOCUMENT NOT CONSIDERED FINAL  
UNLESS ALL SIGNATURES COMPLETED**





The image contains two technical drawings. The left drawing, labeled 'SECTION N-N', is a cross-section of a curb and gutter. It shows a gutter with a minimum depth of 2 inches and a curb height of 4 inches. The gutter width is 8 inches. The right drawing, labeled 'END OF CURB WITHOUT SHOULDER BERM GUTTER', is an end view showing the curb and gutter assembly. It indicates a width of 3'-1 1/2" and labels the 'APPROACH SLAB' and 'CURB'.

APPROACH SLAB GROOVING IS NOT REQUIRED.

SPLICE LENGTHS		
BAR SIZE	EPOXY COATED	UNCOATED
#4	2'-0"	1'-9"
#5	2'-6"	2'-2"
#6	3'-10"	2'-7"


SHEET 1 OF 2

REVISIONS						SHEET NO. S-13
NO.	BY:	DATE:	NO.	BY:	DATE:	
1			3			TOTAL SHEETS 14
2			4			

**SIMPSON  
& SE ENGINEERS  
& A ASSOCIATES**

5640 Dillard Drive  
Suite 200  
Cary, NC 27518  
(919) 852-0468  
(919) 852-0598 (Fax)  
[www.simpsonengr.com](http://www.simpsonengr.com)


ENCLOSURE NO. C-252

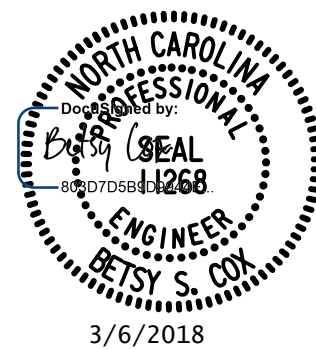

**DOCUMENT NOT CONSIDERED FINAL  
UNLESS ALL SIGNATURES COMPLETED**




3/6/2018 8:35:20 AM G:\Projects\2015\Division 7 (Hatch Mot+)\17BP7R94 (Orange 51) (120 24CS VR)\Structures\Drawings\Final (revised)\401\_17BP7R94\_SMJ\_AS.dgn

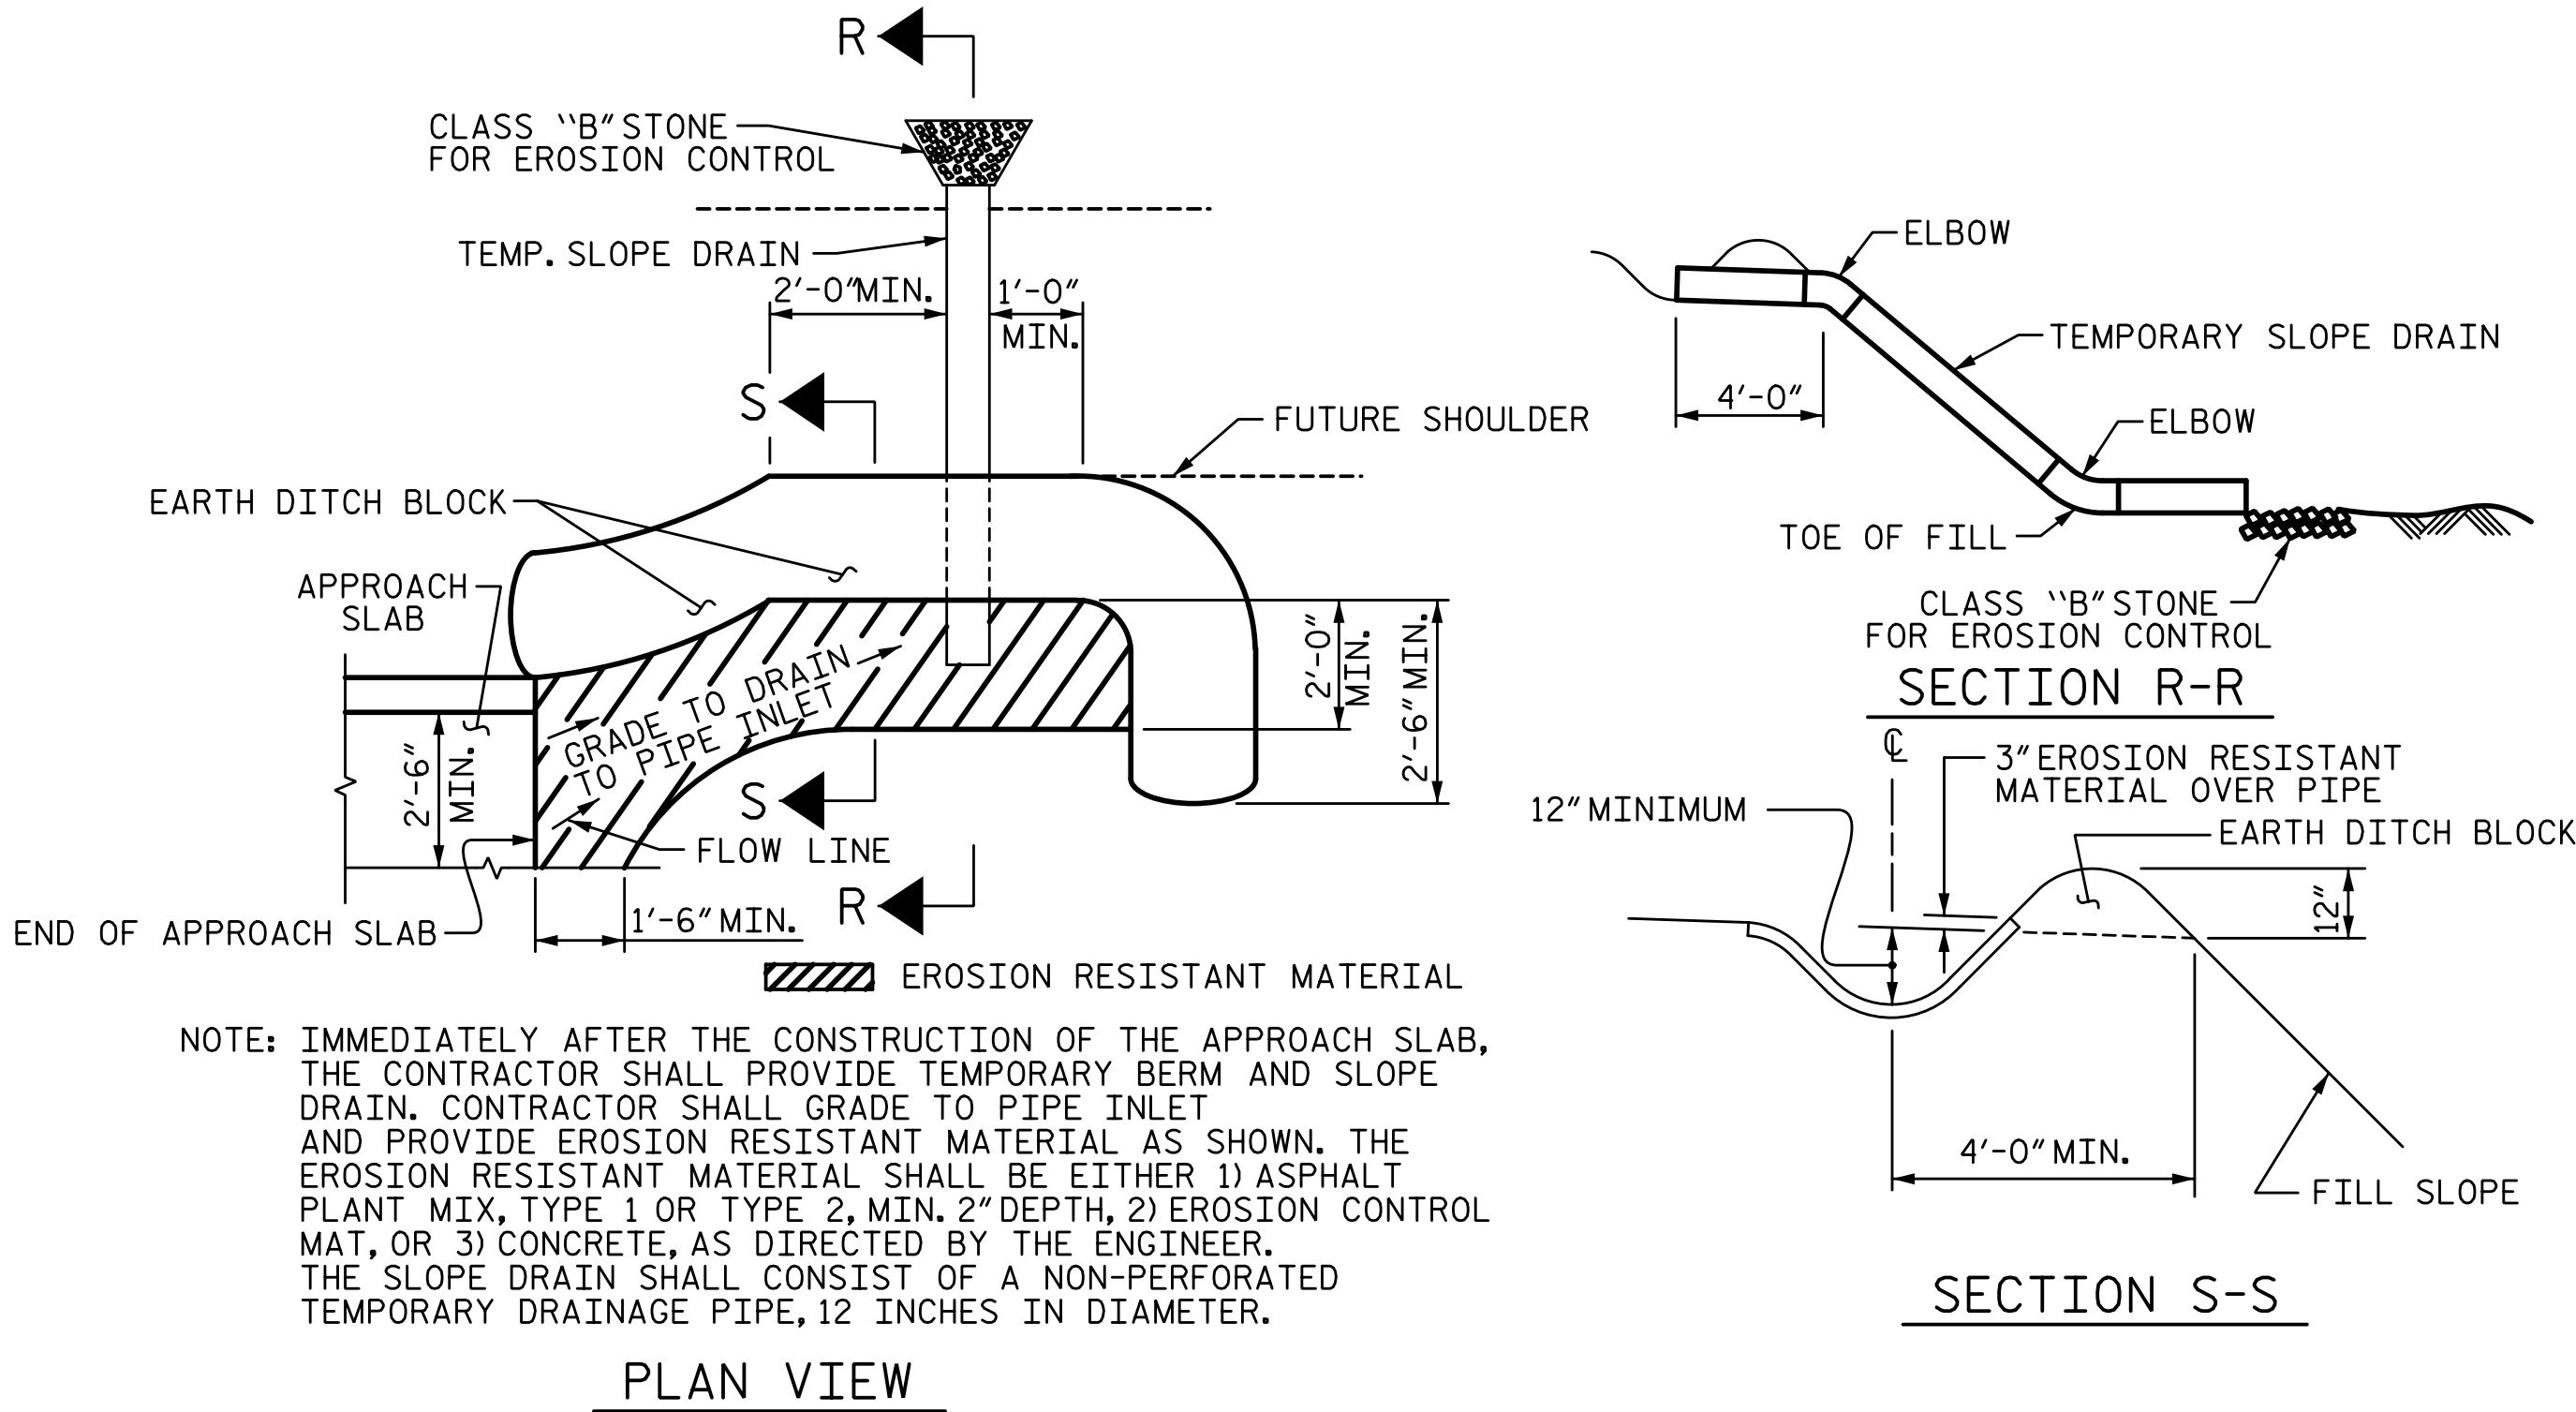

## TEMPORARY BERM AND SLOPE DRAIN DETAILS

(TO BE USED WHEN SHOULDER BERM GUTTER IS REQUIRED)

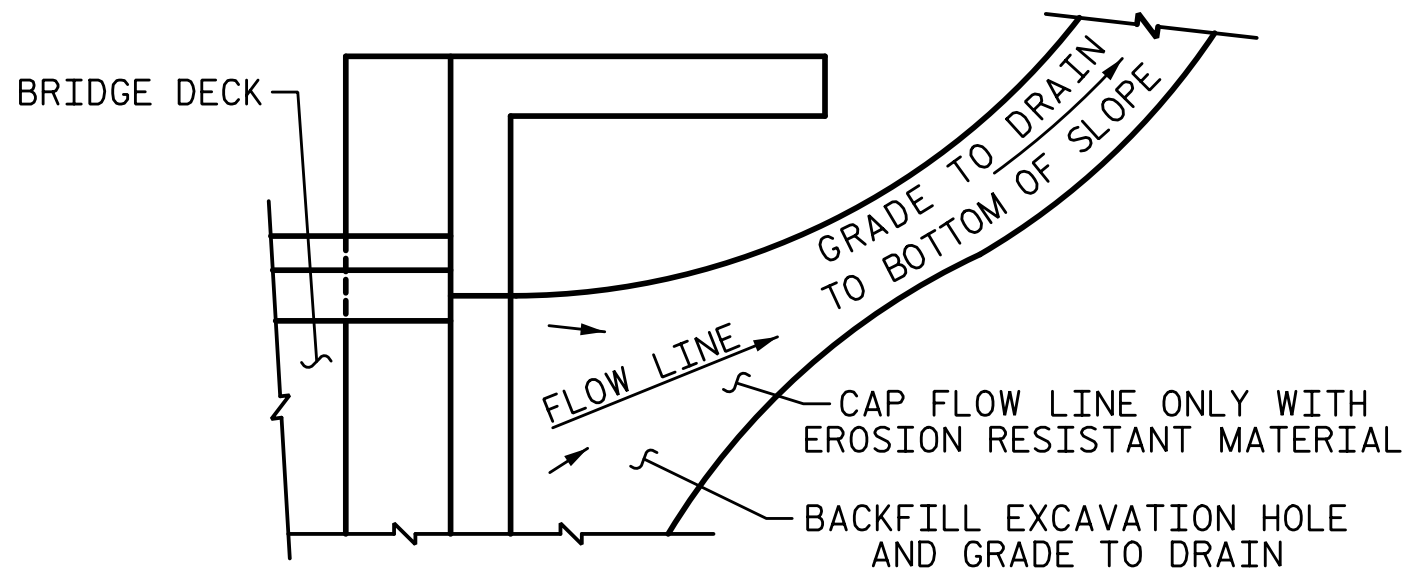

NOTE: IF THE APPROACH SLAB IS NOT CONSTRUCTED IMMEDIATELY AFTER THE BACKFILLING OF THE END BENT EXCAVATION, GRADE TO DRAIN TO THE BOTTOM OF THE SLOPE AND PROVIDE EROSION RESISTANT MATERIAL, SUCH AS FIBERGLASS ROVING OR AS DIRECTED BY THE ENGINEER TO PREVENT SOIL EROSION AND TO PROTECT THE AREA ADJACENT TO THE STRUCTURE. THE CONTRACTOR WILL BE REQUIRED TO REMOVE THESE MATERIALS PRIOR TO CONSTRUCTION OF THE APPROACH SLAB.

## TEMPORARY DRAINAGE DETAIL

PROJECT NO. 17BP.7.R.94  
ORANGE COUNTY  
STATION: 13+22.00 -L-

SHEET 2 OF 2

STATE OF NORTH CAROLINA  
DEPARTMENT OF TRANSPORTATION  
RALEIGH

## BRIDGE APPROACH SLAB DETAILS


### REVISIONS

NO.	BY:	DATE:	NO.	BY:	DATE:	SHEET NO.
1			3			S-14
2			4			TOTAL SHEETS 14

PLANS PREPARED BY:

**SE & A**  
SIMPSON ENGINEERS & ASSOCIATES  
5640 Dillard Drive  
Suite 200  
Cary, NC 27518  
(919) 852-0468  
(919) 852-0598 (Fax)  
www.simpsonengr.com

LICENSURE NO. C-2521

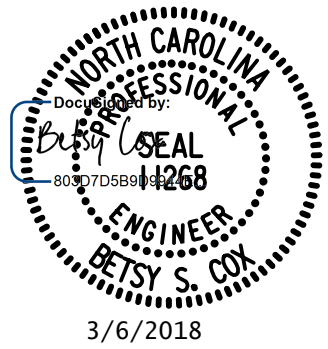

DOCUMENT NOT CONSIDERED FINAL  
UNLESS ALL SIGNATURES COMPLETED

3/6/2018 8:35:20 AM G:\Projects\2015\Division 7 (Hatch Mot+)\17BP7R94 (Orange 51) (120 24CS VR)\Structures\Drawings\Final (revised)\401\_17BP7R94\_SMJ\_SMJ.DGN

DESIGN DATA:

SPECIFICATIONS	- - - - -	A.A.S.H.T.O. (CURRENT)
LIVE LOAD	- - - - -	SEE PLANS
IMPACT ALLOWANCE	- - - - -	SEE A.A.S.H.T.O.
STRESS IN EXTREME FIBER OF		
STRUCTURAL STEEL - AASHTO M270 GRADE 36	-	20,000 LBS. PER SQ. IN.
- AASHTO M270 GRADE 50W	-	27,000 LBS. PER SQ. IN.
- AASHTO M270 GRADE 50	-	27,000 LBS. PER SQ. IN.
REINFORCING STEEL IN TENSION		
	GRADE 60 - -	24,000 LBS. PER SQ. IN.
CONCRETE IN COMPRESSION	- - - - -	1,200 LBS. PER SQ. IN.
CONCRETE IN SHEAR	- - - - -	SEE A.A.S.H.T.O.
STRUCTURAL TIMBER - TREATED OR		
UNTREATED - EXTREME FIBER STRESS	- - - - -	1,800 LBS. PER SQ. IN.
COMPRESSION PERPENDICULAR TO GRAIN OF TIMBER	- - - -	375 LBS. PER SQ. IN.
EQUIVALENT FLUID PRESSURE OF EARTH	- - - - -	30 LBS. PER CU. FT.
		(MINIMUM)

MATERIAL AND WORKMANSHIP:

EXCEPT AS MAY OTHERWISE BE SPECIFIED ON PLANS OR IN THE SPECIAL PROVISIONS, ALL MATERIAL AND WORKMANSHIP SHALL BE IN ACCORDANCE WITH THE 2018 "STANDARD SPECIFICATIONS FOR ROADS AND STRUCTURES" OF THE N. C. DEPARTMENT OF TRANSPORTATION.

STEEL SHEET PILING FOR PERMANENT OR TEMPORARY APPLICATIONS SHALL BE HOT ROLLED.

CONCRETE:

UNLESS OTHERWISE REQUIRED ON PLANS, CLASS A CONCRETE SHALL BE USED FOR ALL PORTIONS OF ALL STRUCTURES WITH THE EXCEPTION THAT: CLASS AA CONCRETE SHALL BE USED IN BRIDGE SUPERSTRUCTURES, ABUTMENT BACKWALLS, AND APPROACH SLABS; AND CLASS B CONCRETE SHALL BE USED FOR SLOPE PROTECTION AND RIP RAP.

CONCRETE CHAMFERS:

UNLESS OTHERWISE NOTED ON THE PLANS, ALL EXPOSED CORNERS ON STRUCTURES SHALL BE CHAMFERED 3/4" WITH THE FOLLOWING EXCEPTIONS: TOP CORNERS OF CURBS MAY BE ROUNDED TO 1-1/2" RADIUS WHICH IS BUILT INTO CURB FORMS; CORNERS OF TRANSVERSE FLOOR EXPANSION JOINTS SHALL BE ROUNDED WITH A 1/4" FINISHING TOOL UNLESS OTHERWISE REQUIRED ON PLANS; AND CORNERS OF EXPANSION JOINTS IN THE ROADWAY FACES AND TOPS OF CURBS AND SIDEWALKS SHALL BE ROUNDED TO A 1/4" RADIUS WITH A FINISHING STONE OR TOOL UNLESS OTHERWISE REQUIRED ON PLANS.

DOWELS:

DOWELS WHEN INDICATED ON PLANS AS FOR CULVERT EXTENSIONS, SHALL BE EMBEDDED AT LEAST 12" INTO THE OLD CONCRETE AND GROUTED INTO PLACE WITH 1:2 CEMENT MORTAR.

STANDARD NOTES

ALLOWANCE FOR DEAD LOAD DEFLECTION, SETTLEMENT:  
ETC. IN CASTING SUPERSTRUCTURES:

BRIDGES SHALL BE BUILT ON THE GRADE OR VERTICAL CURVE SHOWN ON PLANS. SLABS, CURBS AND PARAPETS SHALL CONFORM TO THE GRADE OR CURVE.  
ALL DIMENSIONS WHICH ARE GIVEN IN SECTION AND ARE AFFECTED BY DEAD LOAD DEFLECTIONS ARE DIMENSIONS AT CENTER LINE OF BEARING UNLESS OTHERWISE NOTED ON PLANS. IN SETTING FORMS FOR STEEL BEAM BRIDGES AND PRESTRESSED CONCRETE GIRDER BRIDGES, ADJUSTMENTS SHALL BE MADE DUE TO THE DEAD LOAD DEFLECTIONS FOR THE ELEVATIONS SHOWN. WHERE BLOCKS ARE SHOWN OVER BEAMS FOR BUILDING UP TO THE SLAB, THE VERTICAL DIMENSIONS OF THE BLOCKS SHALL BE ADJUSTED BETWEEN BEARINGS TO COMPENSATE FOR DEAD LOAD DEFLECTIONS, VERTICAL CURVE ORDINATE, AND ACTUAL BEAM CAMBER. WHERE BOTTOM OF SLAB IS IN LINE WITH BOTTOM OF TOP FLANGES, DEPTH OF SLAB BETWEEN BEARINGS SHALL BE ADJUSTED TO COMPENSATE FOR DEAD LOAD DEFLECTION, VERTICAL CURVE ORDINATE, AND ACTUAL BEAM CAMBER.  
IN SETTING FALSEWORK AND FORMS FOR REINFORCED CONCRETE SPANS, AN ALLOWANCE SHALL BE MADE FOR DEAD LOAD DEFLECTIONS, SETTLEMENT OF FALSEWORK, AND PERMANENT CAMBER WHICH SHALL BE PROVIDED FOR IN ADDITION TO THE ELEVATIONS SHOWN. AFTER REMOVAL OF THE FALSEWORK, THE FINISHED STRUCTURES SHALL CONFORM TO THE PROFILE AND ELEVATIONS SHOWN ON THE PLANS AND CONSTRUCTION ELEVATIONS FURNISHED BY THE ENGINEER.  
DETAILED DRAWINGS FOR FALSEWORK OR FORMS FOR BRIDGE SUPERSTRUCTURE AND ANY STRUCTURE OR PARTS OF A STRUCTURE AS NOTED ON THE PLANS SHALL BE SUBMITTED TO THE ENGINEER FOR APPROVAL BEFORE CONSTRUCTION OF THE FALSEWORK OR FORMS IS STARTED.

REINFORCING STEEL:

ALL REINFORCING STEEL SHALL BE DEFORMED. DIMENSIONS RELATIVE TO PLACEMENT OF REINFORCING ARE TO CENTERS OF BARS UNLESS OTHERWISE INDICATED IN THE PLANS. DIMENSIONS ON BAR DETAILS ARE TO CENTERS OF BARS OR ARE OUT TO OUT AS INDICATED ON PLANS.  
WIRE BAR SUPPORTS SHALL BE PROVIDED FOR REINFORCING STEEL WHERE INDICATED ON THE PLANS. WHEN BAR SUPPORT PIECES ARE PLACED IN CONTINUOUS LINES, THEY SHALL BE SO PLACED THAT THE ENDS OF THE SUPPORTING WIRES SHALL BE LAPPED TO LOCK LEGS ON ADJOINING PIECES.

STRUCTURAL STEEL:

AT THE CONTRACTOR'S OPTION, HE MAY SUBSTITUTE 7/8" Ø SHEAR STUDS FOR THE 3/4" Ø STUDS SPECIFIED ON THE PLANS. THIS SUBSTITUTION SHALL BE MADE AT THE RATE OF 3 - 7/8" Ø STUDS FOR 4 - 3/4" Ø STUDS, AND STUD SPACING CHANGES SHALL BE MADE AS NECESSARY TO PROVIDE THE SAME EQUIVALENT NUMBER OF 7/8" Ø STUDS ALONG THE BEAM AS SHOWN FOR 3/4" Ø STUDS BASED ON THE RATIO OF 3 - 7/8" Ø STUDS FOR 4 - 3/4" Ø STUDS. STUDS OF THE LENGTH SPECIFIED ON THE PLANS MUST BE PROVIDED. THE MAXIMUM SPACING SHALL BE 2'-0".  
EXCEPT AT THE INTERIOR SUPPORTS OF CONTINUOUS BEAMS WHERE THE COVER PLATE IS IN CONTACT WITH BEARING PLATE, THE CONTRACTOR MAY, AT HIS OPTION, SUBSTITUTE FOR THE COVER PLATES DESIGNATED ON THE PLANS COVER PLATES OF THE EQUIVALENT AREA PROVIDED THESE PLATES ARE AT LEAST 5/16" IN THICKNESS AND DO NOT EXCEED A WIDTH EQUAL TO THE FLANGE WIDTH LESS 2" OR A THICKNESS EQUAL TO 2 TIMES THE FLANGE THICKNESS. THE SIZE OF FILLET WELDS SHALL CONFORM TO THE REQUIREMENTS OF THE CURRENT ANSI/AASHTO/AWS "BRIDGE WELDING CODE". ELECTROSLAG WELDING WILL NOT BE PERMITTED.  
WITH THE SOLE EXCEPTION OF EDGES AT SURFACES WHICH BEAR ON OTHER SURFACES, ALL SHARP EDGES AND ENDS OF SHAPES AND PLATES SHALL BE SLIGHTLY ROUNDED BY SUITABLE MEANS TO A RADIUS OF APPROXIMATELY 1/16 INCH OR EQUIVALENT FLAT SURFACE AT A SUITABLE ANGLE PRIOR TO PAINTING, GALVANIZING, OR METALLIZING.

HANDRAILS AND POSTS:

METAL STANDARDS AND FACES OF THE CONCRETE END POSTS FOR THE METAL RAIL SHALL BE SET NORMAL TO THE GRADE OF THE CURB, UNLESS OTHERWISE SHOWN ON PLANS. THE METAL RAIL AND TOPS OF CONCRETE POSTS USED WITH THE ALUMINUM RAIL SHALL BE BUILT PARALLEL TO THE GRADE OF THE CURB.  
METAL HANDRAILS SHALL BE IN ACCORDANCE WITH THE PLANS. RAILS SHALL BE AS MANUFACTURED FOR BRIDGE RAILING. CASTINGS SHALL BE OF A UNIFORM APPEARANCE. FINIS AND OTHER DEFORMATIONS RESULTING FROM CASTING OR OTHERWISE SHALL BE REMOVED IN A MANNER SO THAT A UNIFORM COLORING OF THE COMPLETED CASTING SHALL BE OBTAINED. CASTINGS WITH DISCOLORATIONS OR OF NON-UNIFORM COLORING WILL NOT BE ACCEPTED. CERTIFIED MILL REPORTS ARE REQUIRED FOR METAL RAILS AND POSTS.

SPECIAL NOTES:

GENERALLY, IN CASE OF DISCREPANCY, THIS STANDARD SHEET OF NOTES SHALL GOVERN OVER THE SPECIFICATIONS, BUT THE REMAINDER OF THE PLANS SHALL GOVERN OVER NOTES HEREON, AND SPECIAL PROVISIONS SHALL GOVERN OVER ALL. SEE SPECIFICATIONS ARTICLE 105-4.